
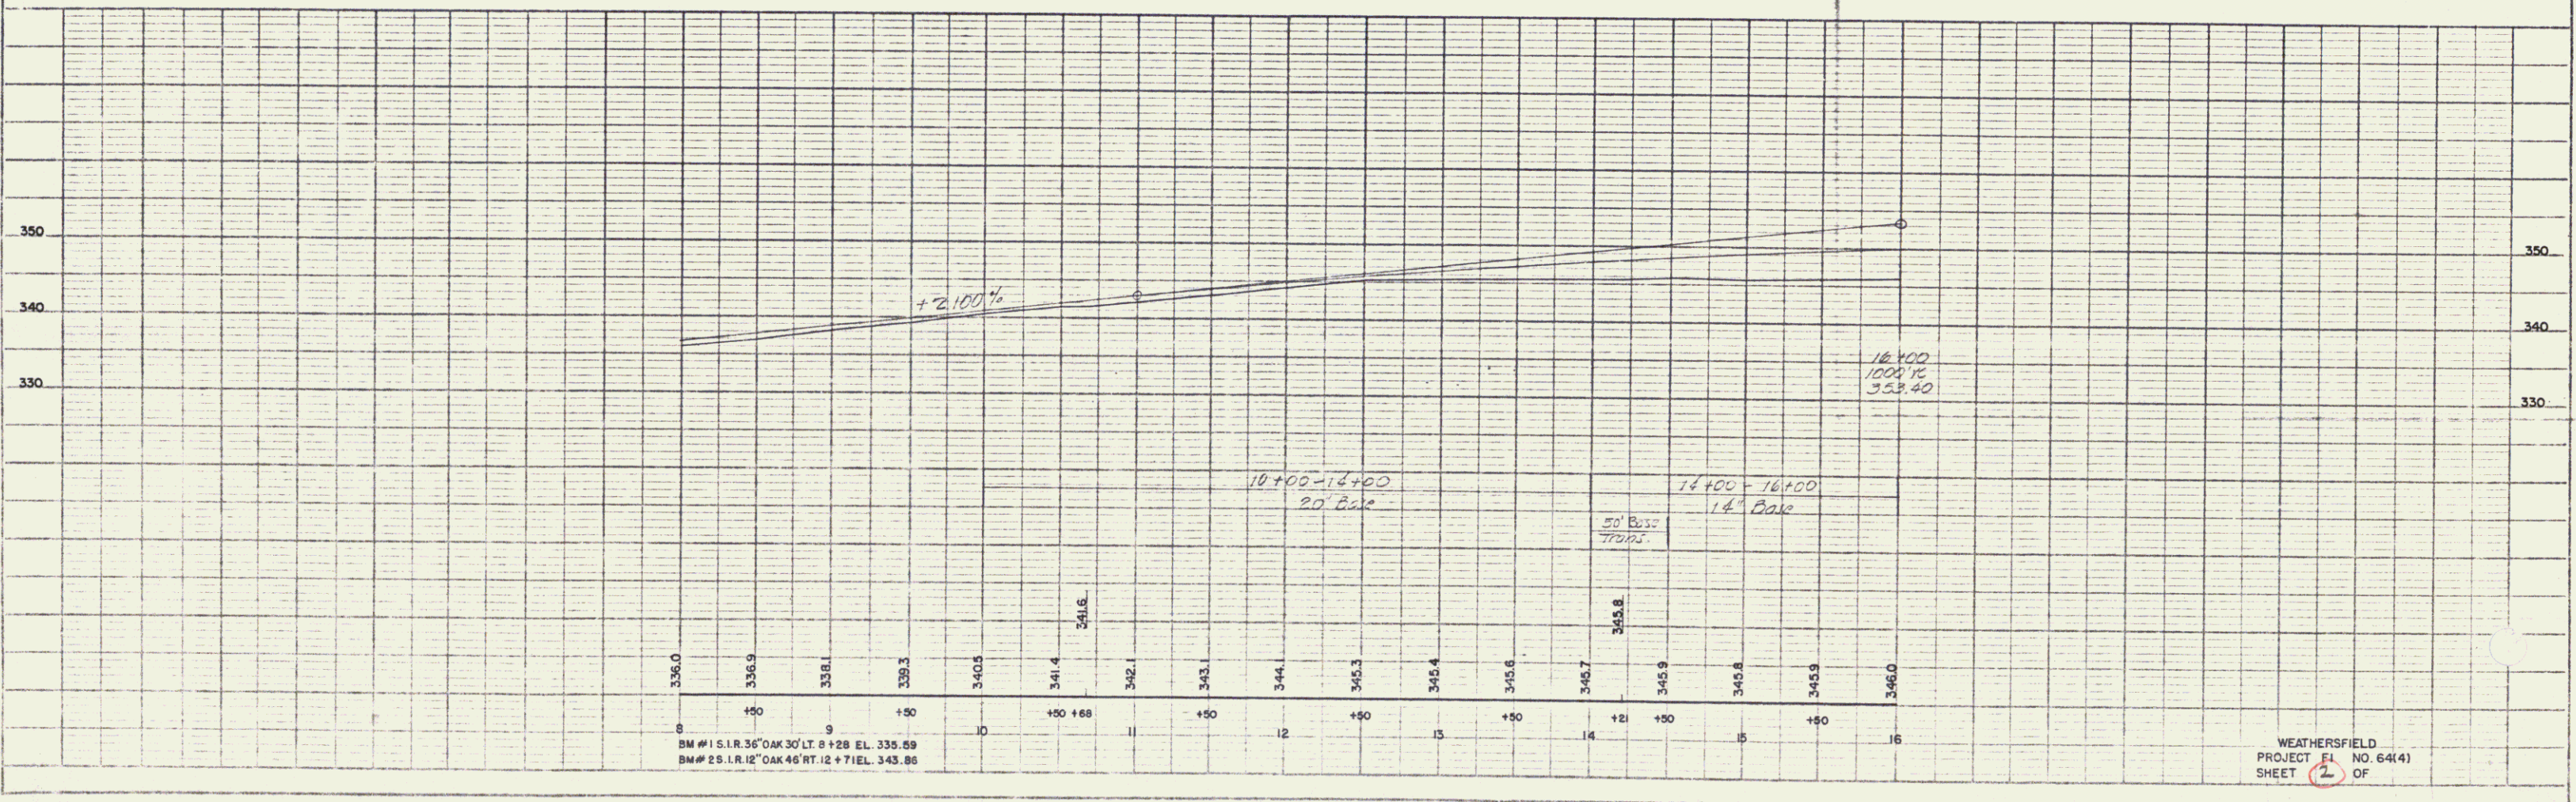


DATE: 3/74
 PLAN: 27
 WIRE SIZE: 1/4"
 SCALE: 1" = 40'

DATE: 3/74
 PROFILE: 27
 WIRE SIZE: 1/4"
 SCALE: 1" = 40'

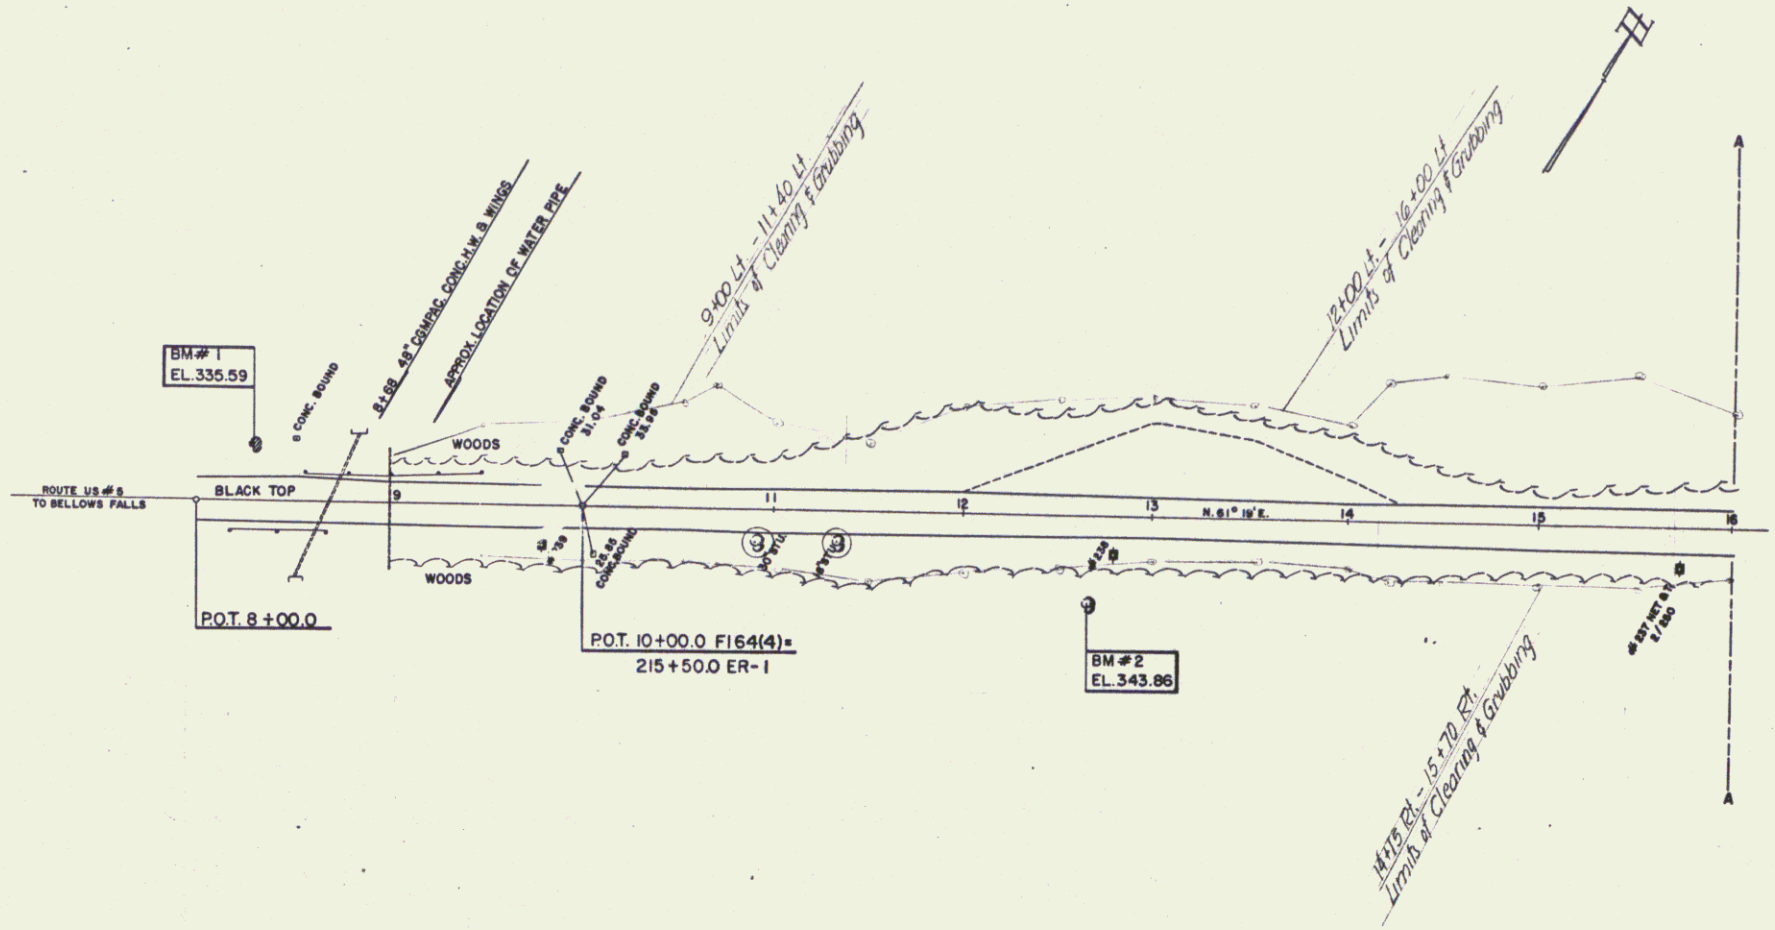

WEATHERSFIELD
 PROJECT E1 NO. 64(4)
 SHEET 2 OF