
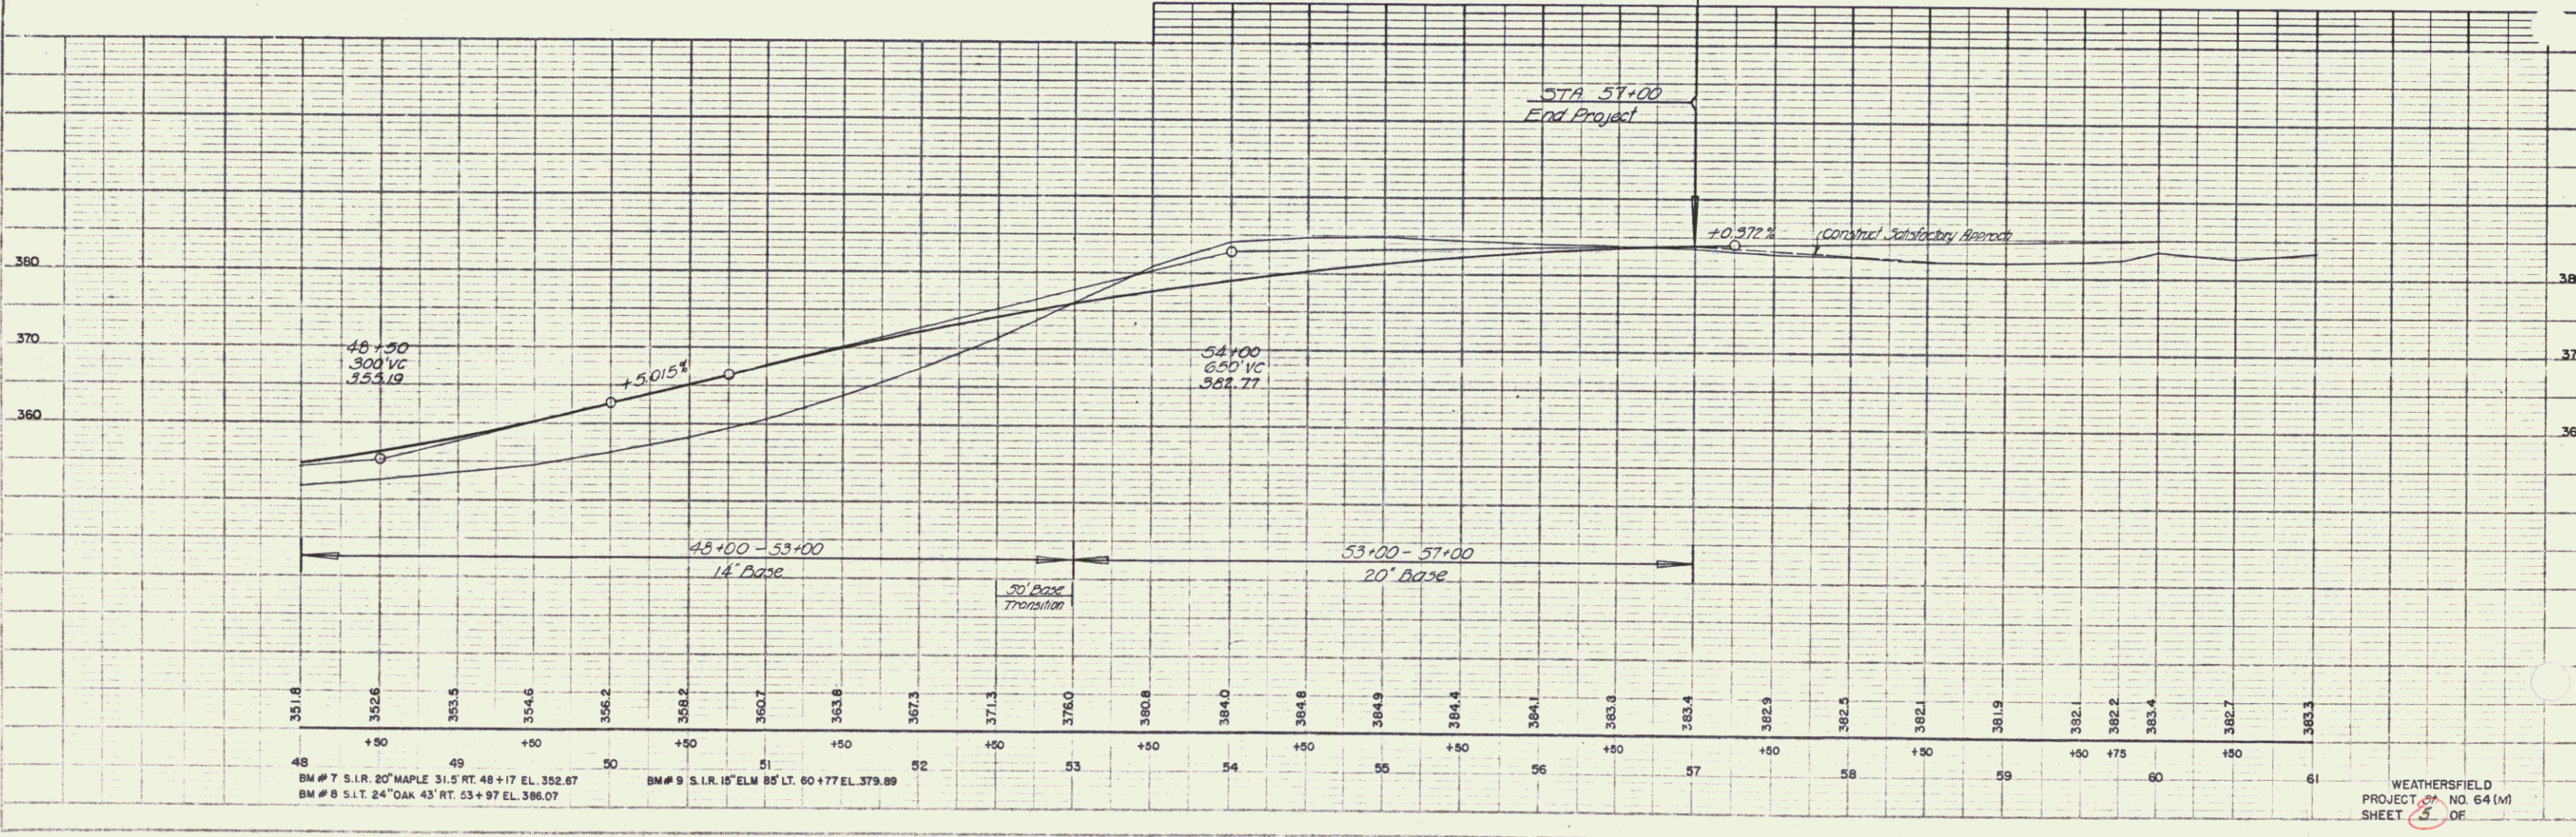


DATE	1/24/84
SCALE	1" = 40'
PROJECT	WEATHERFIELD
NO.	64
SHEET	3

DATE	1/24/84
SCALE	1" = 40'
PROJECT	WEATHERFIELD
NO.	64
SHEET	3

Rev. Curve
 Δ 3° 41' Lt
 D 1°
 R 5729.7
 T 435.3
 L 968.3
 E 20.5
 bank 1/2 per ft

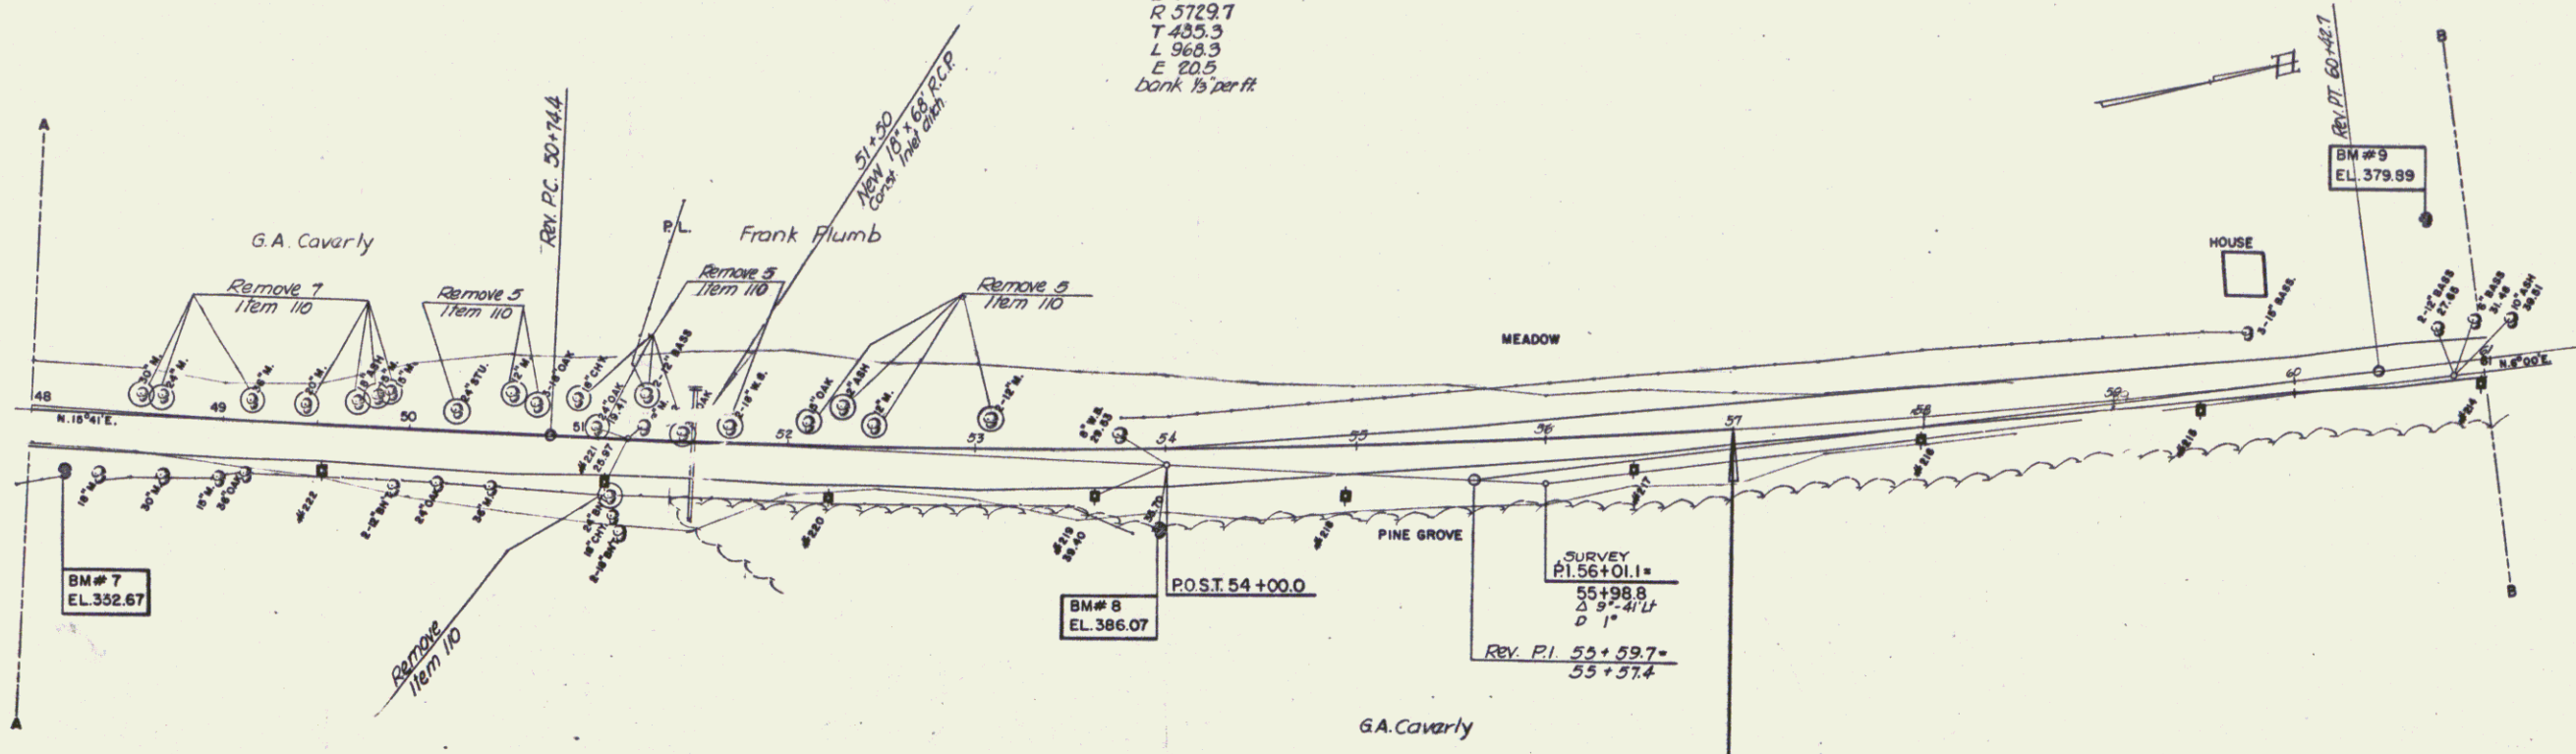

BM # 7 S.I.R. 20" MAPLE 31.5' RT. 48+17 EL. 352.67
 BM # 8 S.I.T. 24" OAK 43' RT. 53+97 EL. 386.07
 BM # 9 S.I.R. 18" ELM 85' LT. 60+77 EL. 379.99

WEATHERFIELD
 PROJECT NO. 64 (M)
 SHEET 3 OF 3

5