
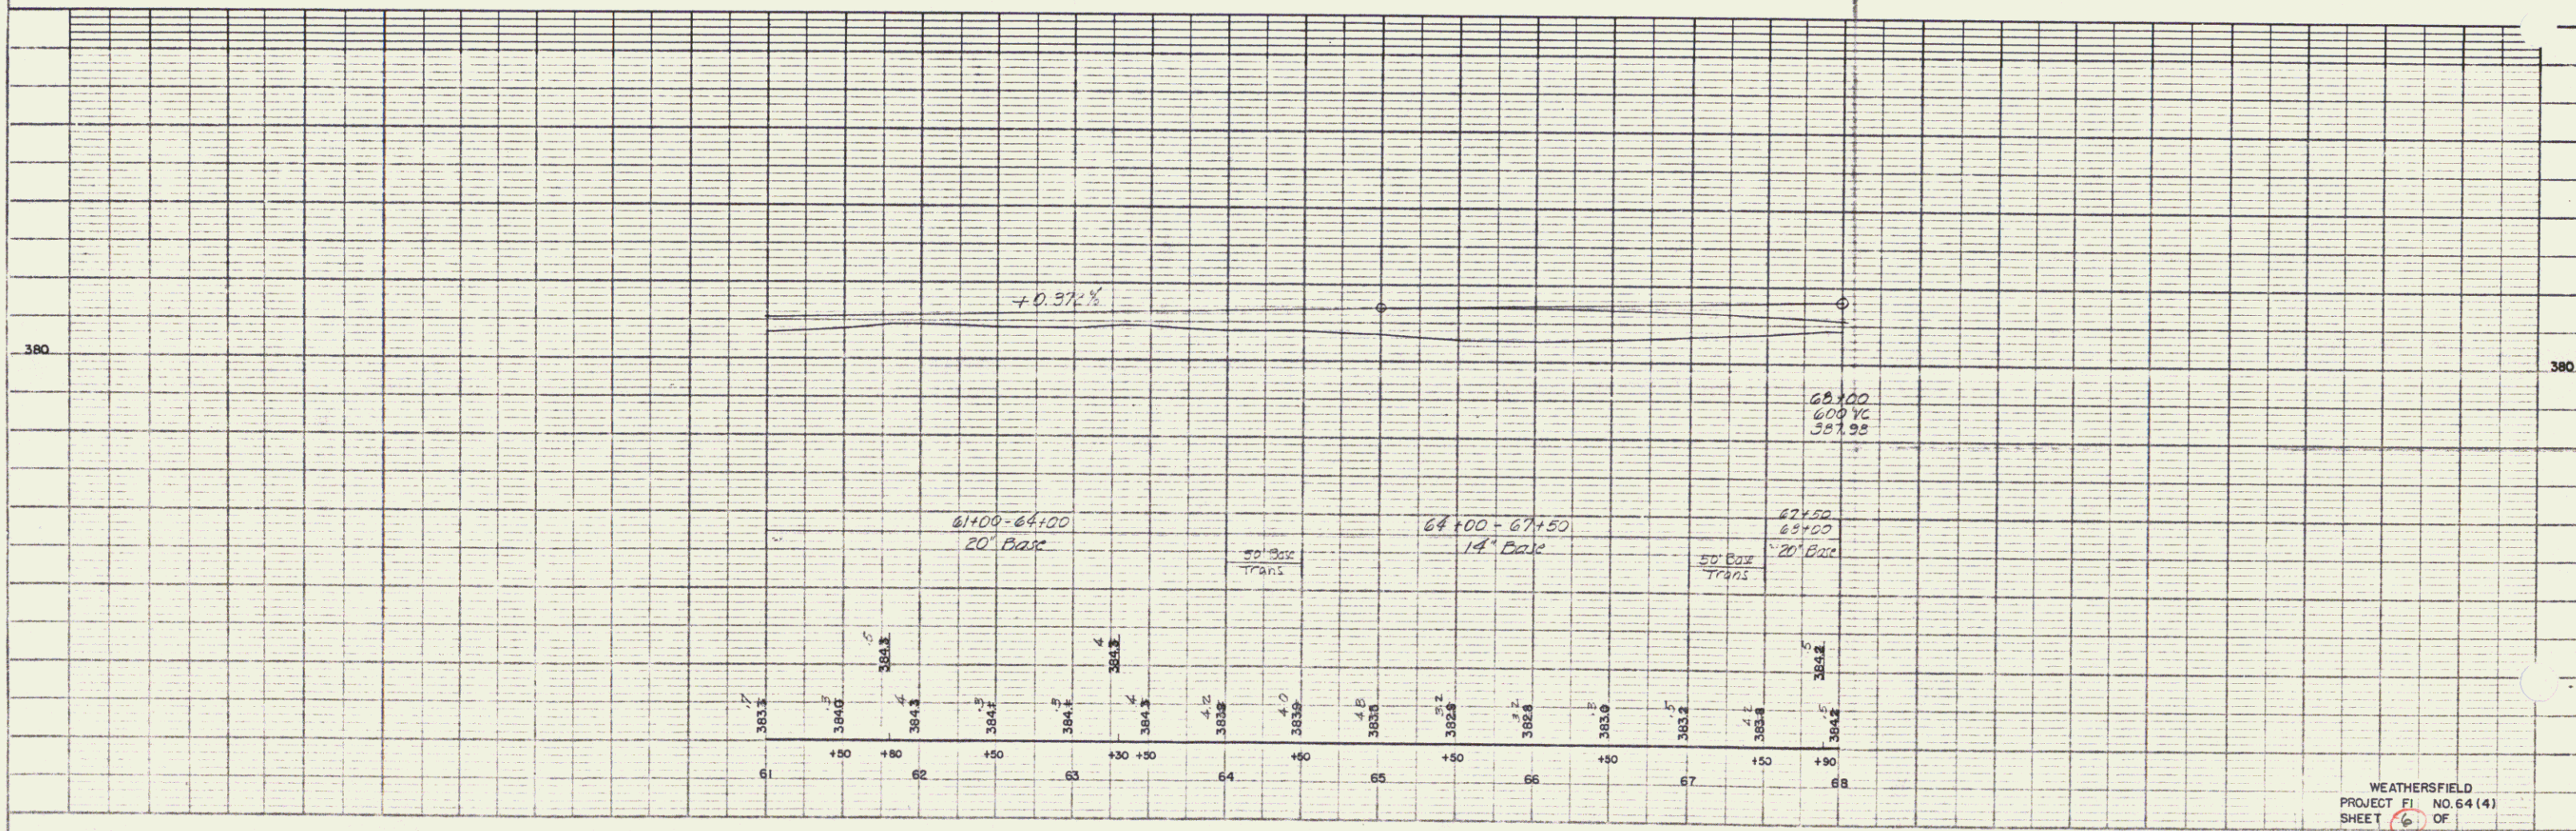


PLAN	DATE	BY	CHK.
DATE	BY	CHK.	
DATE	BY	CHK.	
DATE	BY	CHK.	

PROFILE	DATE	BY	CHK.
DATE	BY	CHK.	
DATE	BY	CHK.	
DATE	BY	CHK.	

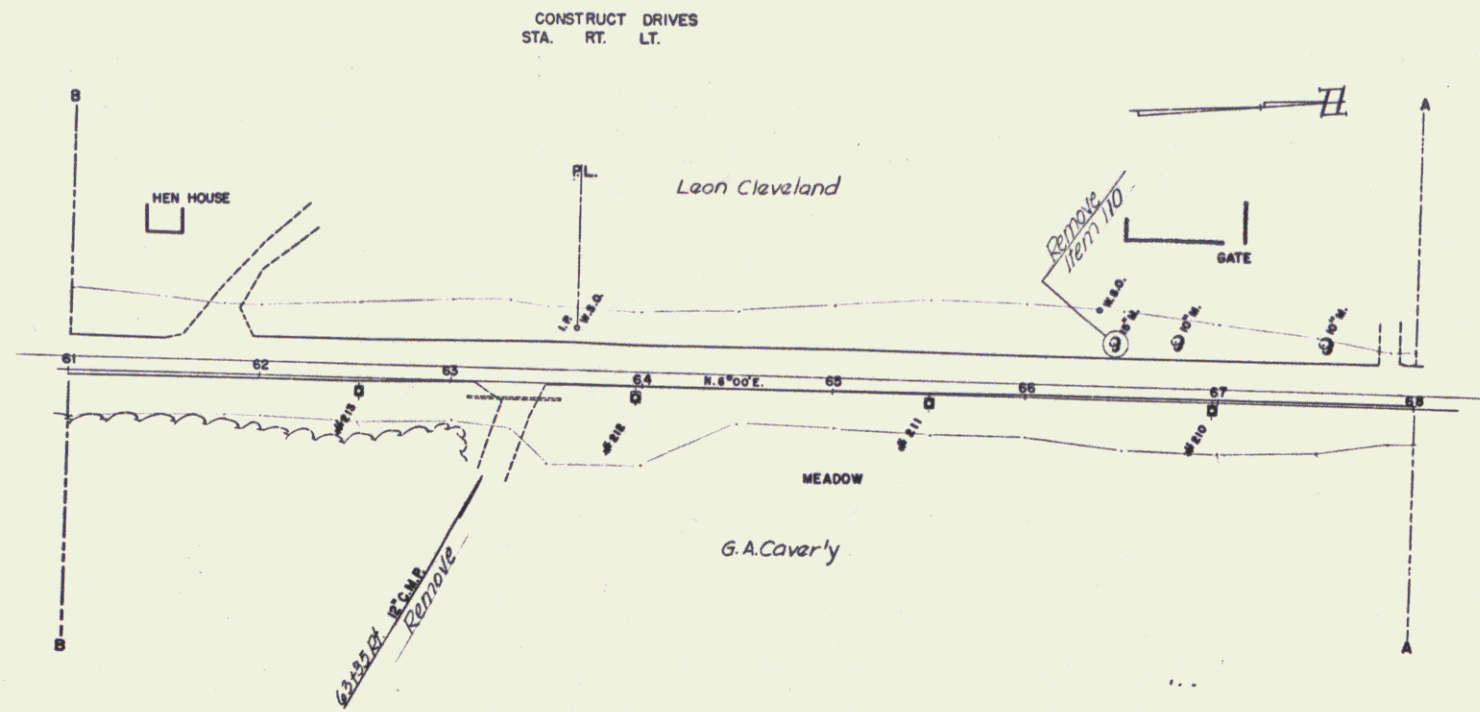

WEATHERSFIELD
PROJECT NO. 64 (4)
SHEET 6 OF 6