


PLAN	DATE
REVISED	
WHITE MARK	
BY	

PROF. NO.	DATE
1744	3/7/66
NO.	

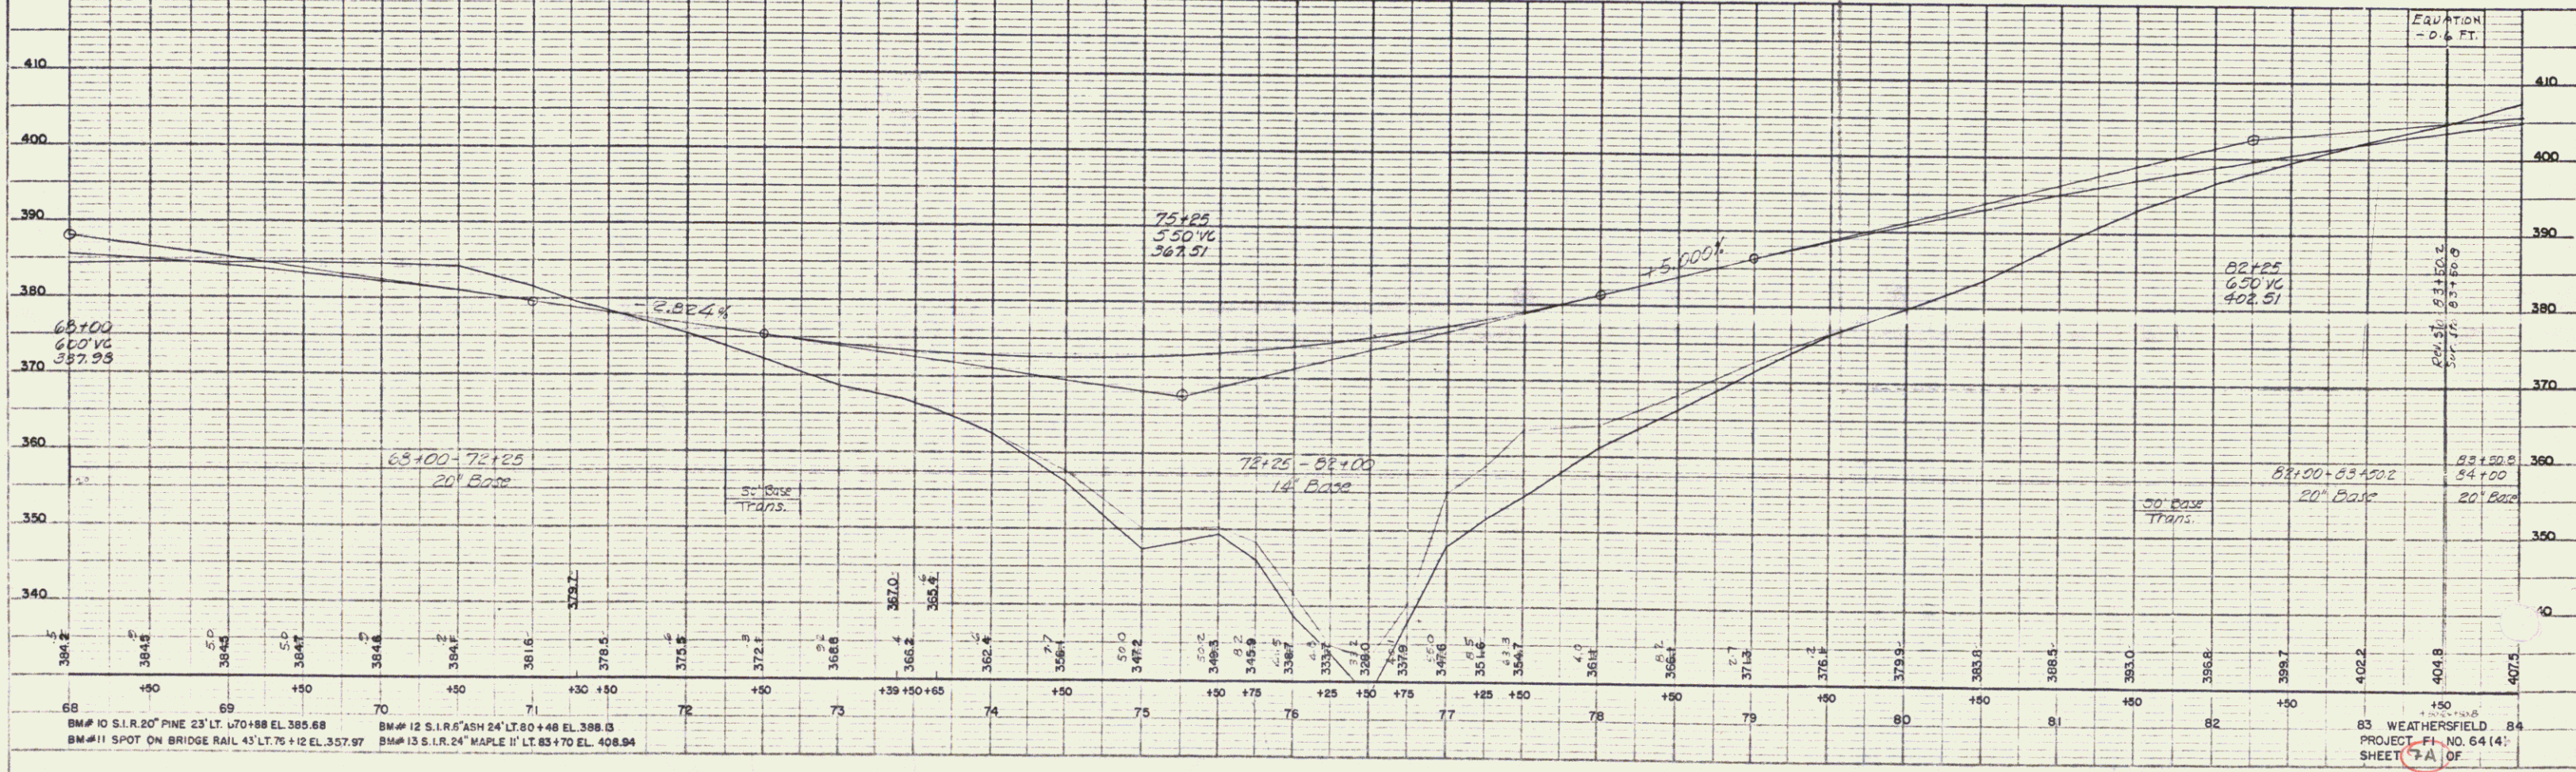

BM# 10 S.I.R. 20' PINE 23' LT. L70+188 EL. 385.68  
 BM# 11 SPOT ON BRIDGE RAIL 43' LT. 75+12 EL. 357.97  
 BM# 12 S.I.R. 24' ASH 24' LT. 80+48 EL. 388.13  
 BM# 13 S.I.R. 24' MAPLE 11' LT. 83+70 EL. 408.94

83 WEATHERSFIELD 84  
 PROJECT - FI. NO. 64(4)  
 SHEET 7A OF

PLATE I-PLAN PROFILE - P. R. STANDARD  
 ENGINEERING CO., Chicago, Ill. U.S.A.