

PLAN	DATE	BY
DATE	BY	BY
DATE	BY	BY
DATE	BY	BY

PROFILE	DATE	BY
DATE	BY	BY
DATE	BY	BY
DATE	BY	BY

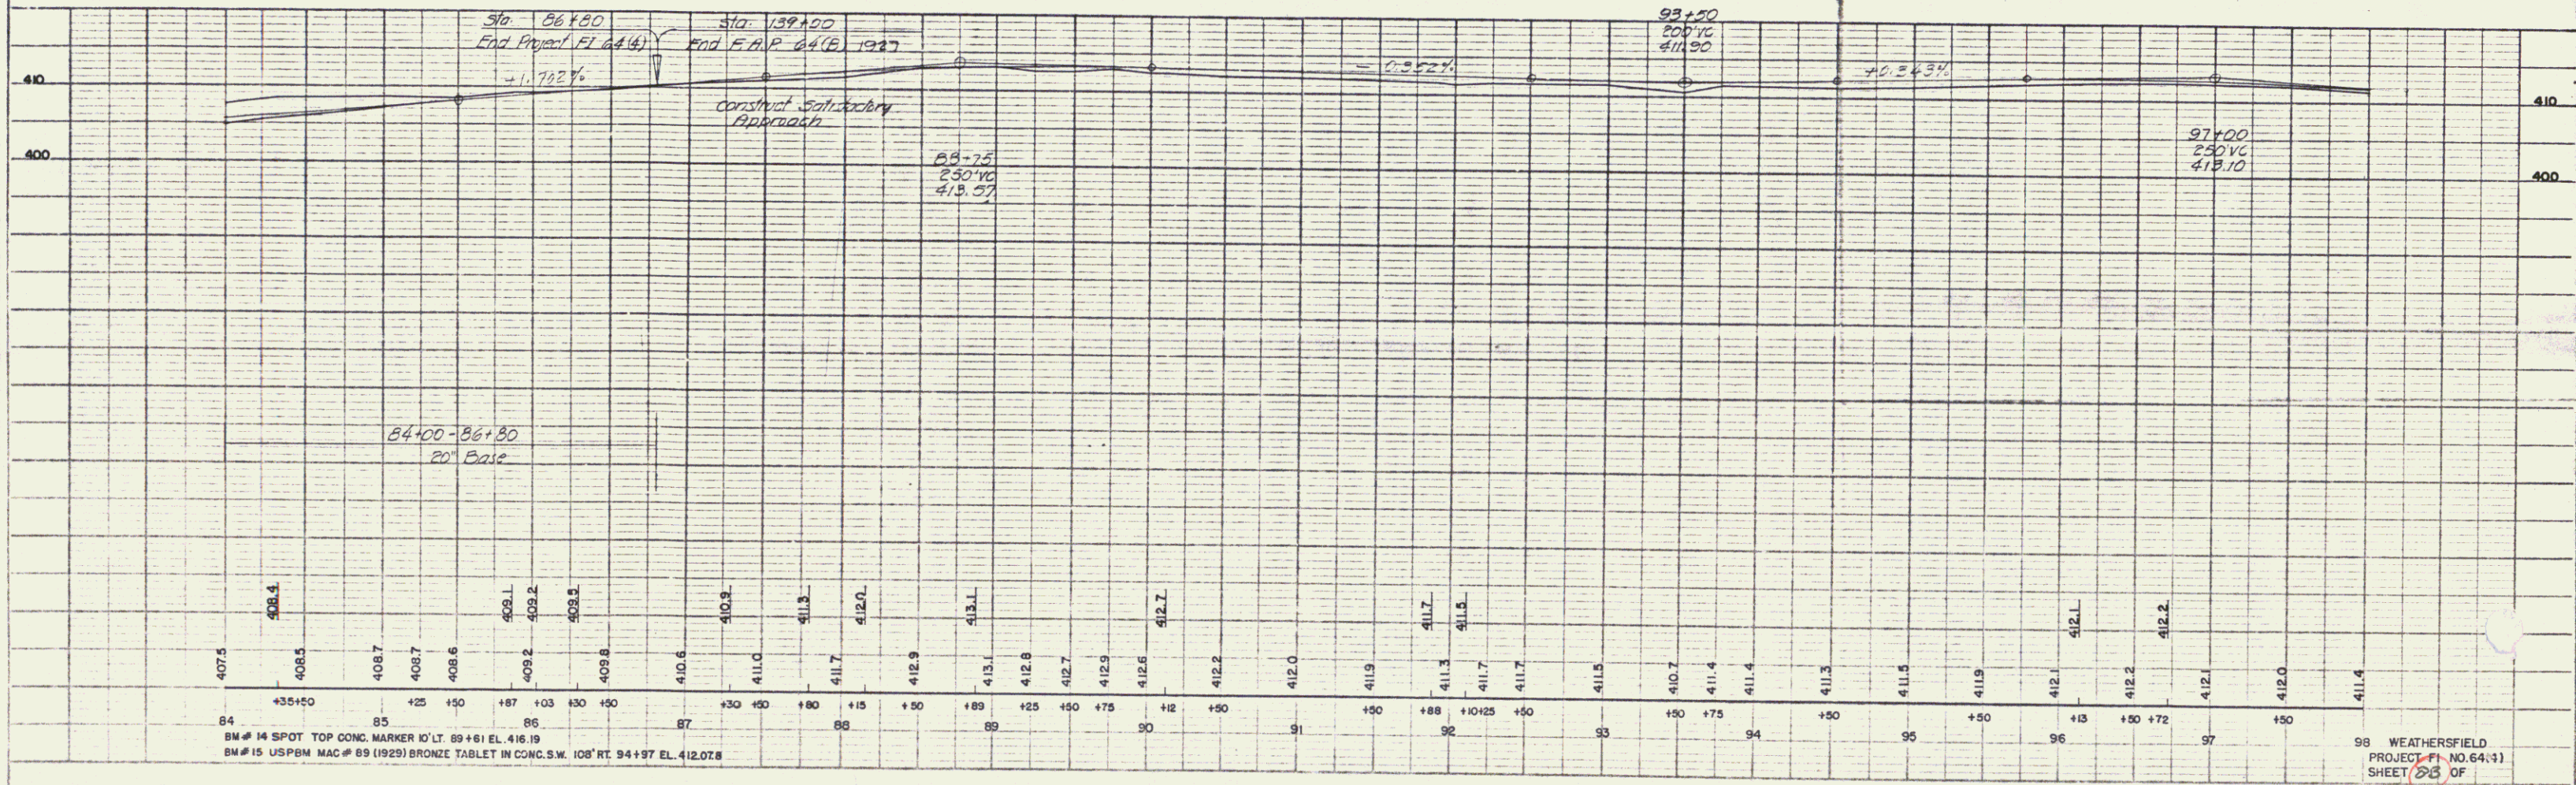


PLATE 1-PLAN-PROFILE N.P.M. STANDARD

98 WEATHERFIELD PROJECT NO. 64.11 SHEET 23 OF 23