

INDEX OF SHEETS

SHEET NO.	TITLE PAGE
4	TYPICAL CROSS-SECTION OF IMPROVEMENT WITH RAMP
5	PLAN AND PROFILE STA. 64+00 - STA. 70+00
6	STA. 70+00 - STA. 81+00
7	STA. 81+00 - STA. 91+00
8	STA. 91+00 - STA. 103+00
9	STA. 103+00 - STA. 110+00
10	STA. 110+00 - STA. 125+00
11	STA. 125+00 - STA. 130+00

11-32 Cross Sections


DATE	BY	REVISION	NO.
5	W. J. G. R.		1

STATE OF VERMONT  
STATE HIGHWAY DEPARTMENT


PLAN AND PROFILE OF PROPOSED  
STATE HIGHWAY  
FEDERAL AID PROJECT

**TOWN OF WEATHERSFIELD**  
CONNECTICUT RIVER ROAD  
BEGINNING AT WINDSOR-WEATHERSFIELD  
TOWN LINE AND EXTENDING SOUTHERLY  
MILES TO ASCUTNEYVILLE

Route: US5  
Project: F64B  
Pin# 99R338

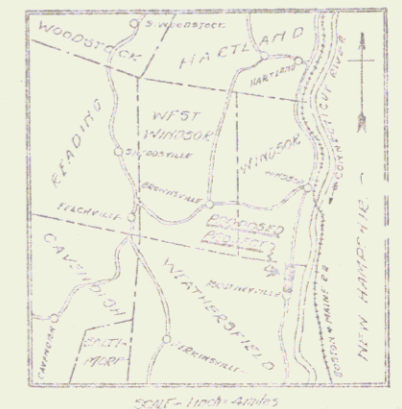

(To Be Returned to H.O.W. Division)  
TOWN OF  
US5  
PERPETUAL  
COMMON FILE  
EIGHT-OF-WAY DIVISION

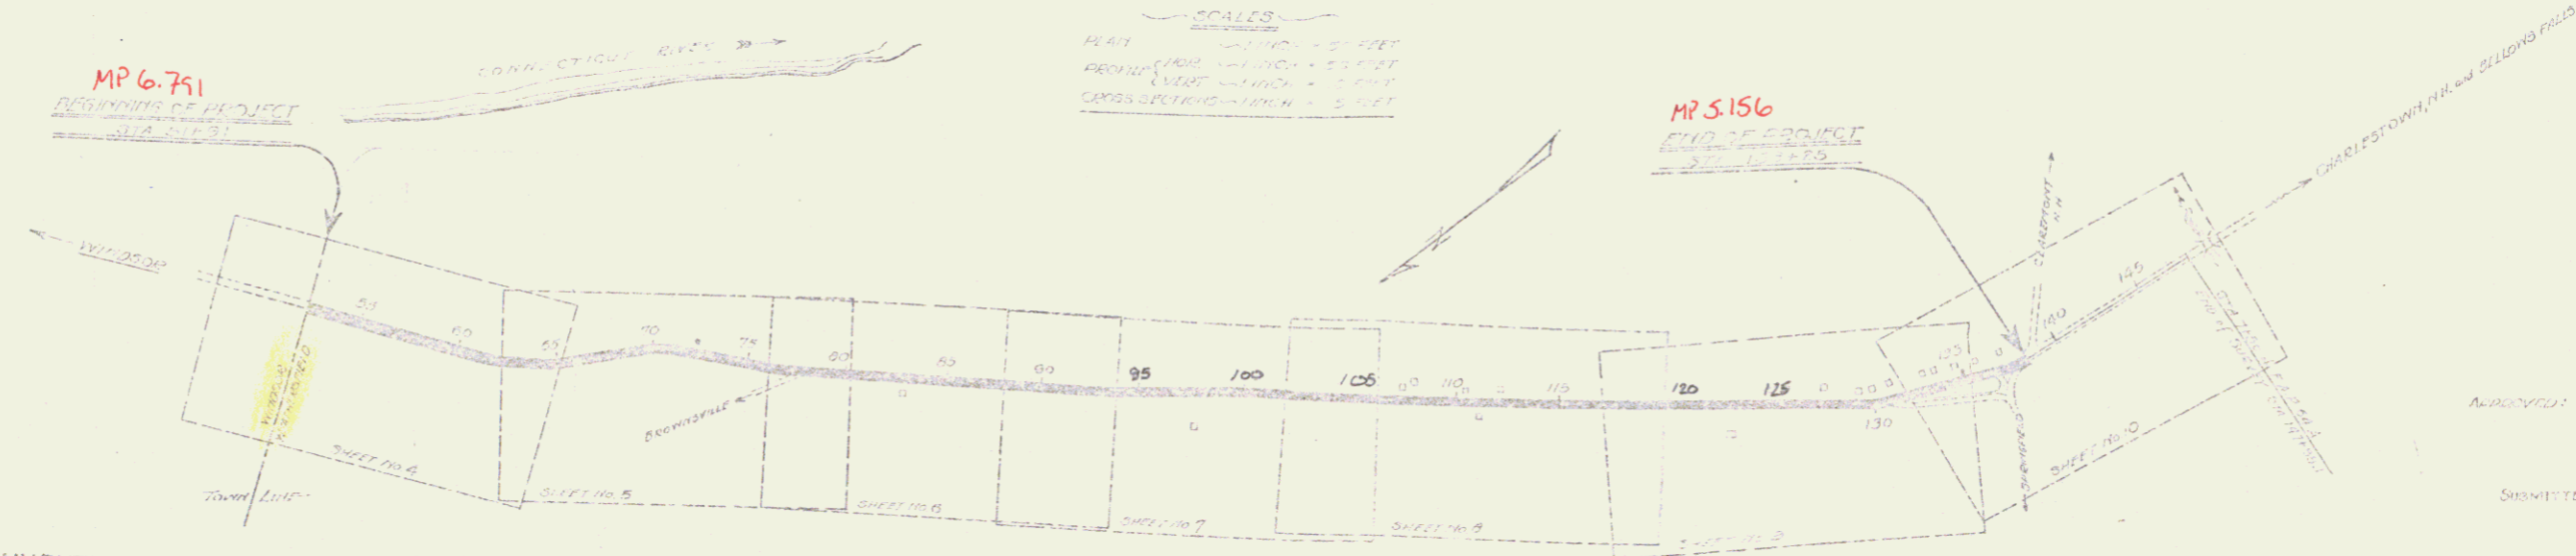

SCALES  
PLAN 1" = 100' - 1" = 100' FEET  
PROFILE 1" = 10' - 1" = 10' FEET  
VERTICAL CURVE 1" = 10' - 1" = 10' FEET  
CROSS SECTION 1" = 10' - 1" = 10' FEET

CONVENTIONAL SIGNS

Symbol	Description
---	COUNTY LINE
---	TOWN LINE
---	FENCE LINE
---	STONE WALL
---	UNFENCED PROPERTY
---	QUARRY WALL
---	TRAVELLED WAY
---	RAILROAD
---	RETAINING WALL
---	CENTER LINE
---	SURVEY LINE
---	CULVERT
---	TRUCK INLET
---	TRUCKY POLE
---	POWER POLE
---	TELEPHONE POLE
---	TRUCK
---	TRUCK

RECORD PLANS

THESE PLANS SUBJECT TO SUCH REVISIONS AS MAY BE REQUIRED BY THE BUREAU OF PUBLIC ROADS OR THE CHIEF ENGINEER.

APPROVED: April 14, 1927  
W. J. G. R.  
Submitted by order of the State Highway Board  
April 12, 1927  
S. B. P. R.  
COMMISSIONER H. O. W. DIVISION

RECOMMENDED BY THE BUREAU OF PUBLIC ROADS  
RECOMMENDED BY THE BUREAU OF PUBLIC ROADS  
APPROVED BY THE CHIEF ENGINEER

DIST. # 4 PLANS 1