
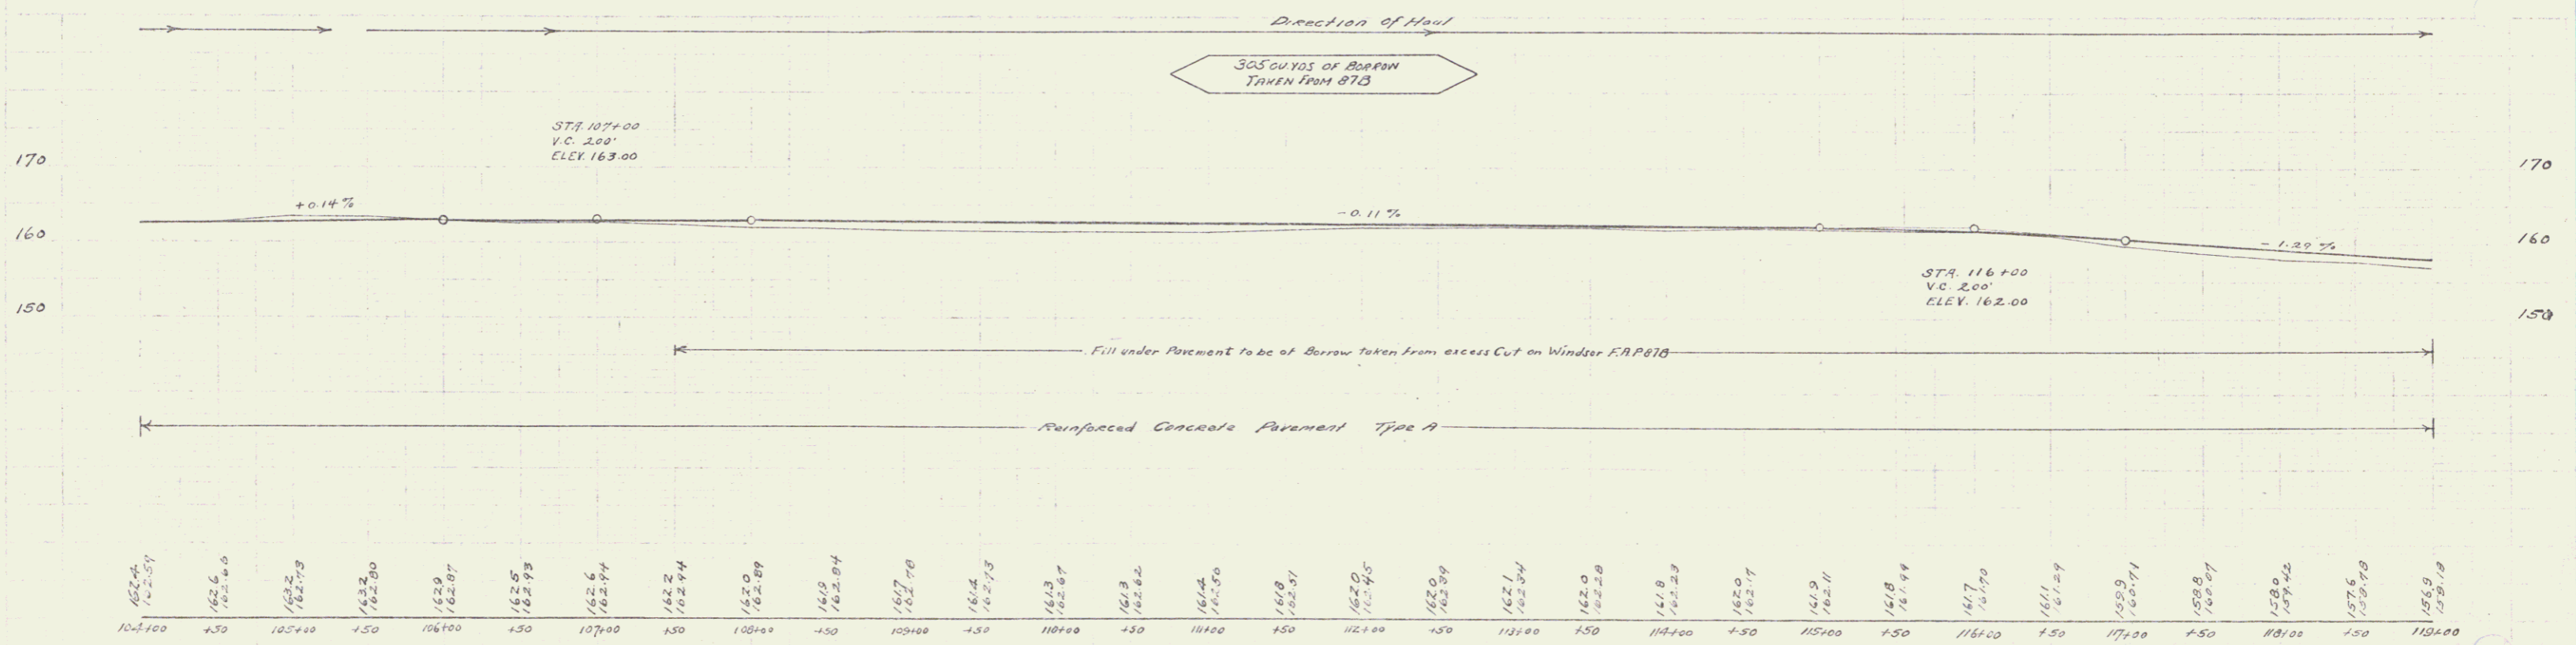


Driveway Culvert
 104+00 Rt. 28'-12" Cor. W.P.
 Class B Concrete 0.80 CT.

Proj. No.	Sheet No.	Year	Scale	Total Sheets
9	11	1927	8	32

CURVE
 $\Delta = 20^{\circ} 34' L$
 $D = 0^{\circ} 30'$
 $T = 240.02334$
 $L = 400.02667$
 $E = 25.27$
 $R = 1160.0$

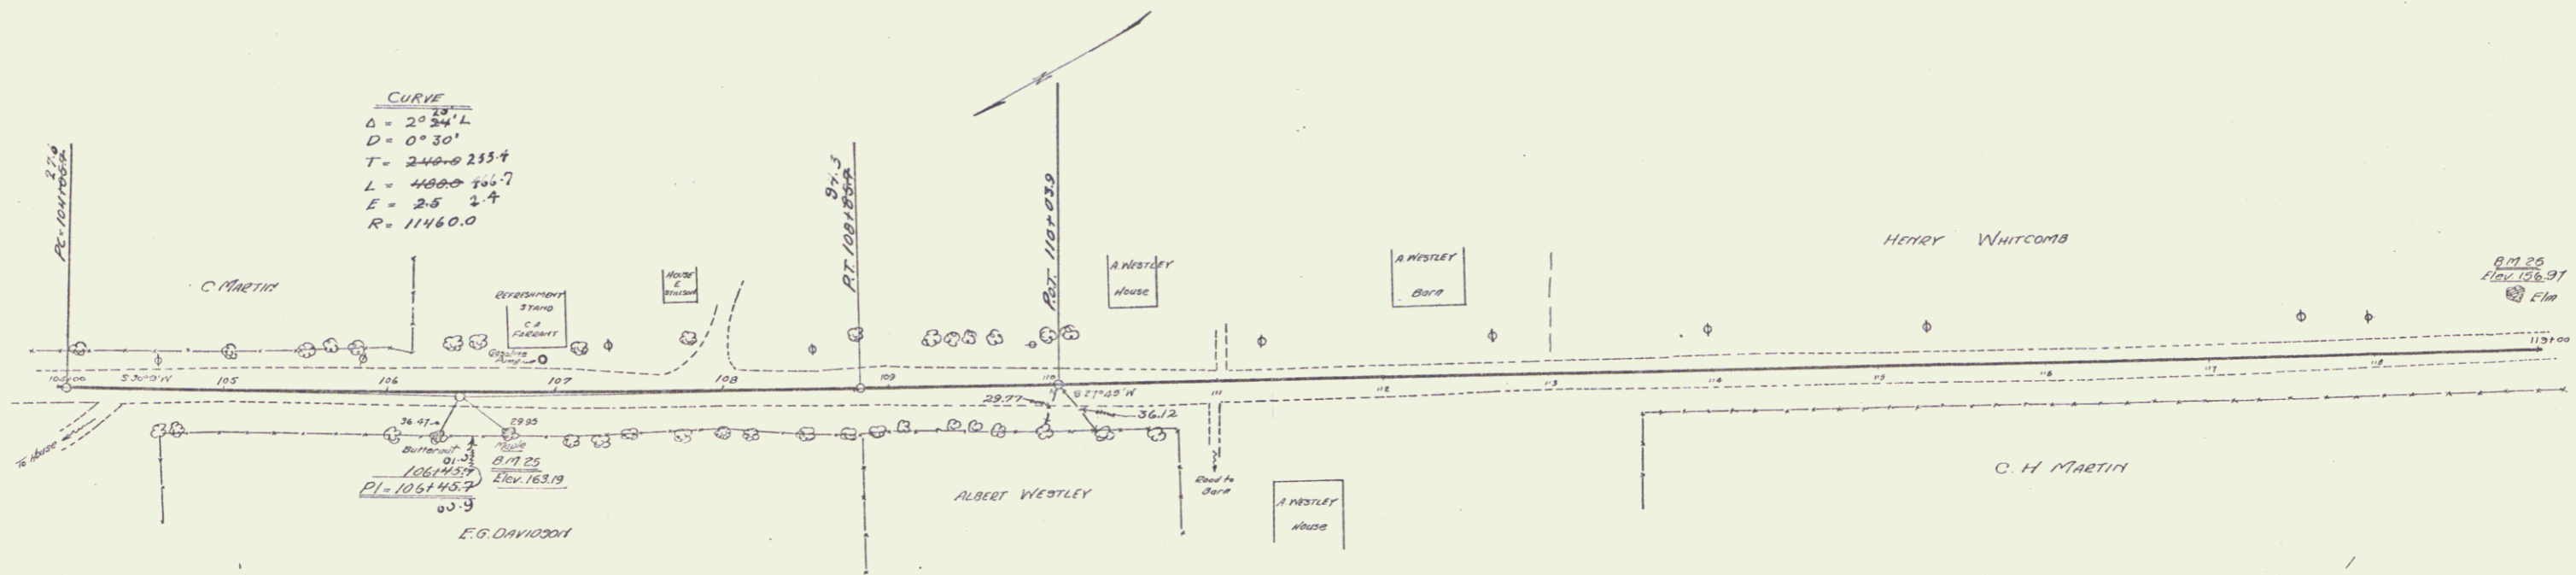

3" x 25' - 30" Maple PI of STA 106+70 - ELEV. 163.19 ft.
 B.M. # 25 - 30" Iron Left - 110+07 - ELEV. 160.91 ft.

6