

INDEX OF SHEETS


SHEET NO.	TITLE PAGE
4	TYPICAL CROSS-SECTION OF IMPROVEMENT WITH RAMP
5	PLAN AND PROFILE STA. 64+00 - STA. 70+00
6	STA. 70+00 - STA. 81+00
7	STA. 81+00 - STA. 91+00
8	STA. 91+00 - STA. 103+00
9	STA. 103+00 - STA. 119+00
10	STA. 119+00 - STA. 131+00

11-32 Cross Sections

DATE	BY	REVISION	NO.	DESCRIPTION
0	Ve	0.00	1	

STATE OF VERMONT
STATE HIGHWAY DEPARTMENT

PLAN AND PROFILE OF PROPOSED
STATE HIGHWAY
FEDERAL AID PROJECT

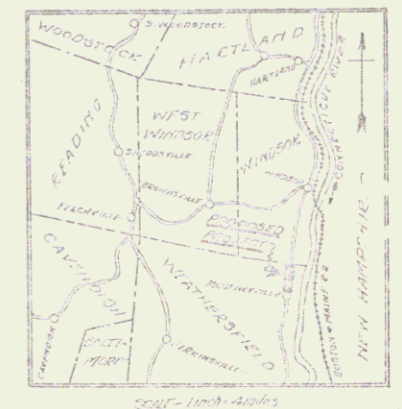

(To Be Returned to H.O.W. DIVISION)
TOWN OF
US5
PERPETUAL
COMMON FINE
EIGHT-OF-WAY DIVISION

TOWN OF WEATHERSFIELD
CONNECTICUT RIVER ROAD
BEGINNING AT WINDSOR-WEATHERSFIELD
TOWN LINE AND EXTENDING SOUTHERLY
MILES TO ASCUTNEYVILLE

Route: US5
Project: F64B
Pin# 99R338



SCALES
PLAN 1" = 100' - 1" = 100 FEET
PROFILE 1" = 10' - 1" = 10 FEET
VERT. CURVES 1" = 10' - 1" = 10 FEET
CROSS SECTIONS 1" = 10' - 1" = 10 FEET

CONVENTIONAL SIGNS

Symbol	Description
---	COUNTY LINE
---	TOWN LINE
---	FENCE LINE
---	STONE WALL
---	UNFENCED PROPERTY
---	QUARRY
---	TRAVELLED WAY
---	RAILROAD
---	RETAINING WALL
---	CENTER LINE
---	SURVEY LINE
---	CULVERT
---	TRUCK INLET
---	TRUCKY POLE
---	POWER POLE
---	TELEPHONE POLE
---	TRUCK
---	TRUCK

RECORD PLANS

THESE PLANS SUBJECT TO SUCH REVISIONS AS MAY BE REQUIRED BY THE BUREAU OF PUBLIC ROADS OR THE CHIEF ENGINEER.

APPROVED: April 14, 1927
[Signature]
Submitted by order of the State Highway Board
April 14, 1927
[Signature]
COMMISSIONER H. O. HARRIS



RECOMMENDED BY:
DISTRICT ENGINEER
BUREAU OF PUBLIC ROADS
COMMISSIONER H. O. HARRIS

DIST. # 4 PLANS 1

Wood Guard Rail Required
 Right
 Sta 55138 to 55143 length 24 ft
 Left
 Sta 55138 to 55142 length 24 ft

New Culverts Required
 Sta 55138 15" Rein Conc Pipe length 30 ft
 Conc Class (B-25) 1184 lb
 Rein Steel 135 lb
 Conc. Grout 3-1 cu.

Proj No	Dist No	Sheet No	Total Sheets
9	VI	64B	32

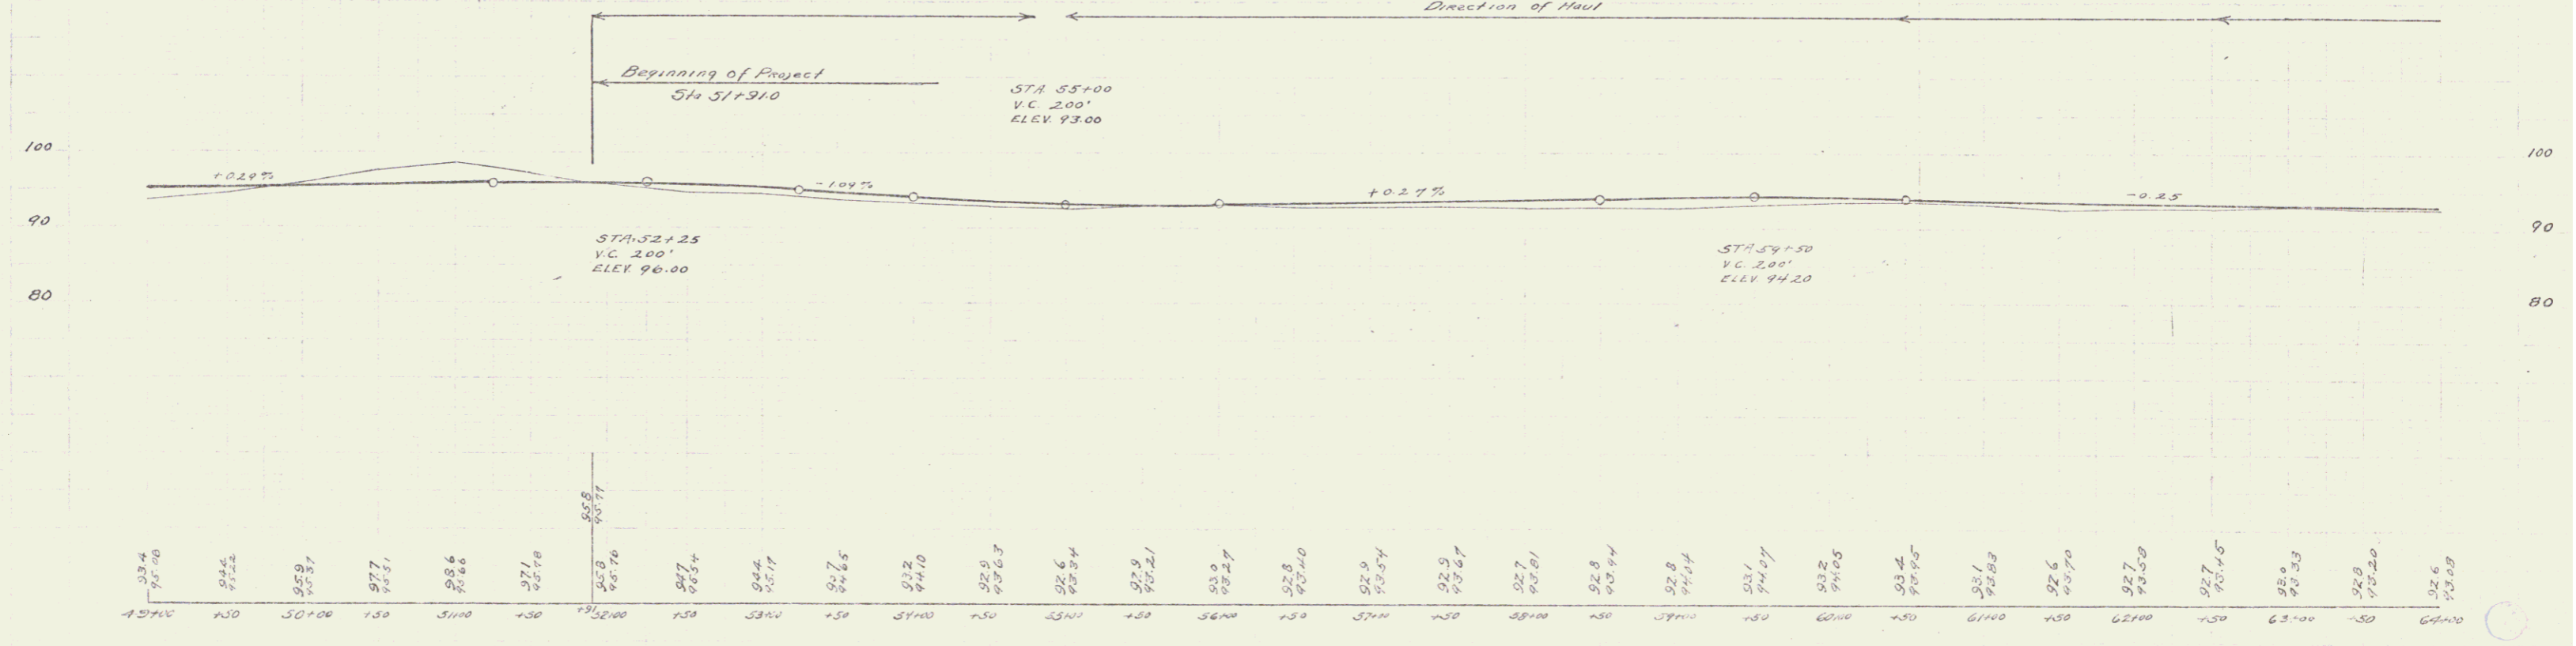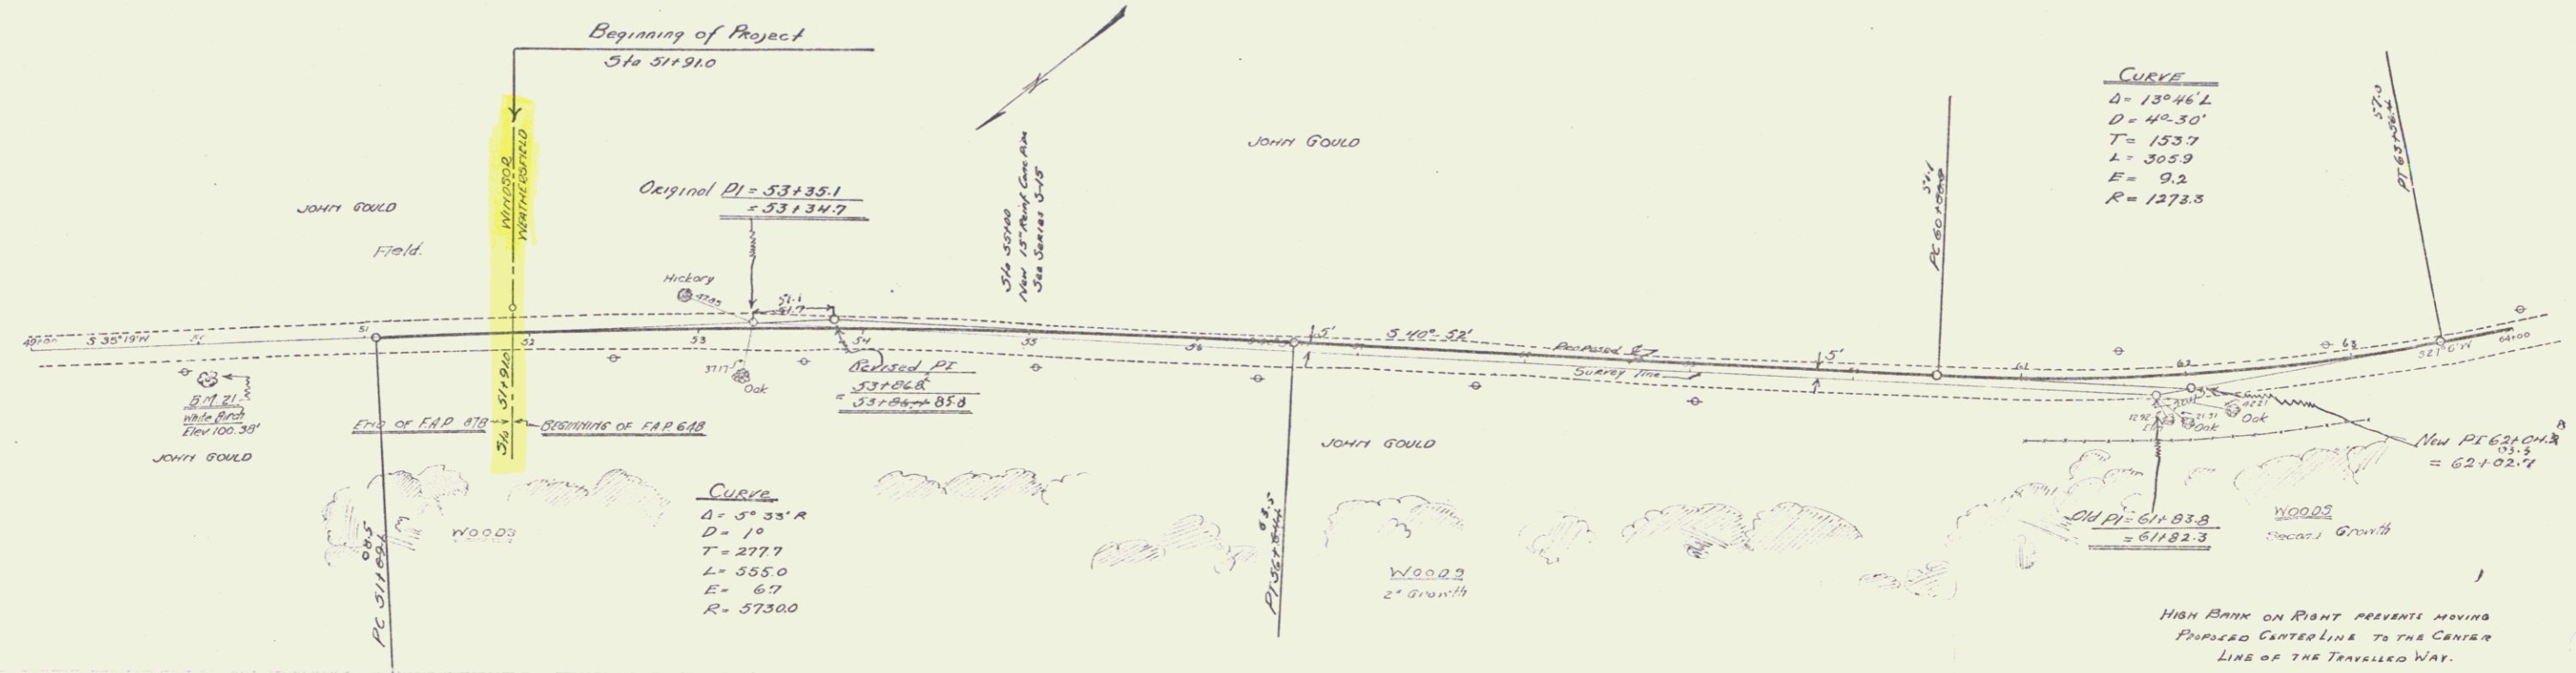

49+00	93.4	50+00	94.2	51+00	95.9	52+00	97.7	53+00	98.6	54+00	97.8	55+00	95.8	56+00	92.7	57+00	92.6	58+00	92.9	59+00	92.7	60+00	92.8	61+00	92.6	62+00	92.7	63+00	92.6	64+00	92.6
-------	------	-------	------	-------	------	-------	------	-------	------	-------	------	-------	------	-------	------	-------	------	-------	------	-------	------	-------	------	-------	------	-------	------	-------	------	-------	------

B.M. #21 - 18" White Birch at Sta 50+00 Elev 100.38 ft

SERIES F No 64B
 SHEET 14 OF 32

Wood Guard Rail Required

Sta 65180 to 66180	length	24 ft
Sta 66180 to 67180	length	24 ft
Sta 67180 to 68180	length	24 ft
Sta 99180 to 100180	length	24 ft

Cable Guard Rail Required

Sta 73130 to 73700	length	344 ft
Sta 73700 to 74270	length	320 ft
Sta 74270 to 74840	length	273 ft



New Culverts Required

Sta 66100-315	15" Reinf. Conc Pipe length 38 ft	1424 lb
Sta 66100-315	Conc Class B(1-25-3)	13320 lbs
Sta 69170	15" Reinf. Conc Pipe length 32 ft	1216 lb
Sta 69170	Conc Class B(1-25-3)	11248 lbs
Sta 73168	18" Reinf. Conc Pipe length 36 ft	1368 lb
Sta 73168	Conc Class B(1-25-3)	12702 lbs
Sta 76170	15" Reinf. Conc Pipe length 32 ft	1216 lb
Sta 76170	Conc Class B(1-25-3)	11248 lbs

New Drivng Way Culvert Required

Sta 77170	12" Conc Iron Pipe length 16 ft	1560 lb
Sta 77170	Conc Class B(1-25-3)	14400 lbs
Sta 77170	Reinf. Steel	33 lbs

File No.	Sheet No.	Year	Scale	Sheet No.	Total Sheets
9	48	1927		5	32

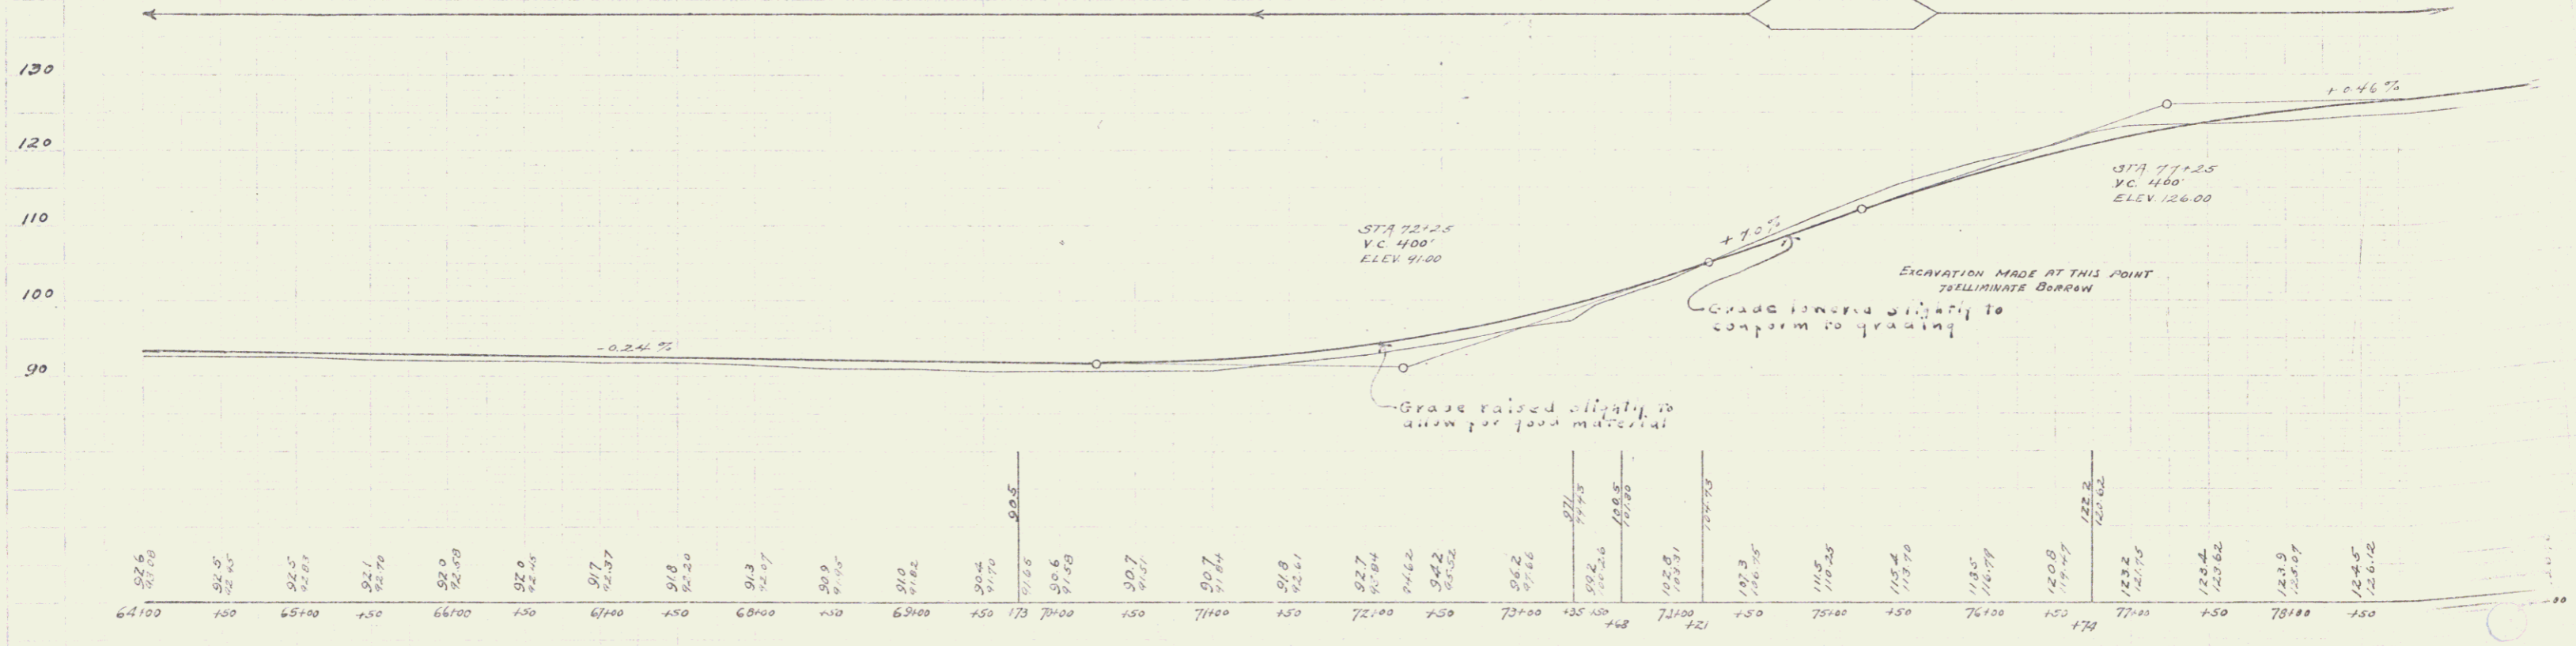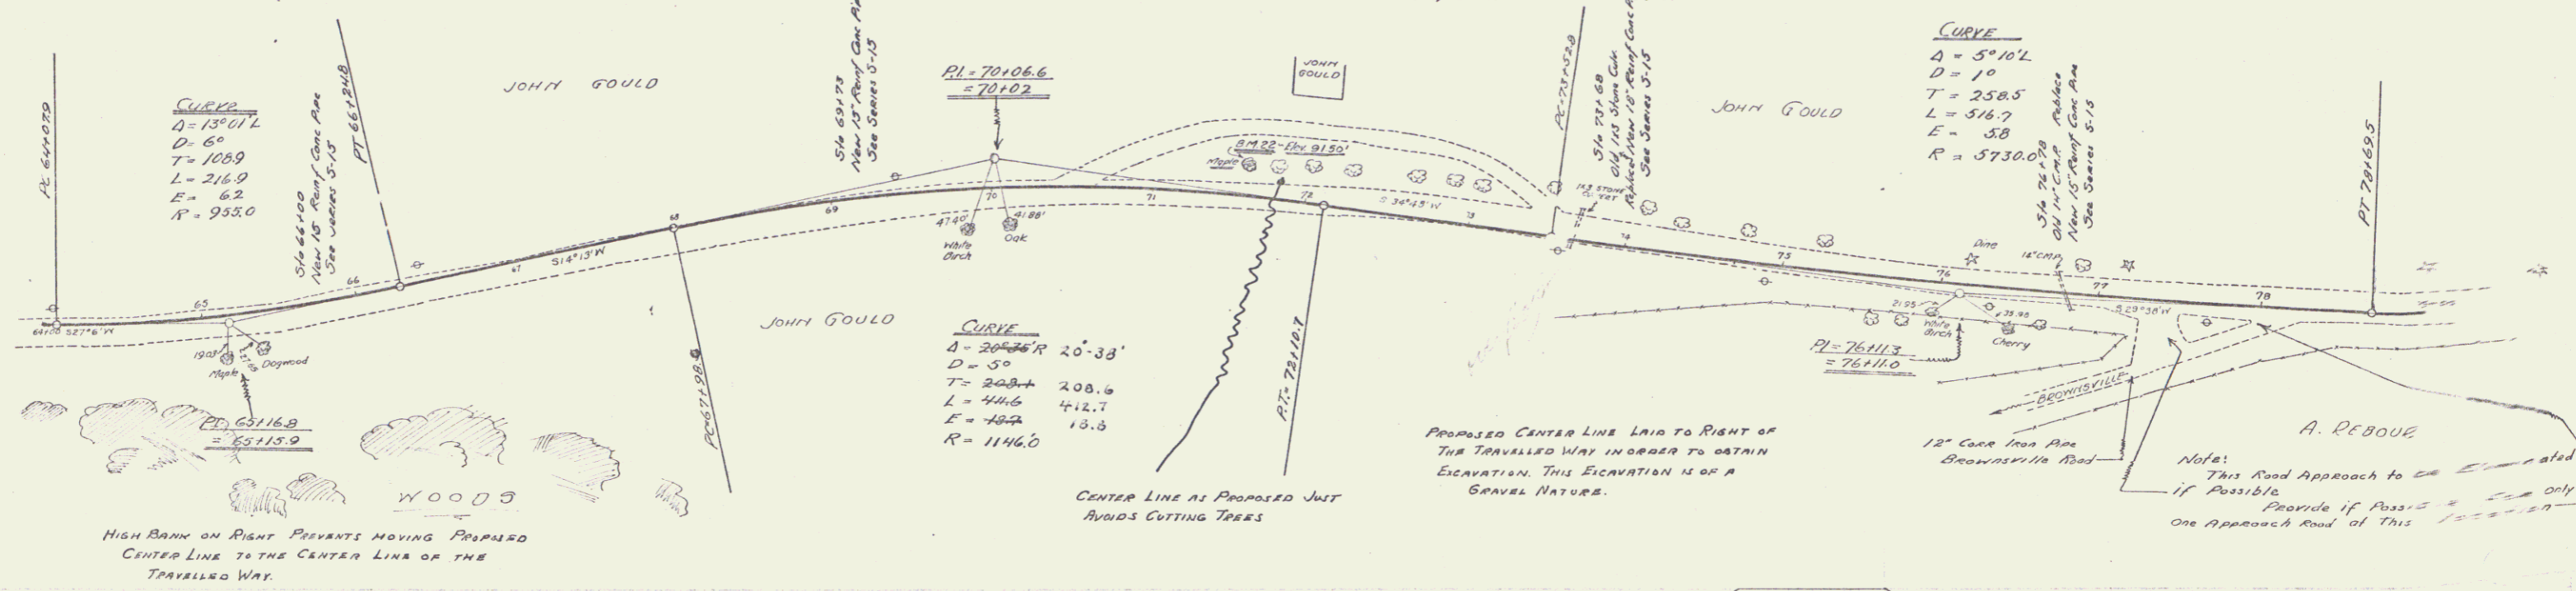

64100	64150	64200	90000
-------	-------	

Wood Guard Rail Required
Sta 86171 to 86195 length 24 ft

Cable Guard Rail Required
Left
Sta 86195 to 86220 length 25 ft

New Culverts Required
Sta 86183 18" Rein. Conc. Box Culvert 32
Conc. Class 40-20) 3 3/4" dia
Rein. Steel 33 #4's


Proj. No.	Sheet No.	Scale	Date	Drawn	Checked
9	11	640	1927	G	32

CURVE
Δ = 1017' L
D = 1°
T = 64.2
L = 128.3
E = 0.4
R = 5730

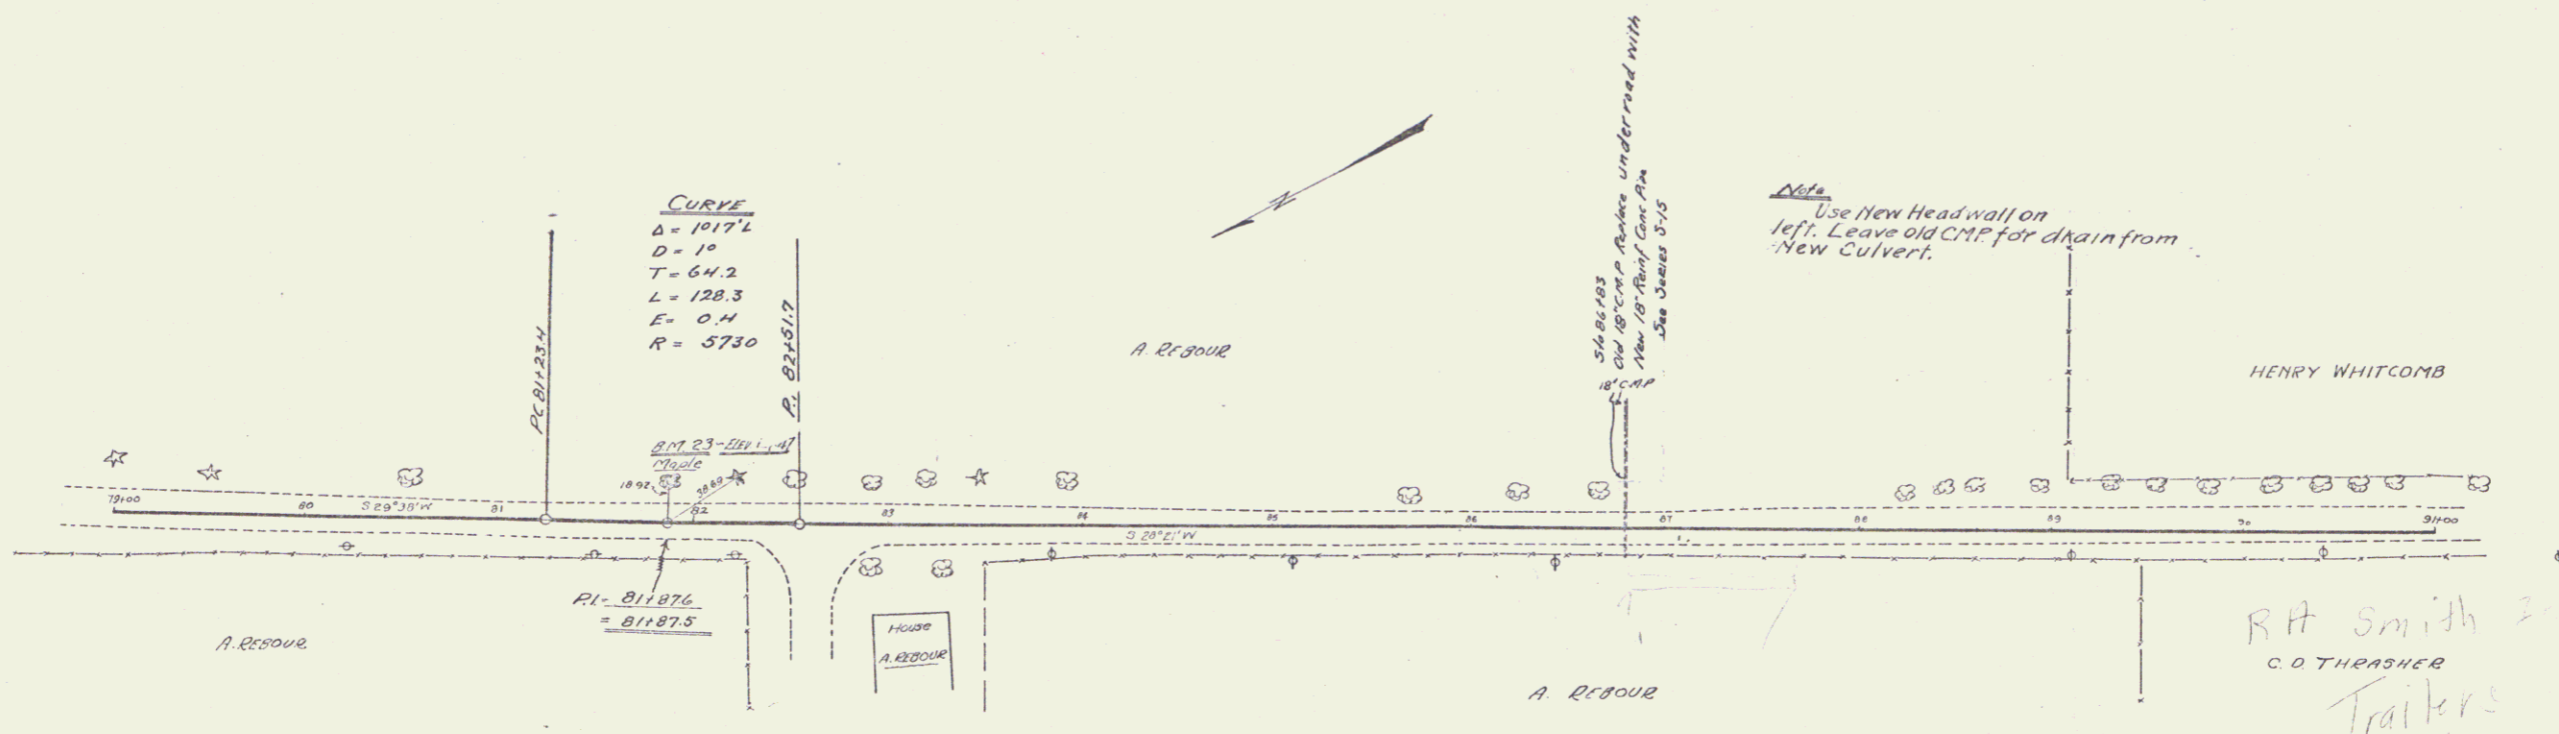

Note
Use New Head wall on left. Leave old CMP for drain from New Culvert.

RT Smith & Co
C.O. THRESHER
Trailers

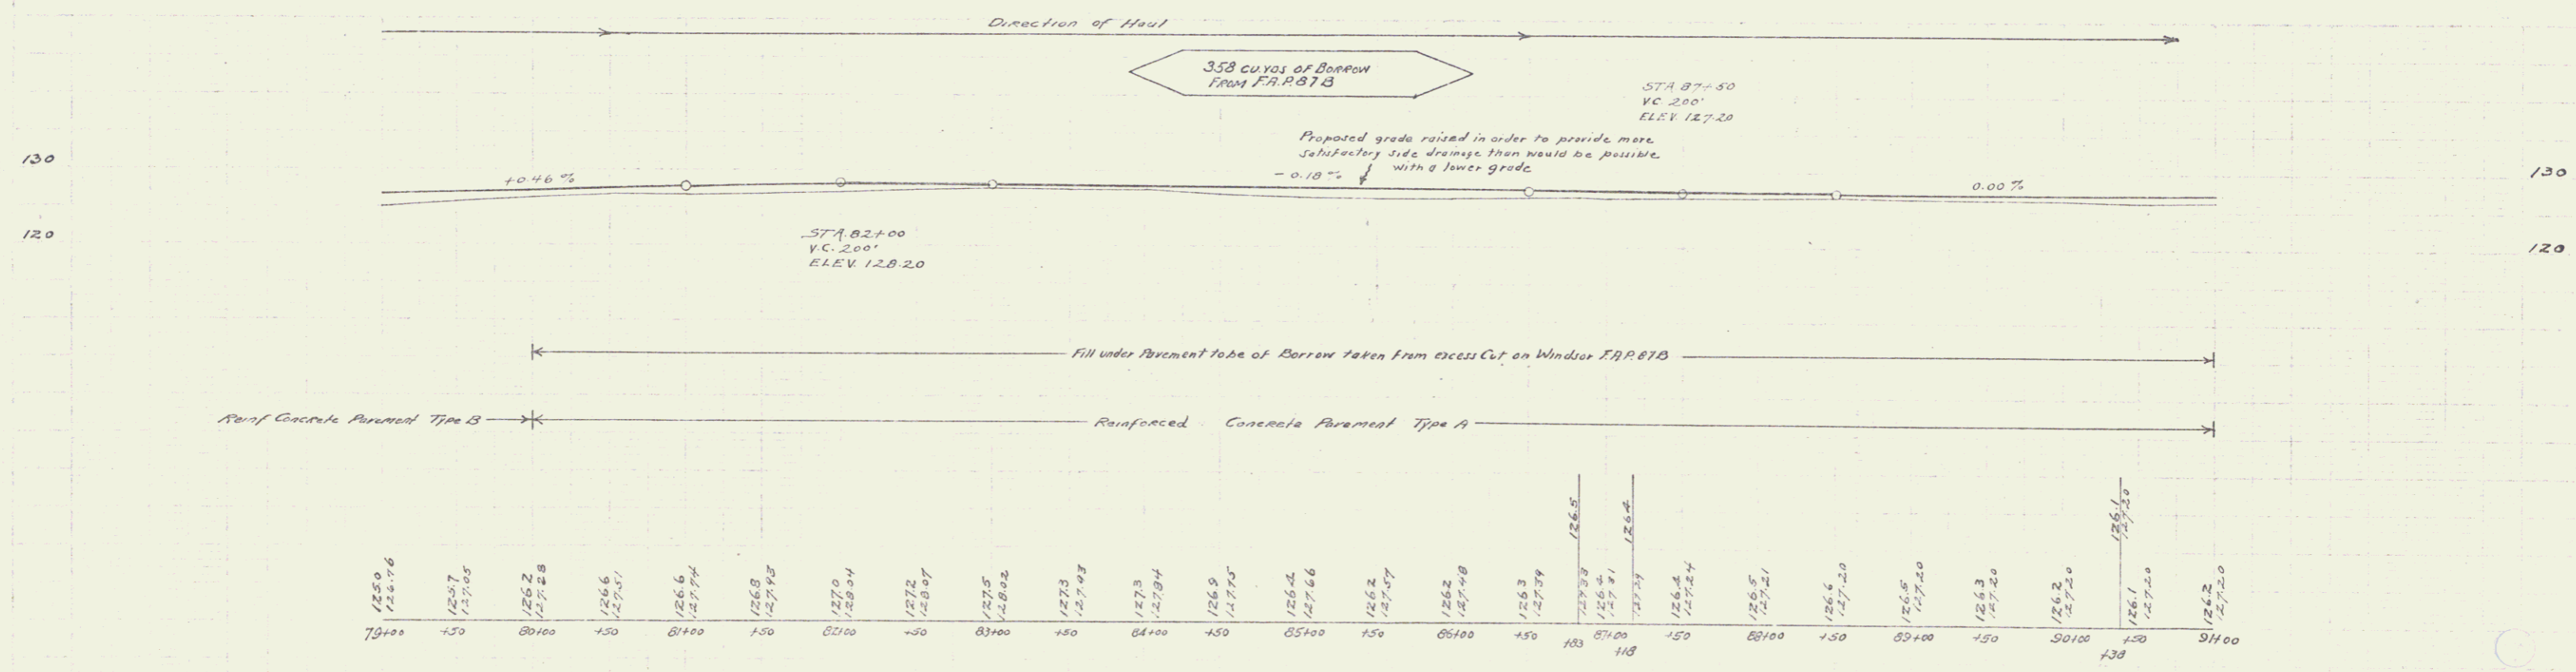

S.M. # 23 - 30' Maple Lot of 2nd. 8-1-07 - 811. 127.47 ft.

Series E No 508
Sheet 6 of 32

Wood Guard Rail Required
 Right
 Sta 94+32 to 94+37 length 34 ft
 Sta 102+33 to 102+37 length 24 ft
 Left
 Sta 102+33 to 102+37 length 24 ft
 Sta 94+18 to 94+37 length 24 ft


Cable Guard Rail Required
 Left
 Sta 94+18 to 94+37 length 360 ft
 Right
 Sta 94+18 to 94+37 length 24 ft

New Culverts Required
 Sta 94+25 15" Rinf Conc Pipe length 32 ft
 Conc Class A (1-24) (Diameter) 24 ft 2.1
 Rinf Steel 33 lbs
 Sta 98+40 15" Rinf Conc Pipe length 32 ft
 Conc Class A (1-24) (Diameter) 24 ft 2.1
 Rinf Steel 33 lbs
 Sta 102+45 15" Rinf Conc Pipe length 36 ft
 Conc Class B (1-24-5) 2.2 2.4
 Rinf Steel 33 lbs
 Grouted Coprie Gutter
 on Rt driveway 98+75 26 sq yds


Concrete Retaining Wall Required
 Right
 Sta 97+30 to 98+36 length 70 ft
 Conc Class B (1-24-5) 2.1 2.2
 Rinf Steel 33 lbs 100'
 For Detail See Sheet 3 Series F No 648

Relief Culvert (Drive By) Required
 Sta 102+05 12" Rinf Conc Pipe length 16 ft
 Conc Class B (1-24-5) 2.2 2.4
 Rinf Steel 33 lbs
 To be Relayed with Pipe Taken from Sta 98+40

Proj No	Sheet No	Project Name	Scale	Sheet No	Total Sheets
9	W	648	1927	7	32

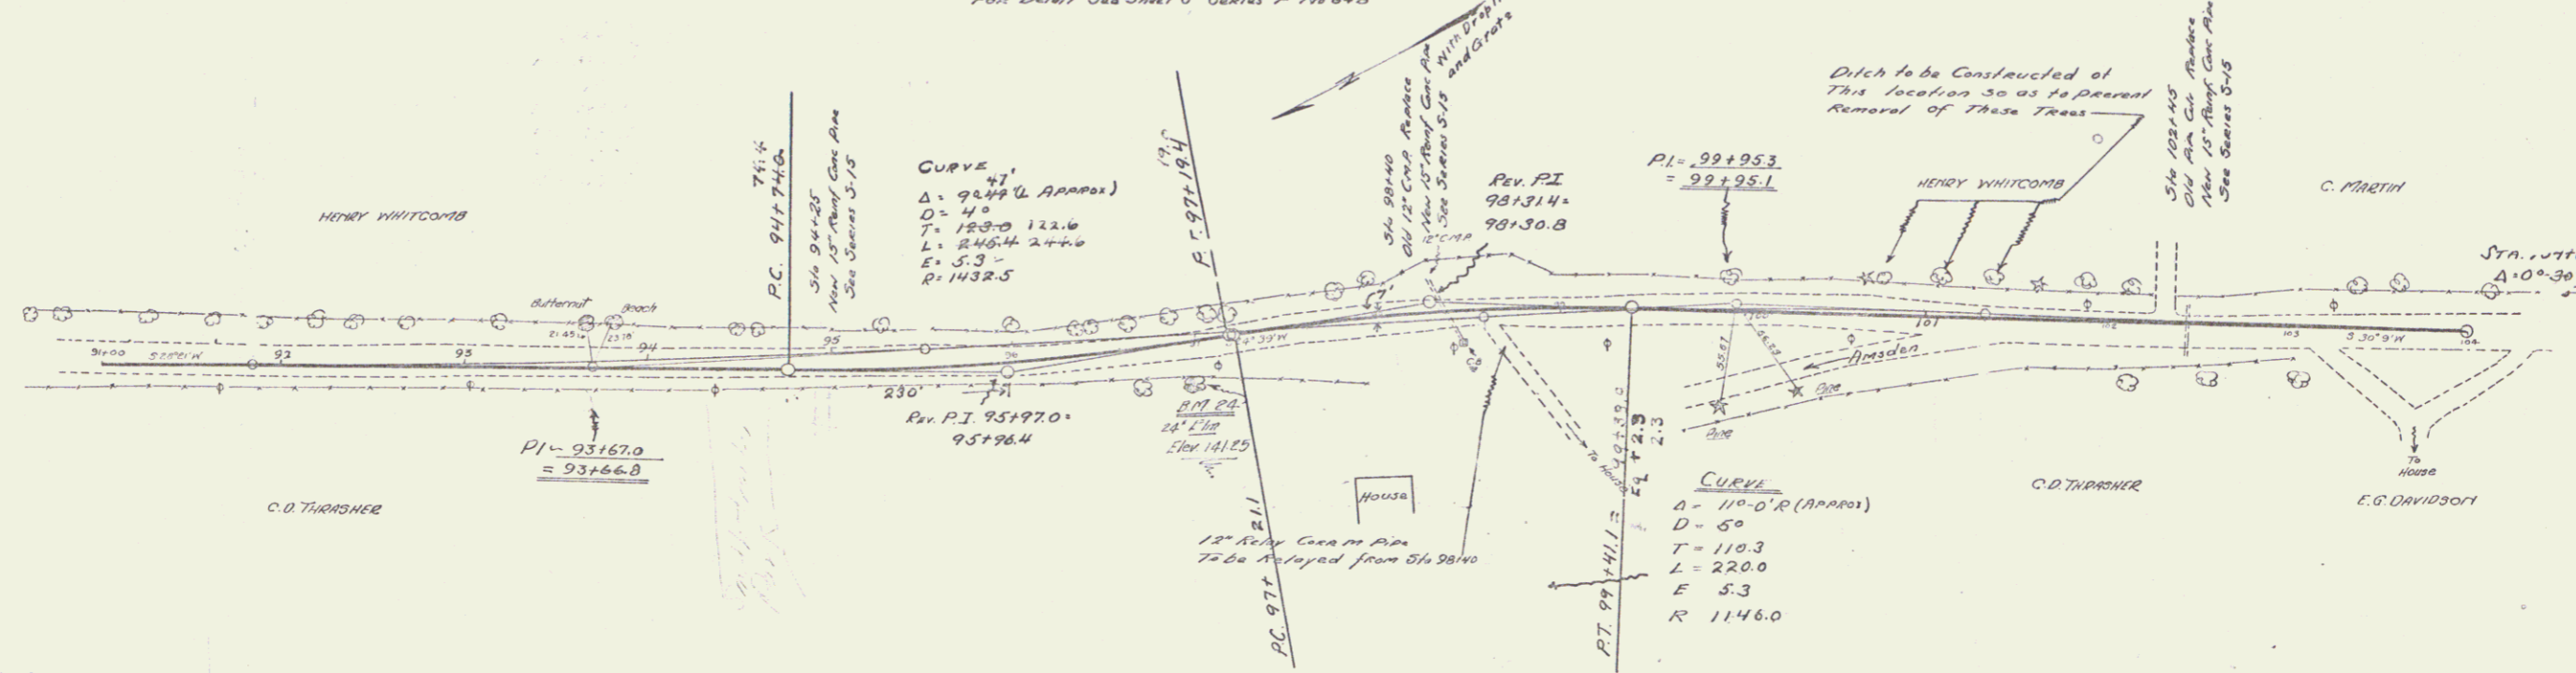

Direction of Road
 SEE NOTE
 NOTE - Borrow is to be made from Excess Cut Taken from Windsor F.P. 87B


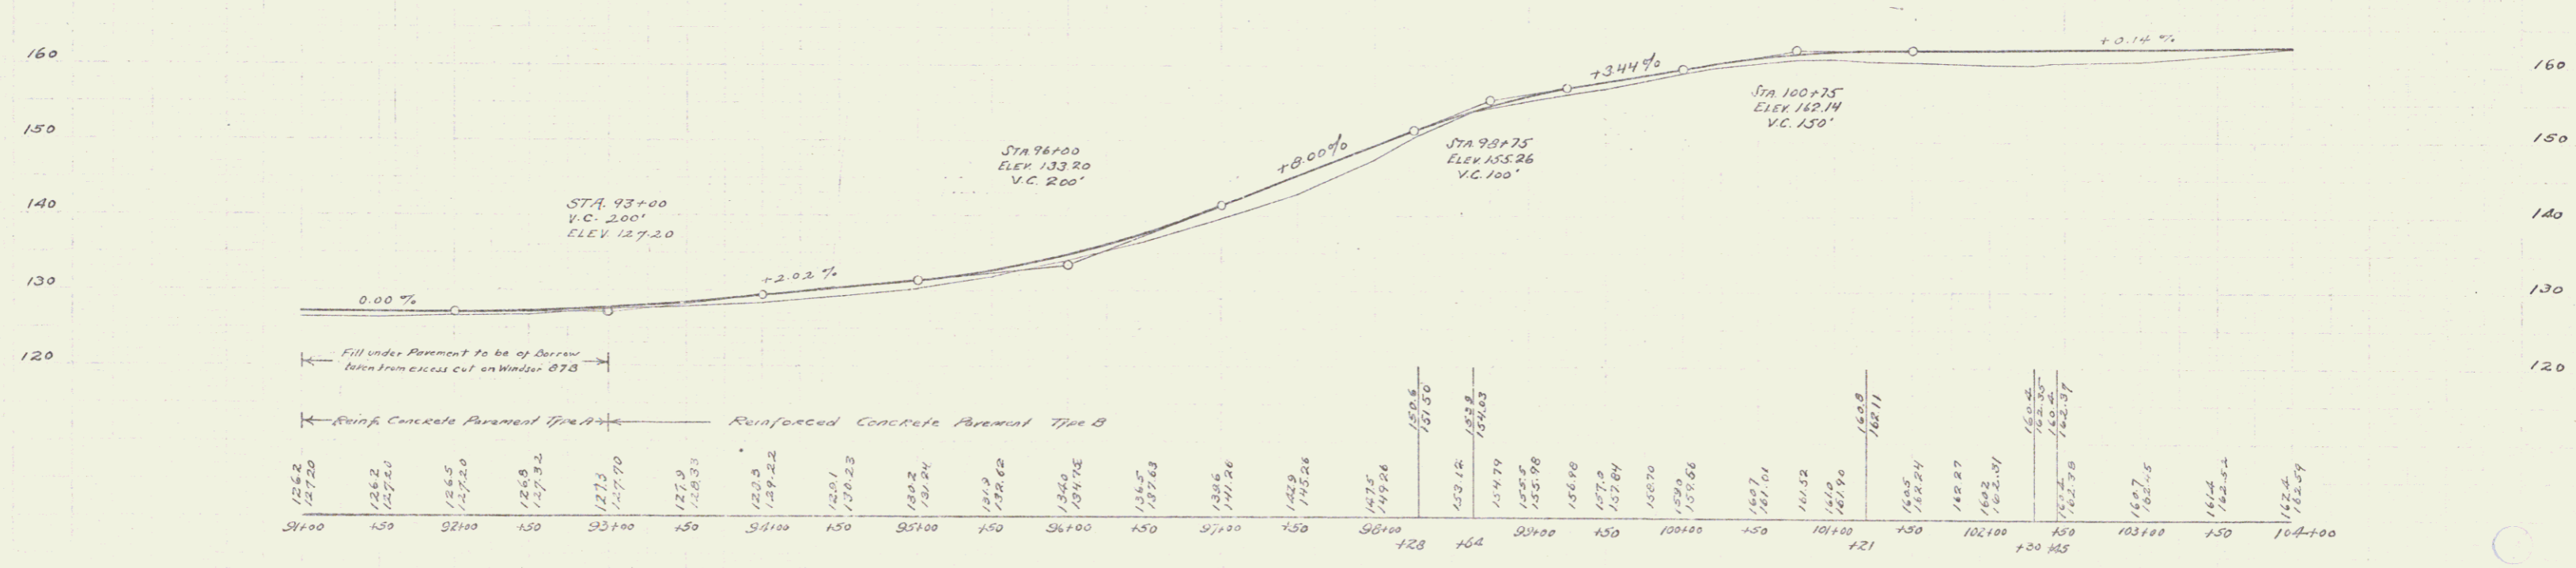


Sta 94+18 to 94+37 Elev 141.25 ft

Driveway Culvert
 104+00 Rt. 28'-12" Cor. N.R.
 Class B Concrete 0.80 CT.

Proj. No.	Sheet No.	Year	Sheet No.	Total Sheets
9	11	1927	8	32

CURVE
 $\Delta = 20^{\circ} 34' L$
 $D = 0^{\circ} 30'$
 $T = 240.0 \pm 233.4$
 $L = 400.0 \pm 361.7$
 $E = 25 \pm 2.7$
 $R = 1160.0$

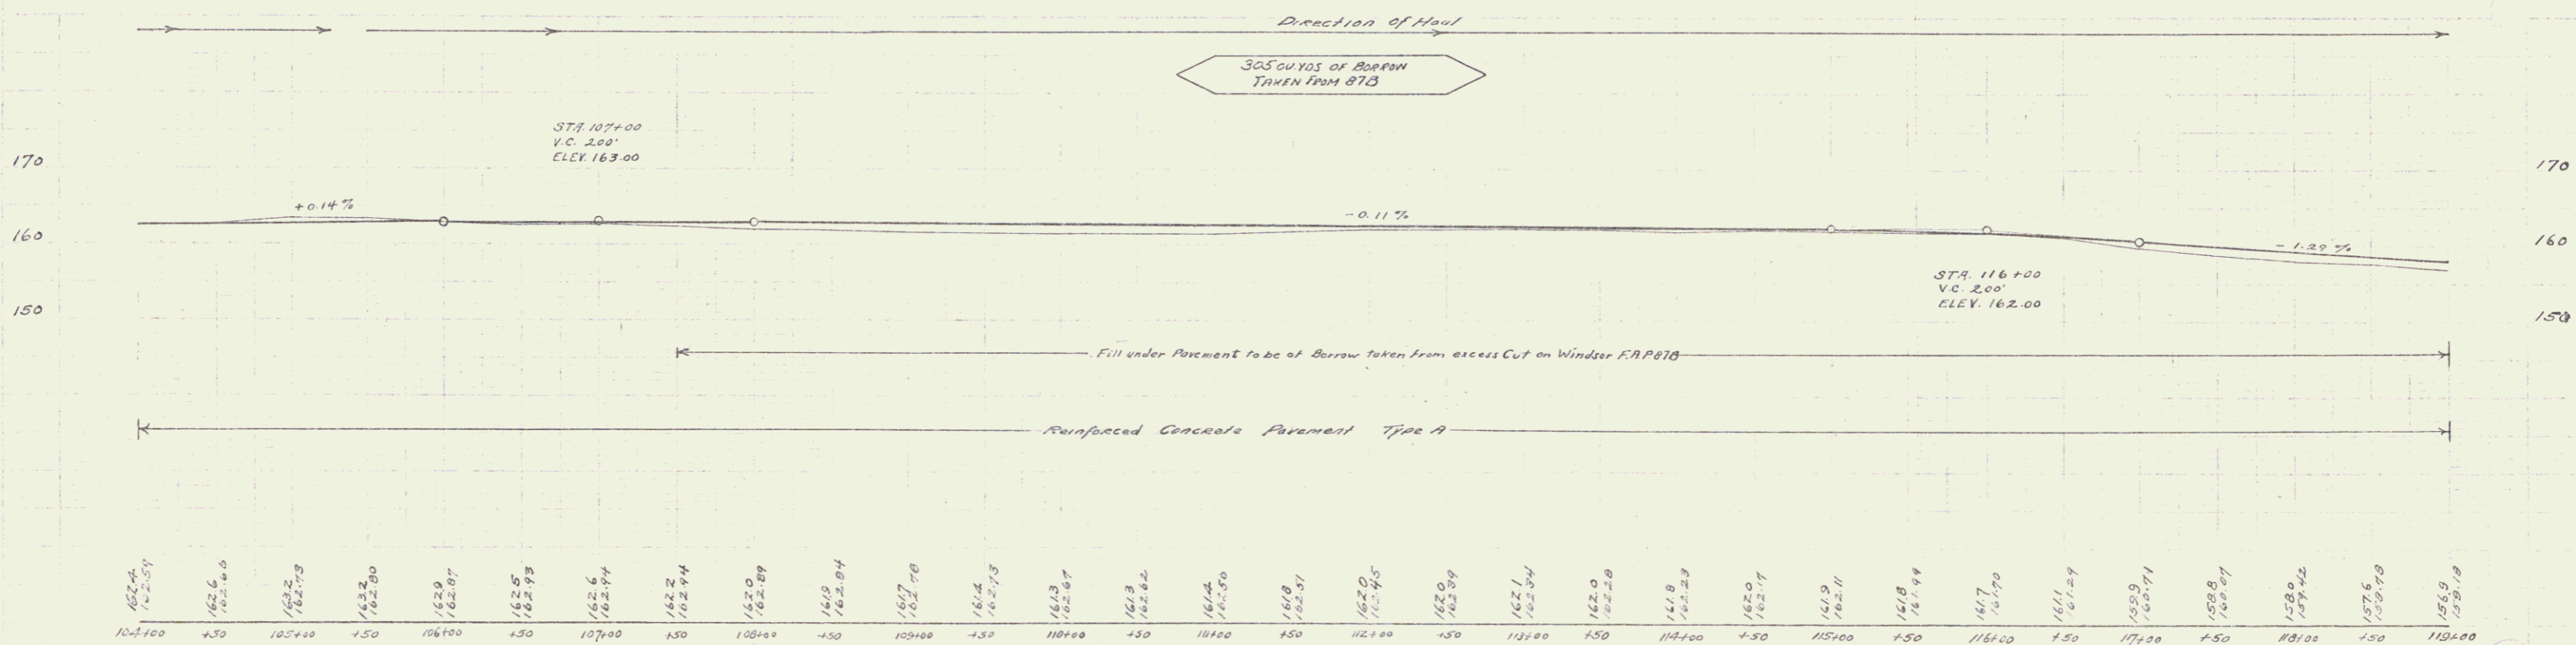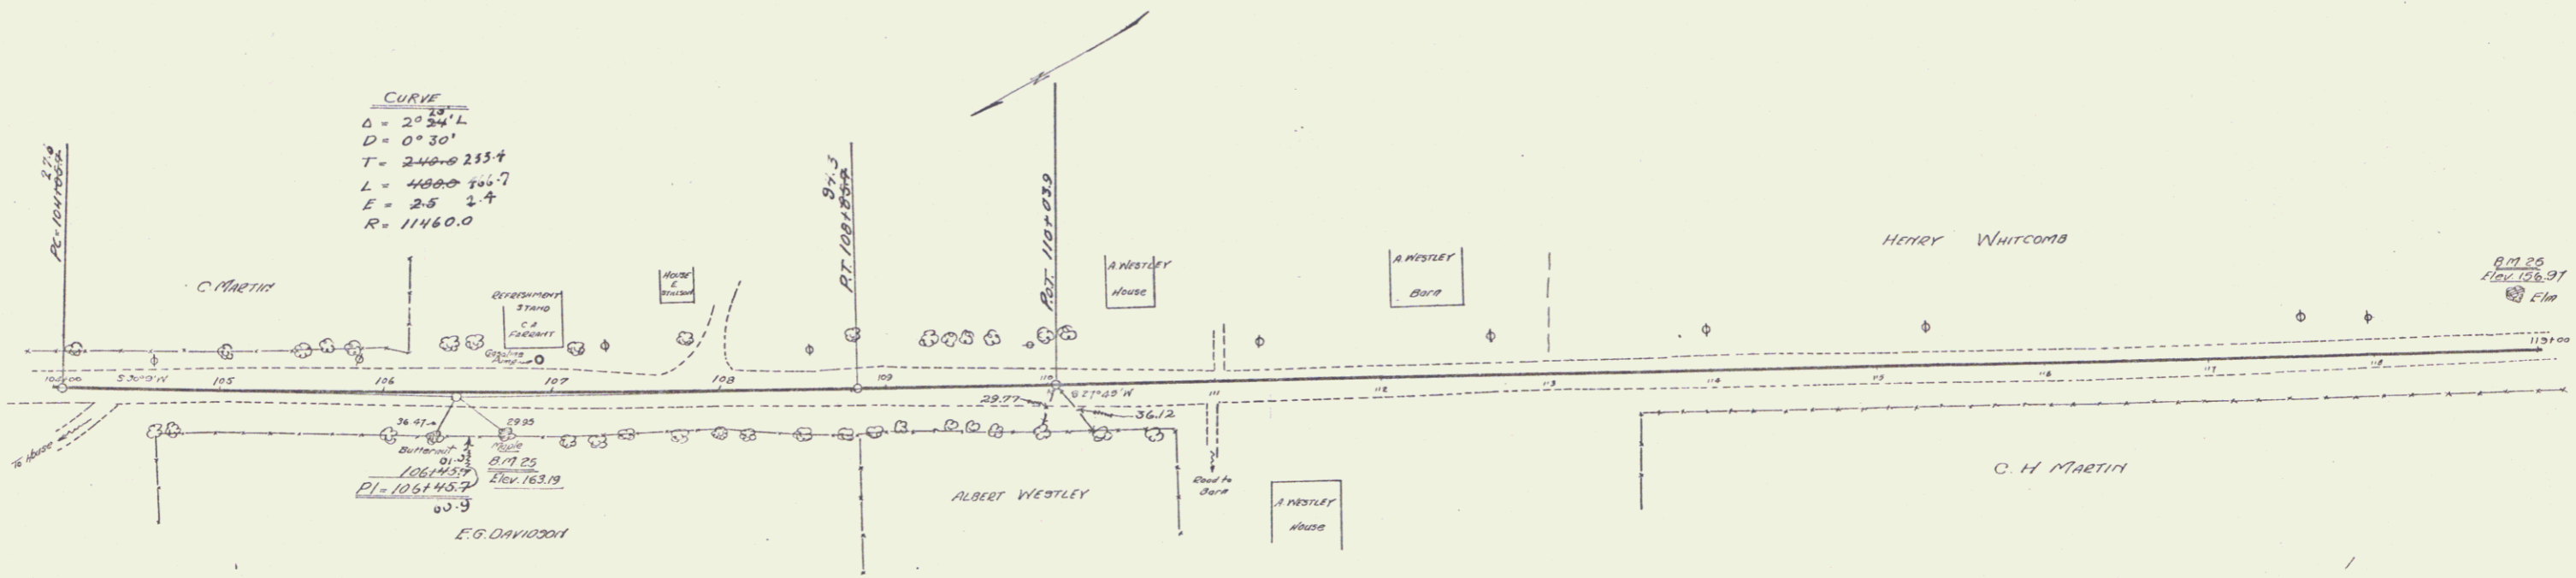

104+00	104+30	105+00	105+30	106+00	106+30	107+00	107+30	108+00	108+30	109+00	109+30	110+00	110+30	111+00	111+30	112+00	112+30	113+00	113+30	114+00	114+30	115+00	115+30	116+00	116+30	117+00	117+30	118+00	118+30	119+00
165.4	162.6	162.2	162.2	162.9	162.5	162.6	162.2	162.0	161.8	161.4	161.2	161.0	160.8	160.6	160.4	160.2	160.0	159.8	159.6	159.4	159.2	159.0	158.8	158.6	158.4	158.2	158.0	157.8	157.6	157.4

3" x 25' - 30" Maple PI of STA 106+70 - ELEV. 163.19 ft.
 B.M. # 25 - 30" Iron Left - 110+07 - ELEV. 160.91 ft.



Series F No 648
 Sheet 11 of 32

6

Proj. No.	Sheet No.	Total Sheets
9	10	32

Grouted Cobble Gutter for Driveway
135+25 Lt. 14 Sq. Yds.
Drainage Tile
138+00 - 142+55 Lt.
390' 10" Ungrouted Clay Tile
Two Catch Basins and Outlet Flow
Concrete Class II 5.2 c.y.
Reinforced Steel 271 lbs.
Two Drop Inlet Grates.

Double Bituminous Surface Treatment
132+30 - 137+30 Rt. - 167 Sq. Yds.

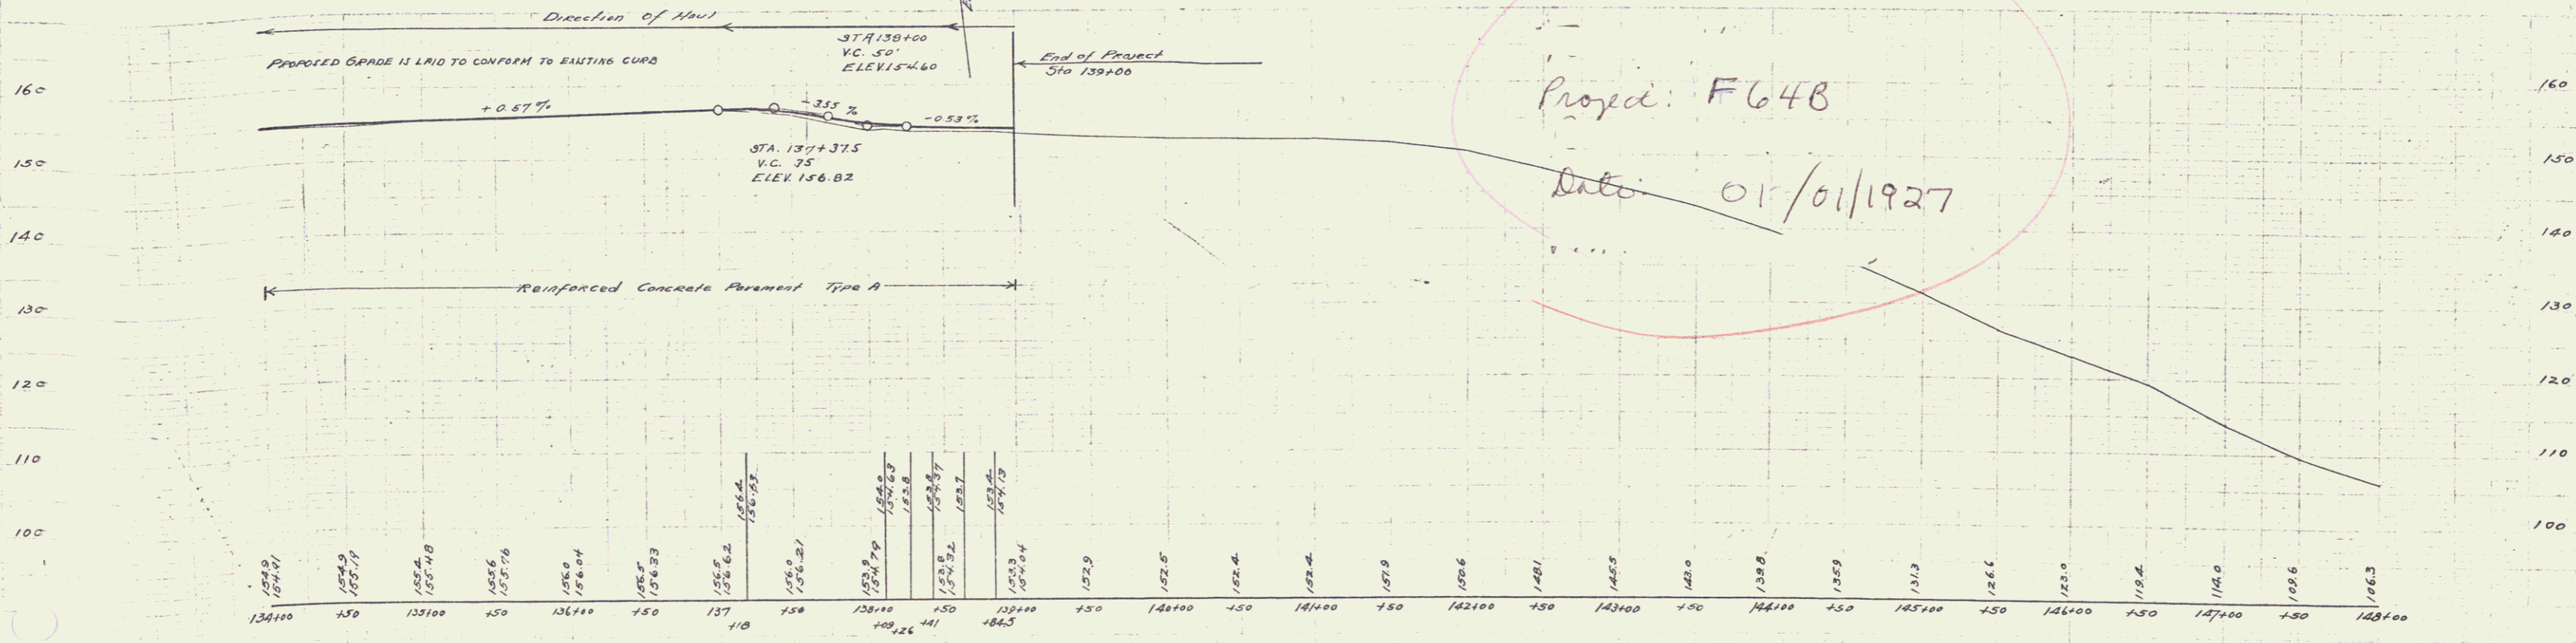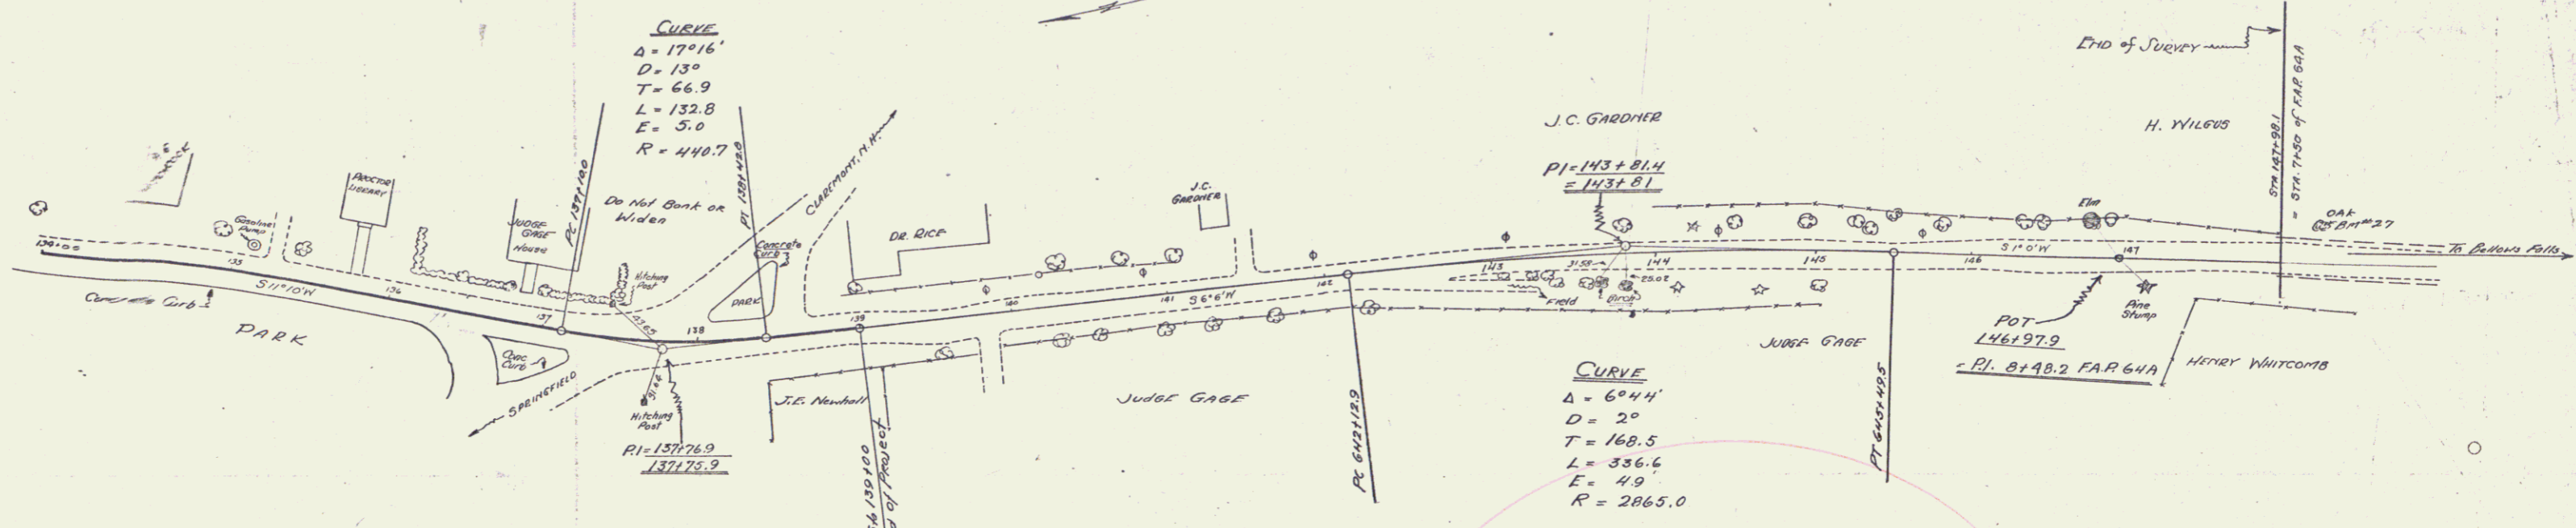

Proped: F648
Date: 01/01/1927

B.M. #28 Rt. 5/4 148+25 Evt. Elev 103.83

SERIES F No. 648
Sheet 10 of 32