
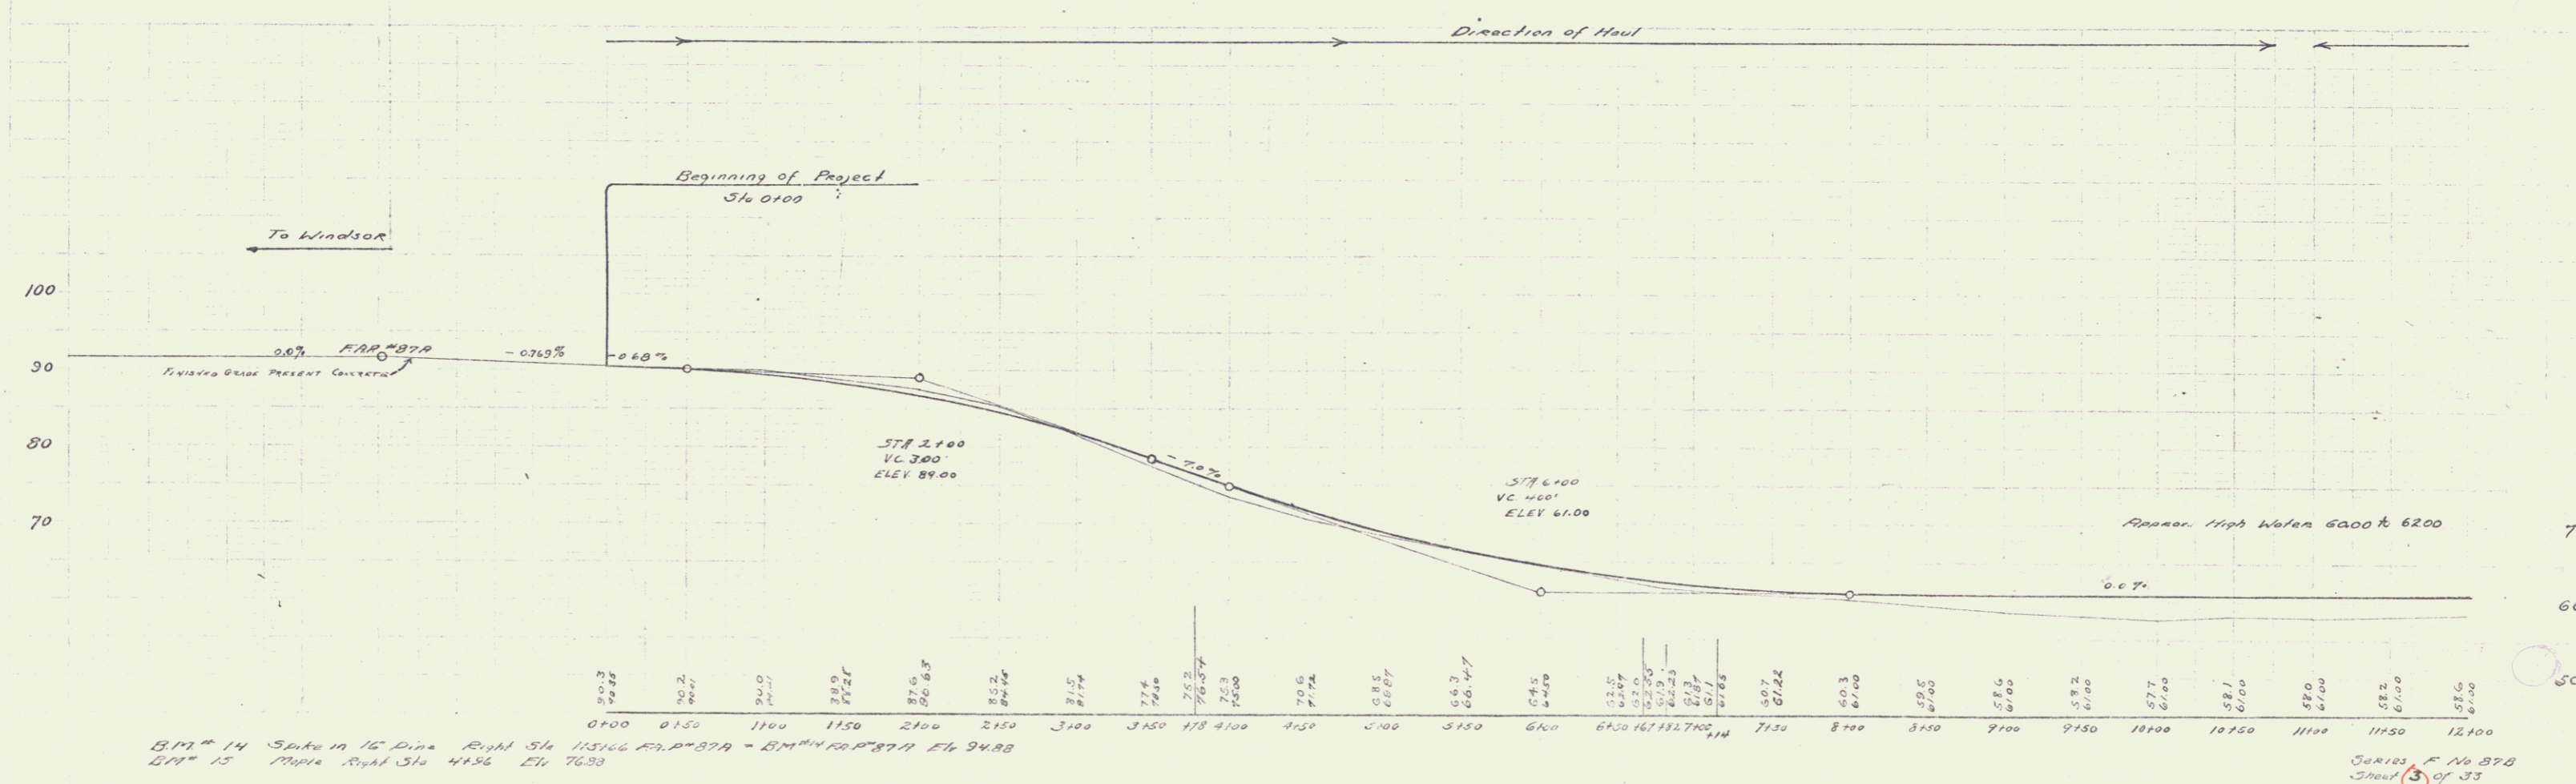


Wood Guard Rail Required  
Right  
Sta 3100 to 4112 Length 240  
" 0100 " 7112 " 24 "

Coarse Guard Rail Required  
Left  
Sta 1170 to 6130 Length 480 ft  
" 6188 " 12100 " 312 "

New Culverts Required  
Sta 4100 18" Reinf Conc Pipe Length 44 ft  
Conc Class (A(2-3-4)) 15 cu yd  
Reinf Steel 60 lbs  
Sta 7100 24" Reinf Conc Box  
Conc Class (A(2-3-4)) 27 cu yd  
Reinf Steel 620 lbs  
Sta 11100 18" Reinf Conc Pipe Length 40 ft  
Conc Class (A(2-3-4)) 10 cu yd  
Reinf Steel 60 lbs

Proj. No.	Sheet No.	Sheet No.	Sheet No.	Total Sheets
9	11	27B	1927	3 33

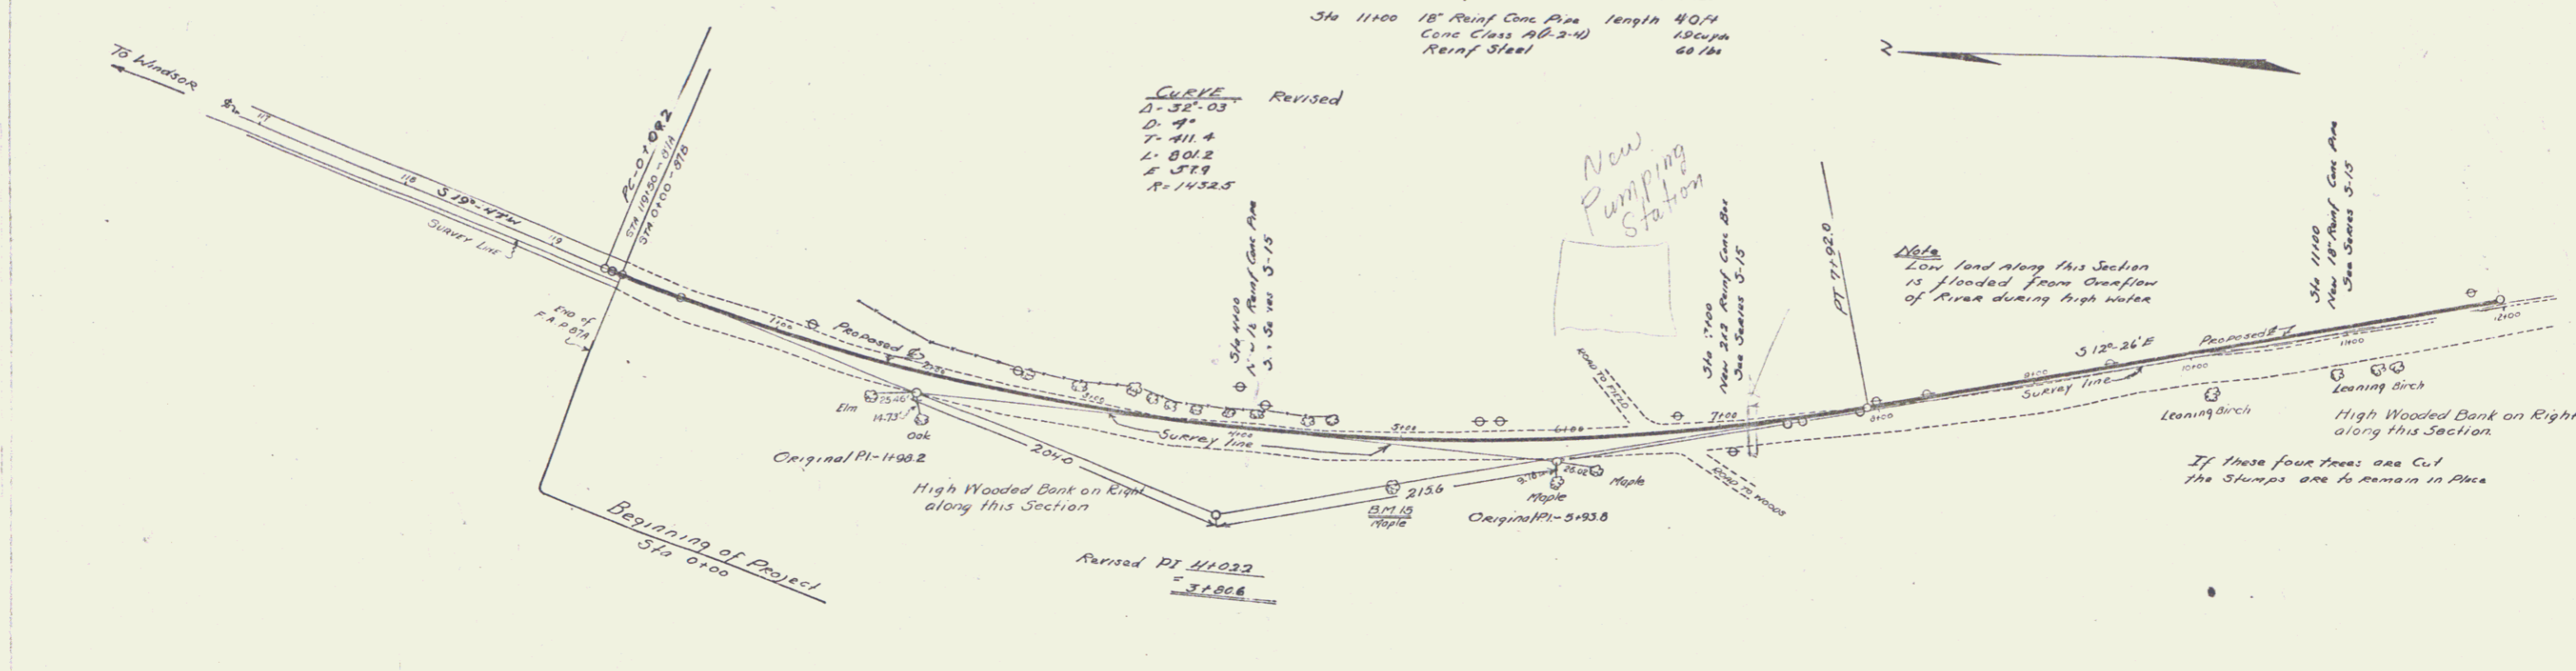

BM # 14 Station in 16' Ditch Right Sta 11516 Elev 89.00 - BM # 14 R.P. # 8711 Elev 94.88  
 BM # 15 Middle Road Sta 4136 Elev 76.93

Series F No 87B  
 Sheet 3 of 33