

Wood Guard Rail Required
Right
Sta 30177 to 30101 length 76 ft


Cable Guard Rail Required
Left
Sta 27100 to 30153 length 303 ft

New Culverts Required
Sta 30189 24" Round Conc. Pipe length 44 ft
Conc. Class A(1-2-4)
Rein. Steel


Grouted Cobble Gutter Required
Sta 27100 to 30175 length 375 ft
Sta 31125 to 32150 length 125 ft

Proj. No.	Sheet No.	Year	Total Sheets
9	14	1937	33

Concrete Curb with Gutter Required
Sta 30125 to 31125 length 100 ft

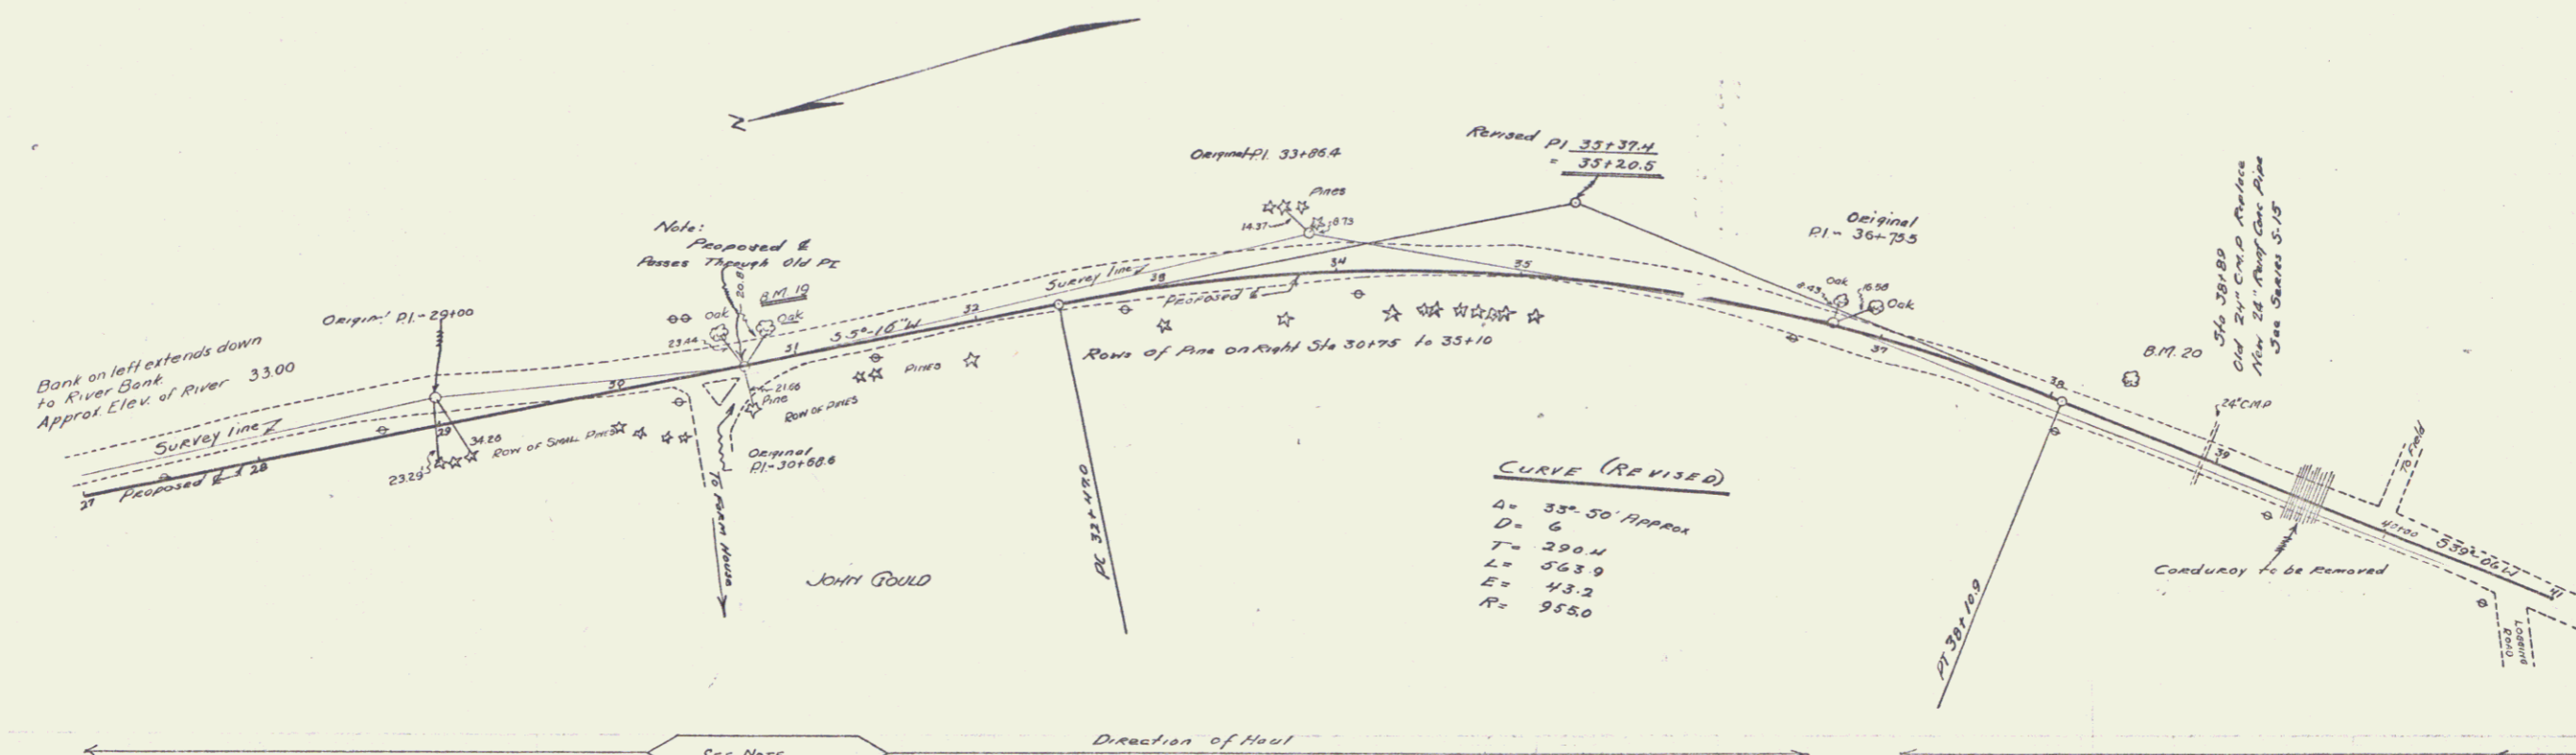

NOTE:-
AT THIS SECTION 145 CU YDS OF EXCAVATION, WHICH IS OF A GRAVEL NATURE, IS FIGURED AS AN EXCESS FOR THIS PROJECT AND 870 CU YDS TO BE HAULED AHEAD TO PROJECT 640, WEATHERFIELD AND USED AS BORROW TO THE COMPUTED QUANTITY OF 152 CU YDS, AND AS SELECTED BORROW UNDER THE PAVEMENT FROM STA. 80100 TO STA. 120100 FOR 718 CU YDS. THE REMAINDER OF THE EXCESS, OR 545 CU YDS, IS ALLOWED AS AN OVERBURN IN EXCAVATION. FOR DETAILS OF THESE STATIONS SEE PROJECT 640.

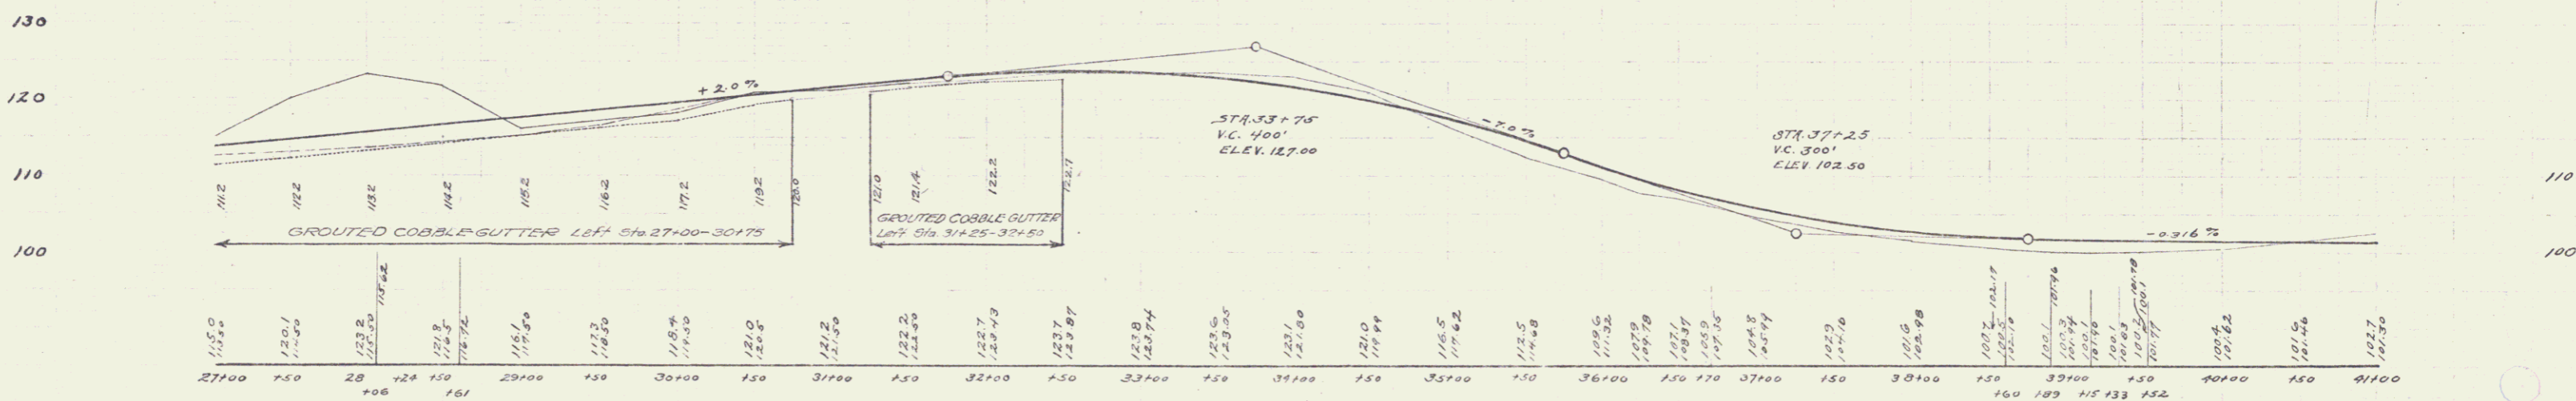

BM #12 20" Oak Left Sta 30181 Elev. 122.44
BM #20 5" Oak Left Sta 30136 Elev. 98.17

Series F 14878
Sheet 5 of 33