


Wood Guard Rail Required  
Right  
Sta 46100 to 47112 length 24ft  
Left  
Sta 46100 to 47112 length 24ft.

New Culverts Required  
Sta 47100 15" Round Cast Pipe length 33ft  
Cast Class 30(1-25-5)  
Reinf Steel 35.00


Proj. No.	Sub.	Proj. No.	Fiscal Year	Sheet No.	Total Sheets
9	VI	872	1927	6	33

CURVE  
D = 90-20 APPROX  
D = 20  
T = 233.9  
L = 466.7  
E = 96  
R = 2865.0

Miller's John Gould Shop

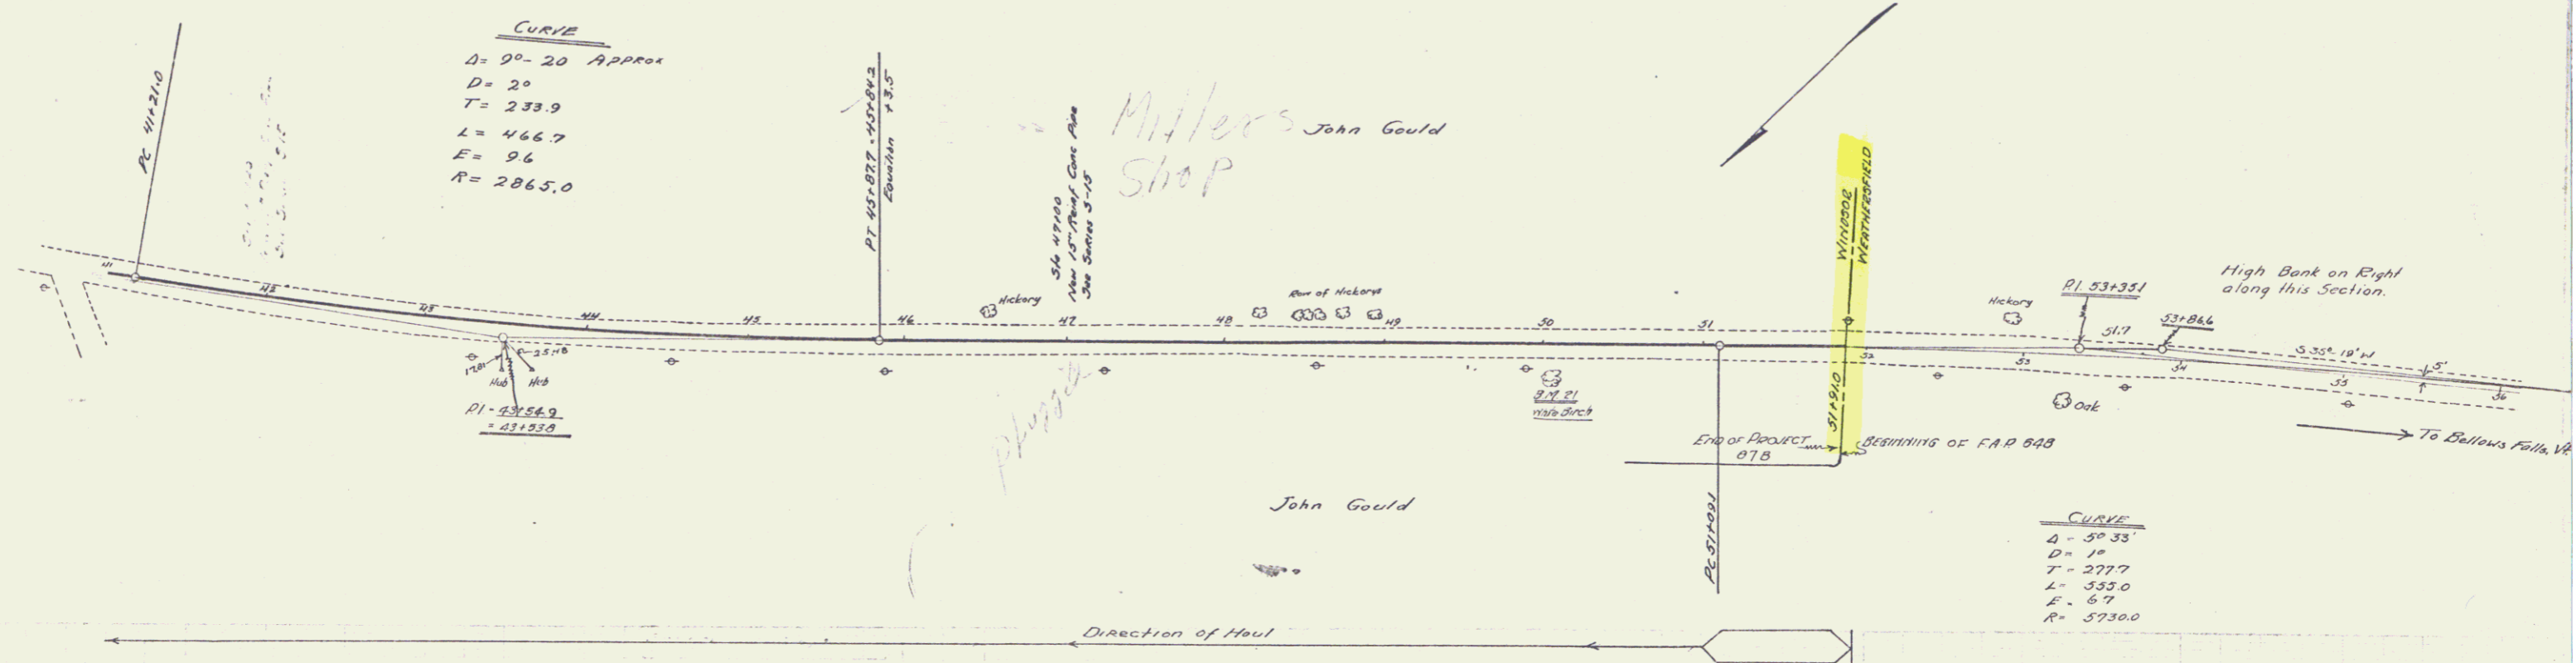

CURVE  
D = 50-35  
D = 10  
T = 277.7  
L = 533.0  
E = 67  
R = 5730.0

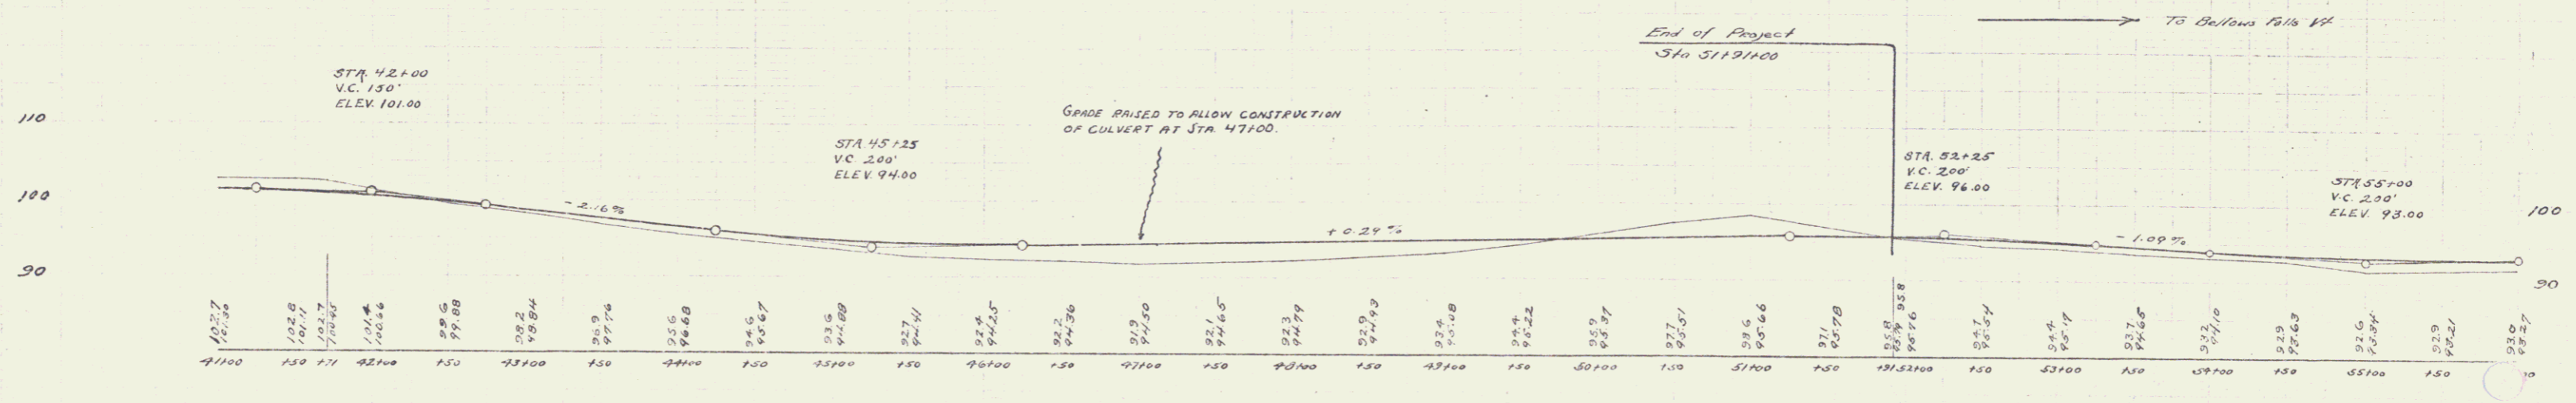

B.M. #21 White Birch RI Sta 50+00 ELEV. 100.38 - B.M. #21 FAD 648

James E. 1/28/28  
Sheet 6 of 33

5