



GUARD RAIL REQUIRED ON LEFT	NEW CULVERTS REQUIRED	SUB BASE REQUIRED	STANDARD UNDERDRAIN REQUIRED
Sta 15+00 to Sta 23+56 Length 856 ft. - 25+30 - - 30+00 - 470 -	Sta 22+40 18" Concrete Pipe 30 ft. 1-2-3 Concrete 15 cu yds	Sta 22+40.1 to 25+50 Length 309.9 ft. - 26+80 - 30+00 - 321.9 -	Sta 28+00 to 30+00 Length 200 ft.
ON RIGHT Sta 22+28 to Sta 22+52 Length 24 ft. - 25+38 - - 25+62 - 24 - - 29+34 - Sta 29+78 - 24 - TOTAL THIS SHEET 1398 ft.	Sta 25+30 2'-2" Concrete Box 38 1/2 ft. 1-2-4 Concrete 76 cu yds 1-2-5 - 9.5 -	* Elevation of Stationing = +13 ft. CONCRETE CURB REQUIRED Sta 28+00 to 30+00 Length 200 ft. 1-2-4 Concrete 3.1 cu yds * Elevation of Stationing = +19 ft.	

APP. ROAD DIST. NO.	STATE	FED. AID PROJ. NO.	FISCAL YEAR	SHEET NO.	TOTAL SHEETS
9	VT	38	24	4	20

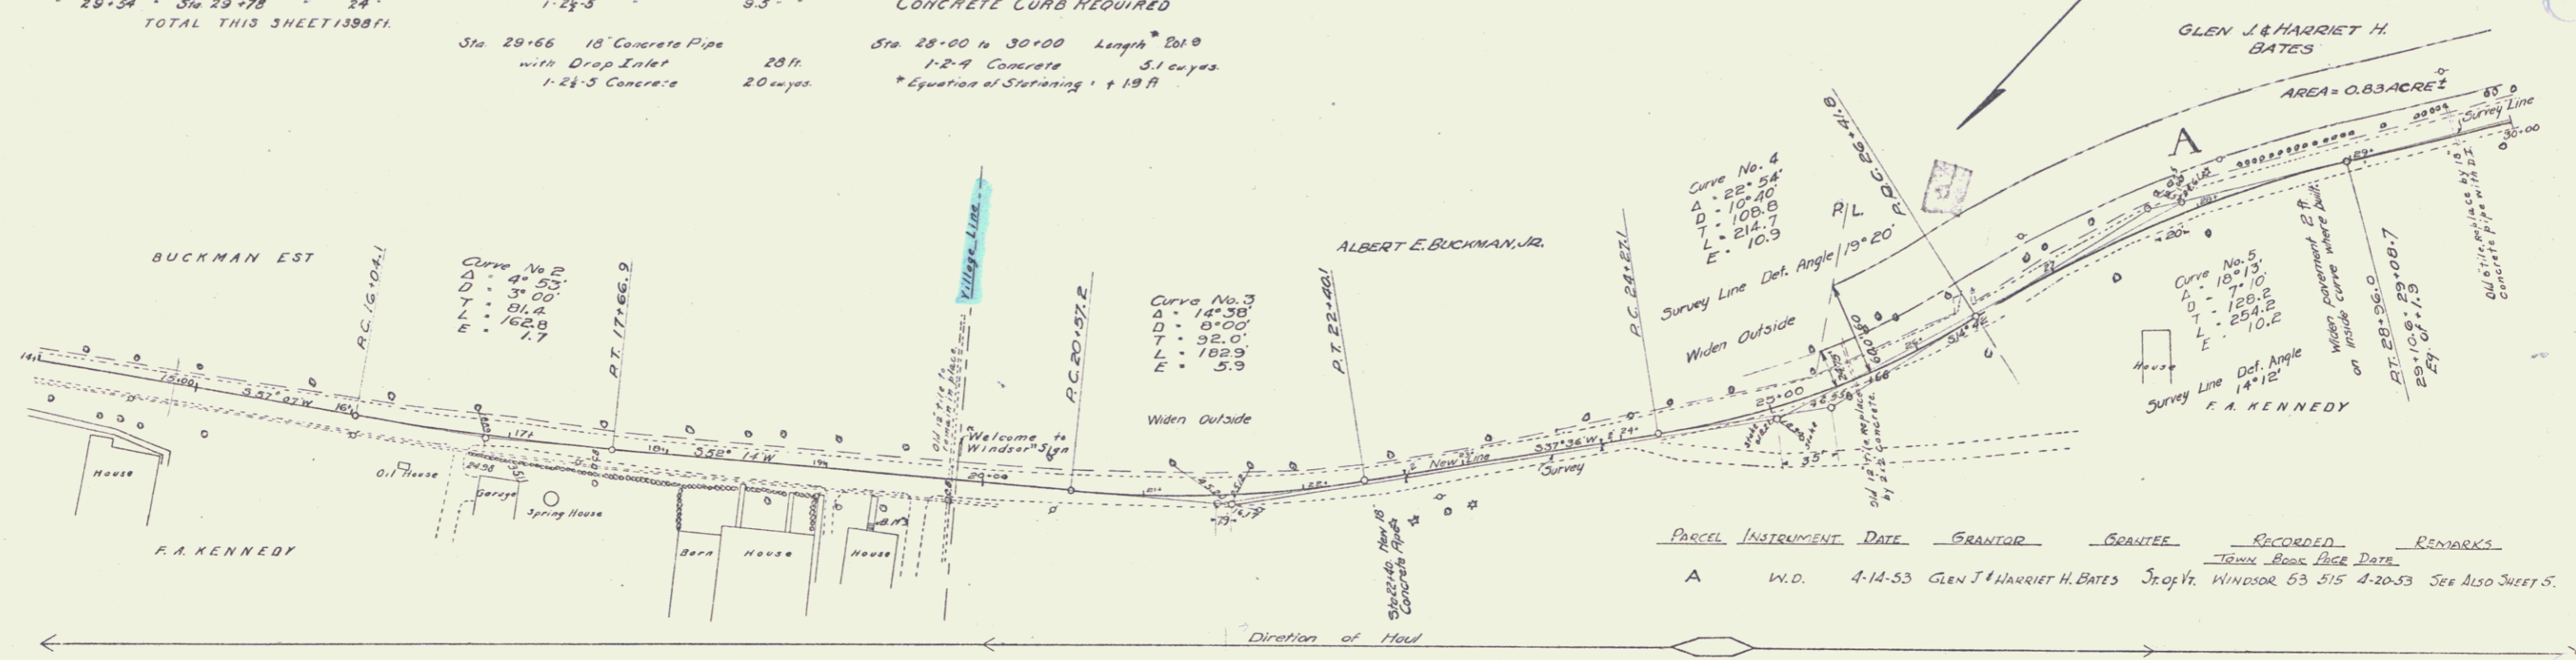

PARCEL	INSTRUMENT	DATE	GRANTOR	GRANTEE	RECORDED	REMARKS
A	W.D.	4-14-53	Glen J. & Harriet H. Bates	Jos. V. Windoor	53 515 4-20-53	See Also Sheet 5.

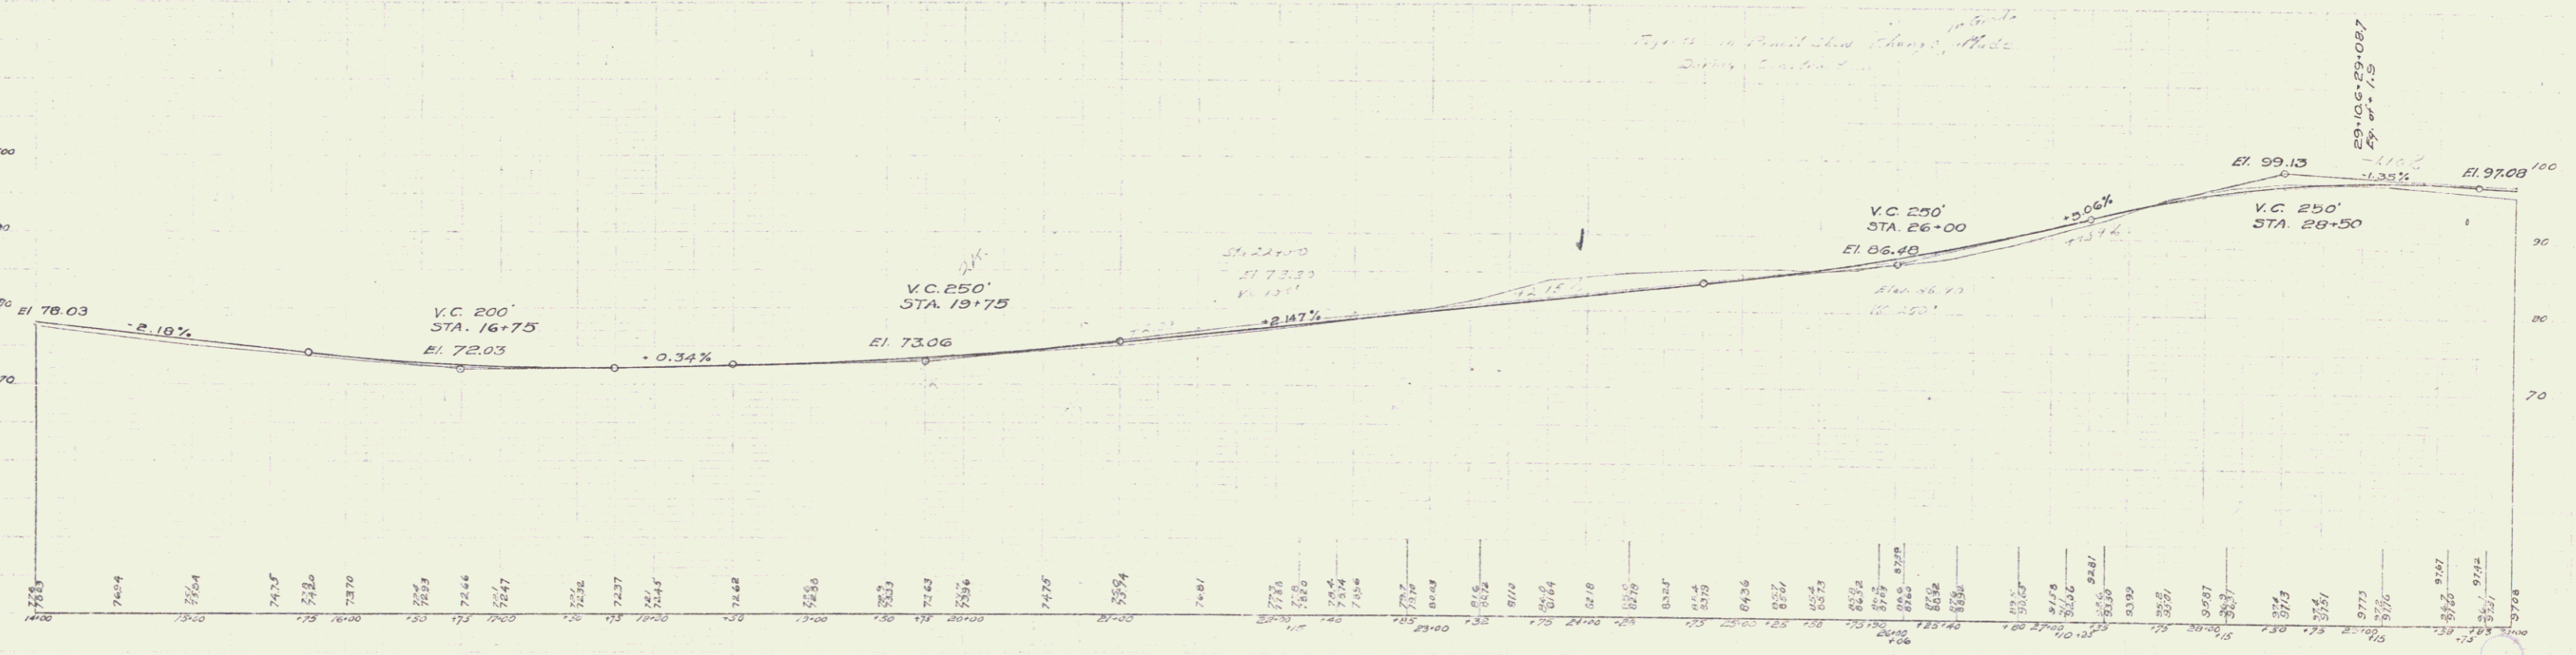

B.M. #3 S.E. Corner of bottom concrete step of house opposite Sta 19+36 El. 74.91

Series No. 38
Sheet 4 of 20