
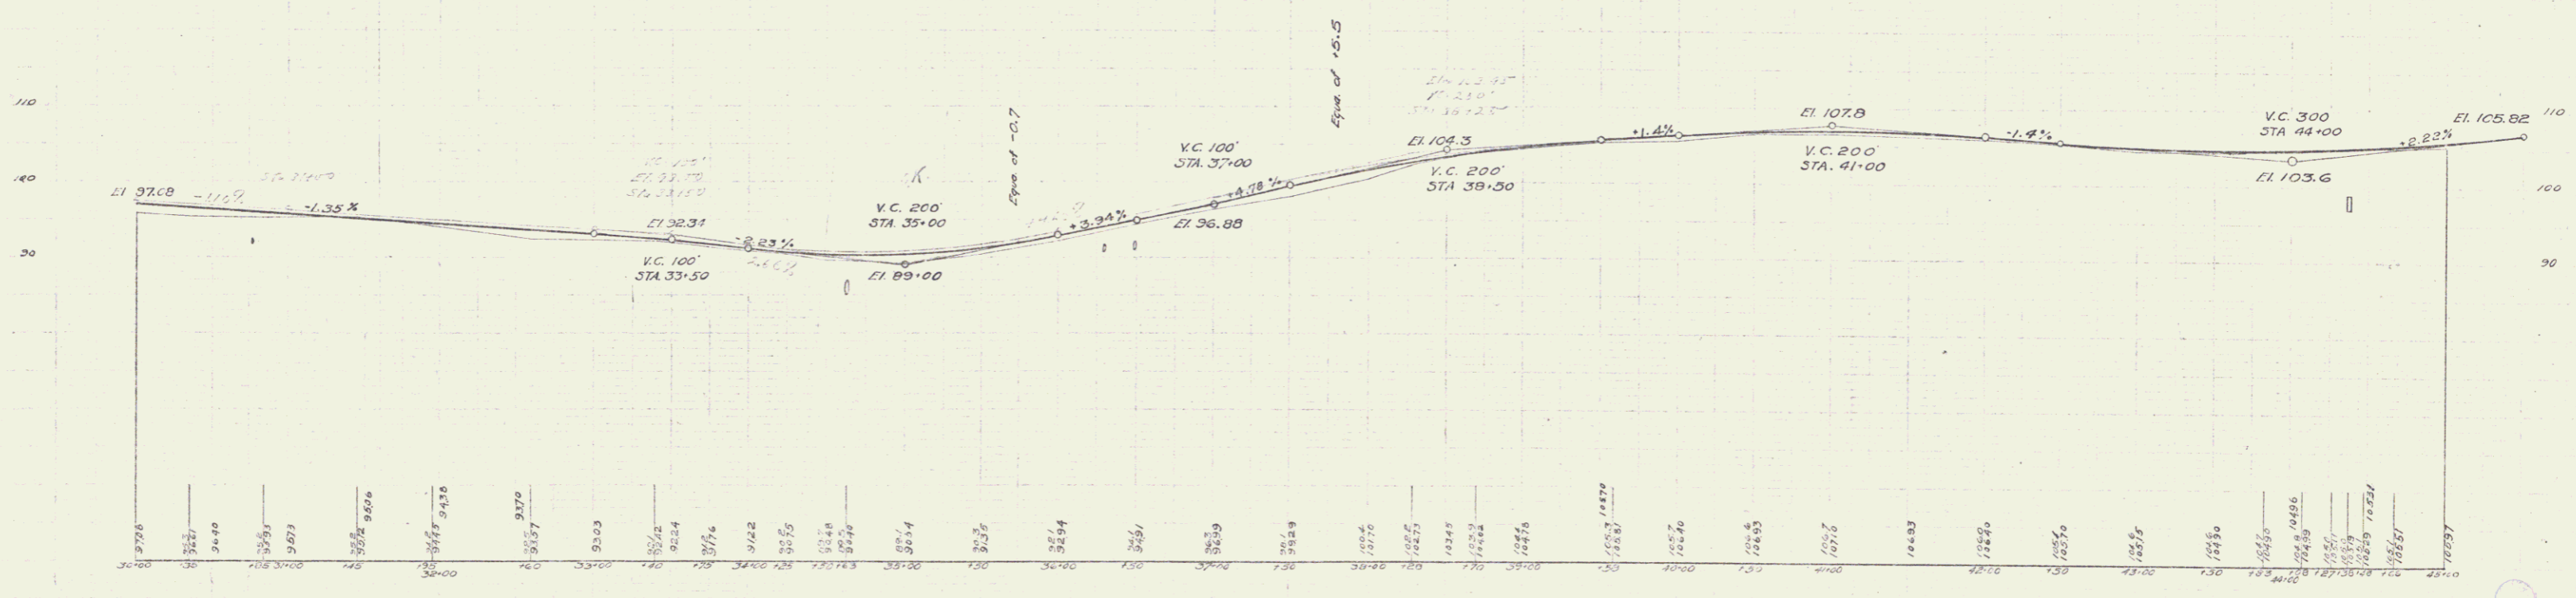


GUARD RAIL REQUIRED ON LEFT	NEW CULVERTS REQUIRED	SUB BASE REQUIRED	STANDARD UNDERDRAIN REQUIRED
Sta 30+00 to Sta 35+70 Length 570 Ft. - 36+12 - 36+36 - 24 - - 43+90 - 44+62 - 72 -	Sta 34+63 2'x2' Concrete Box 40 Ft. 1-2-4 Concrete 80 cu yds 1-2-5 - 97 -	Sta 30+00 to 32+00 Length 200 Ft. - 35+30 - 38+50 - 304 cu yds. - Equation of Stationing - +0.5 Ft. - -0.7 Ft.	Sta 30+00 to 34+50 Length 450 Ft.
ON RIGHT Sta 34+51 to Sta 39+75 Length 24 Ft. - 36+38 - 36+62 - 24 - - 44+10 - 44+38 - 48 -	Sta 36+40 2'x2' Concrete Box 40 Ft. 1-2-4 Concrete 80 cu yds 1-2-5 - 97 -	CONCRETE CURB REQUIRED Sta 30+00 to 33+60 Length 360 Ft. 1-2-4 Concrete 90 cu yds.	
TOTAL THIS SHEET 762 Ft.	Sta 44+38 3'x3' Reinforced Concrete Box 74 Ft. 1-2-4 Concrete 151 cu yds. 1-2-5 - 228 - Reinforcing Steel 470 lbs.		

JOB NO.	STATE	FILE NO.	SCALE	SHEET NO.	TOTAL SHEETS
3	VT	38	2 B	5	20

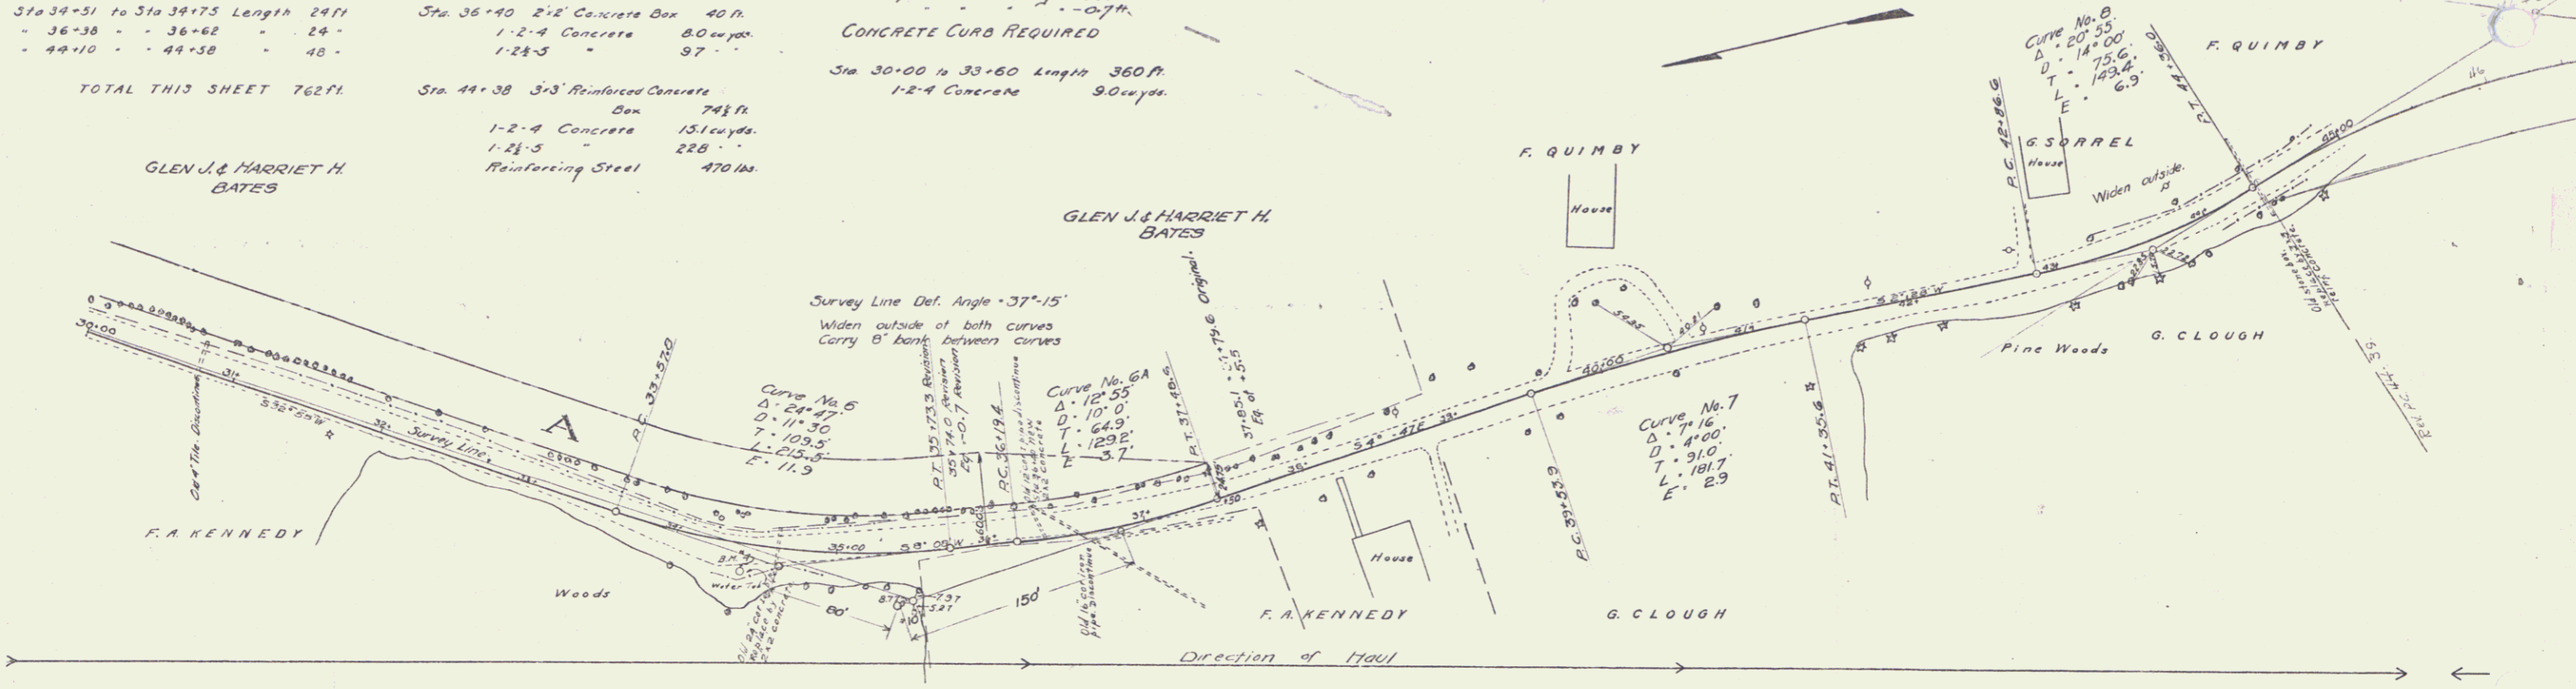

B.M. "A" Top of east edge of water tub on right of Sta 34+00. Elev 99.31