

**WOOD GUARD RAIL REQUIRED**

Station	Left	Right
206178	24	24
213118	24	-


**CABLE GUARD RAIL REQUIRED**

Station	Left	Right
213118	-	48

**NEW CAST IRON PIPE COLLECTORS REQUIRED**

Station	Diam	Length	Concr	Conc C	Steel
206178	15"	36'	-	2364	33'

DIST. NO.	STATE	FED. AID	FISCAL YEAR	SHEET NO.	TOTAL SHEETS
0	VT	76CE	1930	50	97

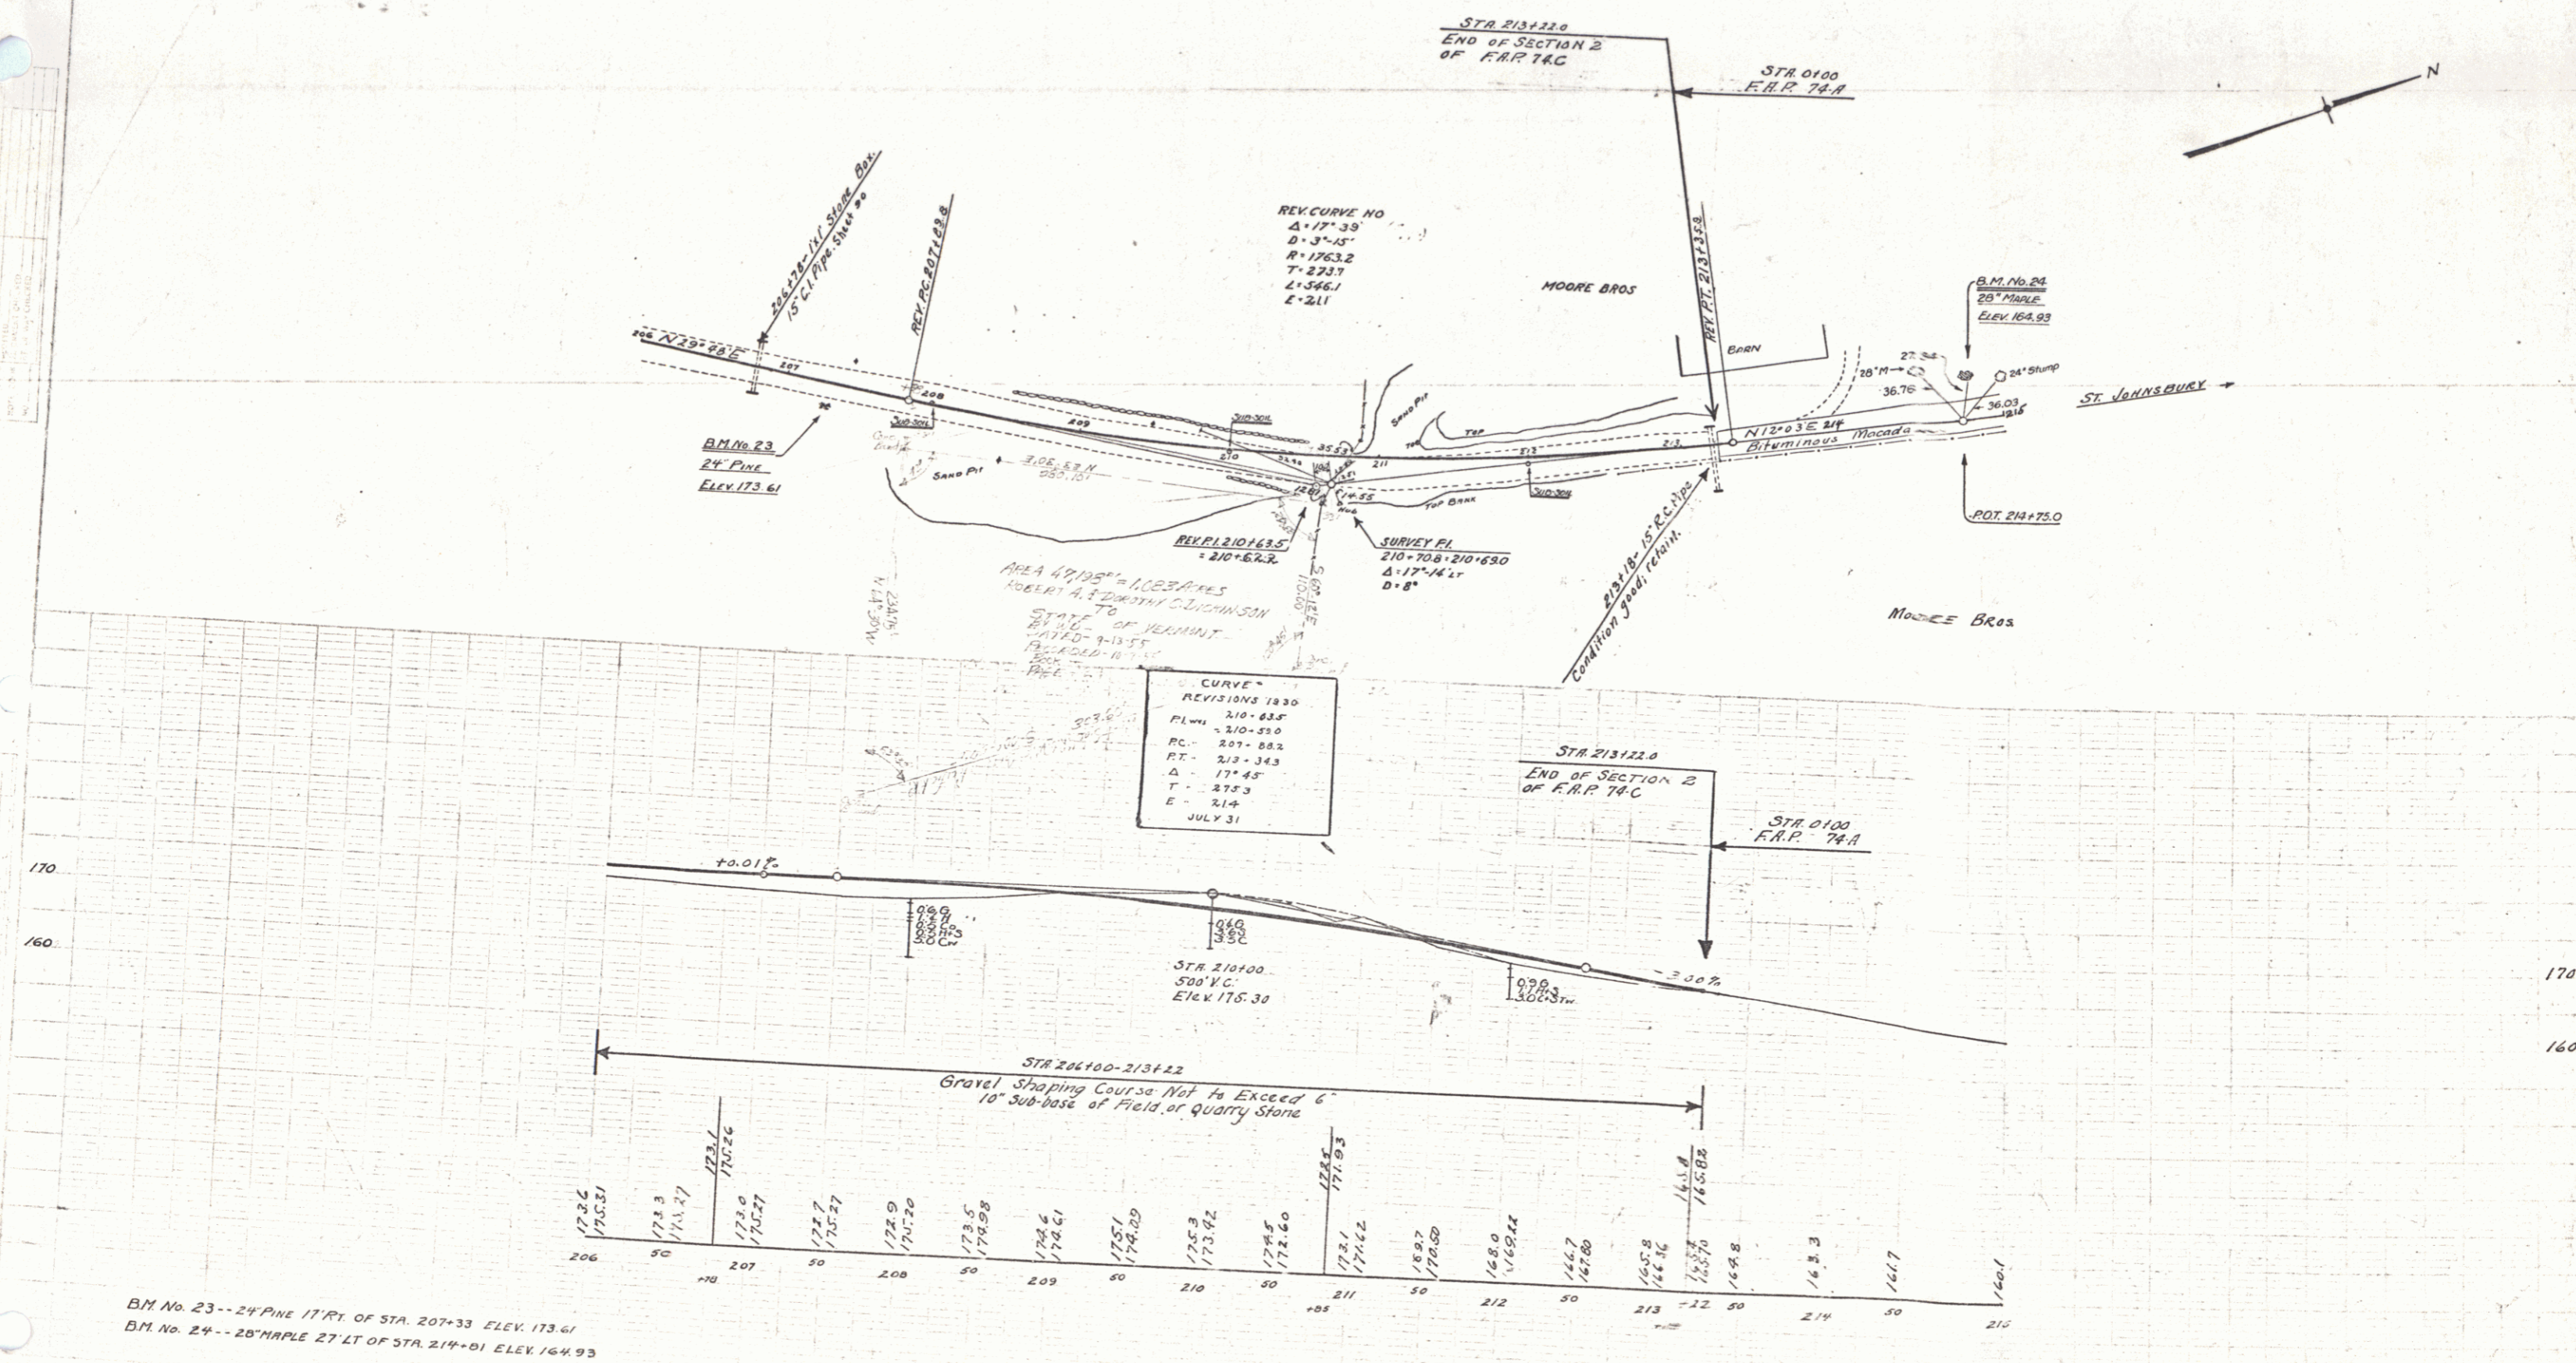

BM No. 23--24 PINE 17 RT. OF STA. 207+33 ELEV. 173.61  
 BM No. 24--25 MAPLE 27 LT. OF STA. 214+01 ELEV. 164.93