

WOOD GRASS RAIL REQUIRED

Convent Station	Lt.	Rt.
91+00	24	24
79+50	24	24

CABLE GUARD RAIL REQUIRED

Stations	Lt.	Rt.
91+75-94+47	-	272
83+80-84+84	-	104
85+76-86+00	-	24

NEW REIN. CONC. PIPE CULVERT REQUIRED


Station	Diam.	Length	Conc.	Steel
91+00	18"	36'	3.0 cy	33 lbs
79+30	18"	44'	3.0 cy	33 lbs

GRAVEL CABLE CUTTER REQUIRED

Stations	Lin. Feet	Area
83+15-85+85	270 ft	90 sq. yd.

See note-sheet #

STATE OF FLORIDA
 DISTRICT OF ...
 135 1923 10 37

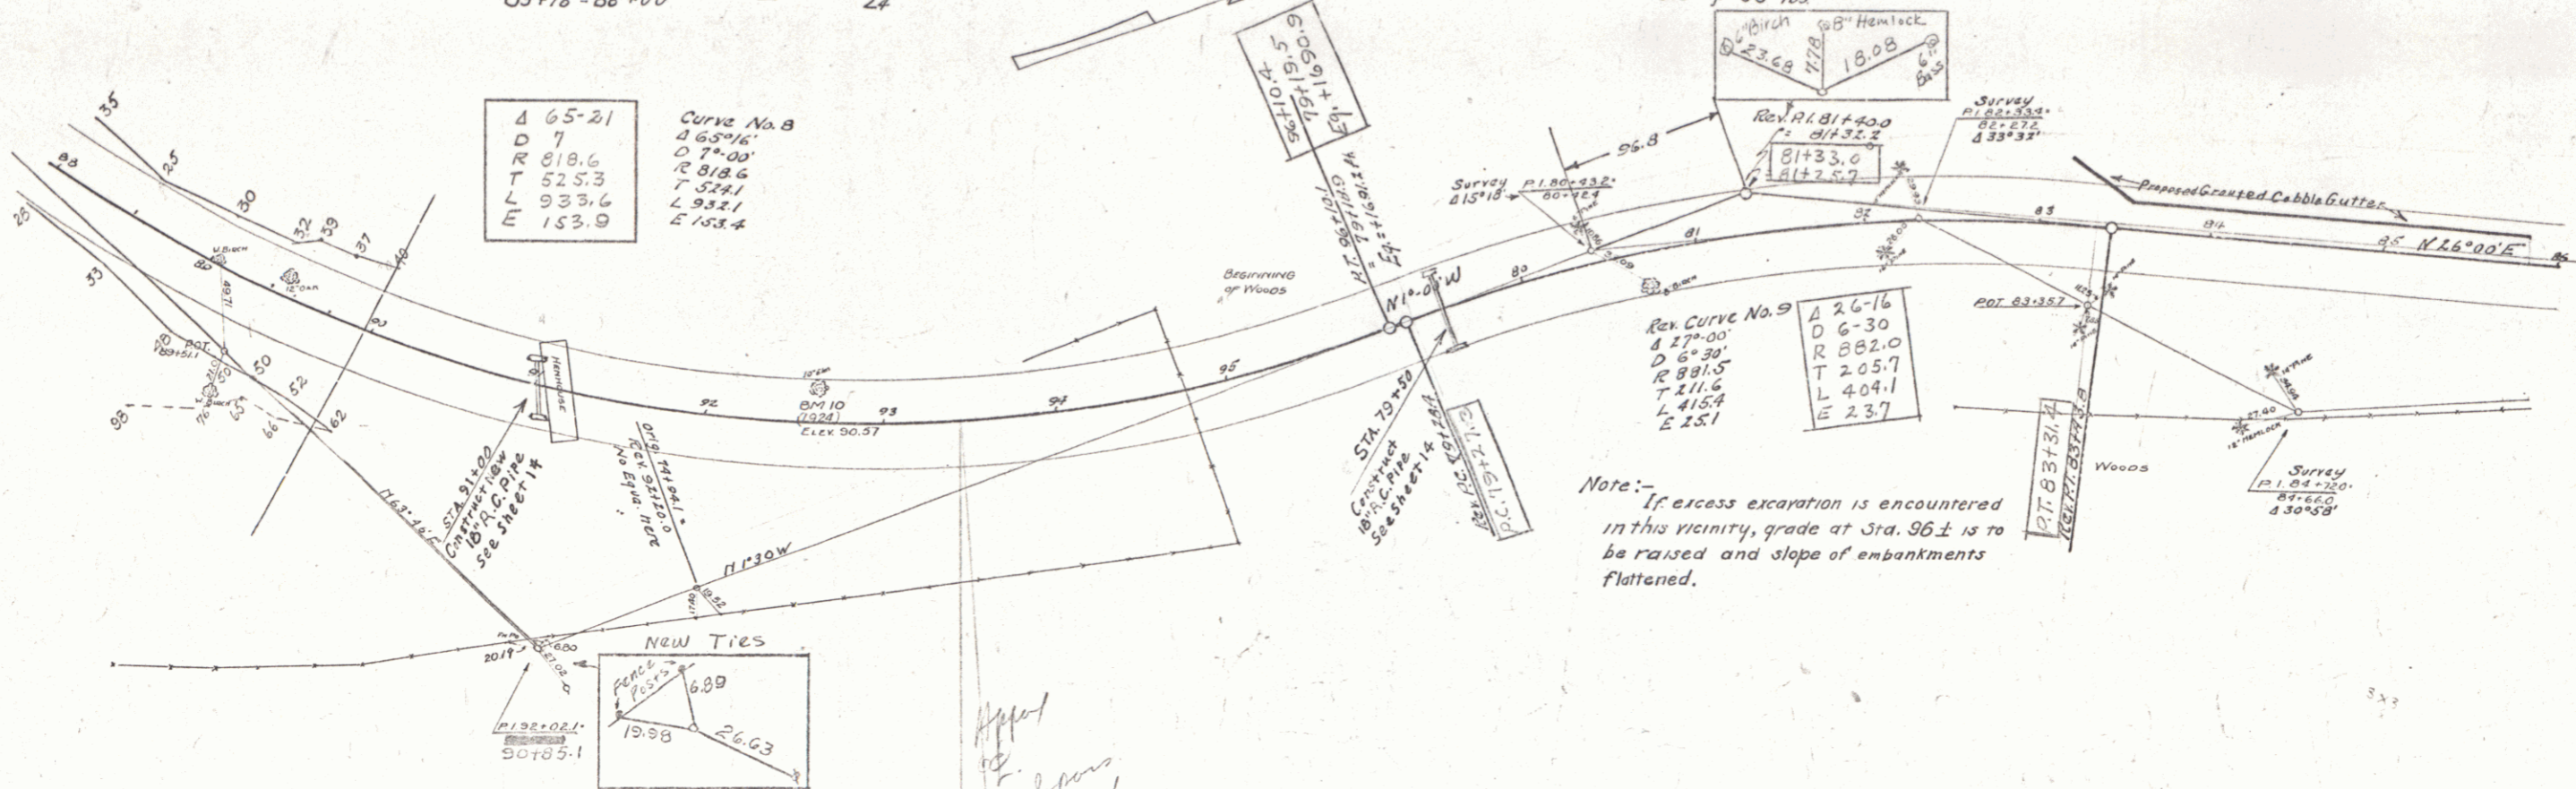

Note: If excess excavation is encountered in this vicinity, grade at Sta. 96± is to be raised and slope of embankments flattened.

