


Sheet 2E
RIGHT OF WAY PLANS - FEDERAL AID PROJ. NO. 74A
PROPERTY C. KENT
PARCEL A - TOH. RYEGATE
PARCEL B - TOH. OF BARNET.

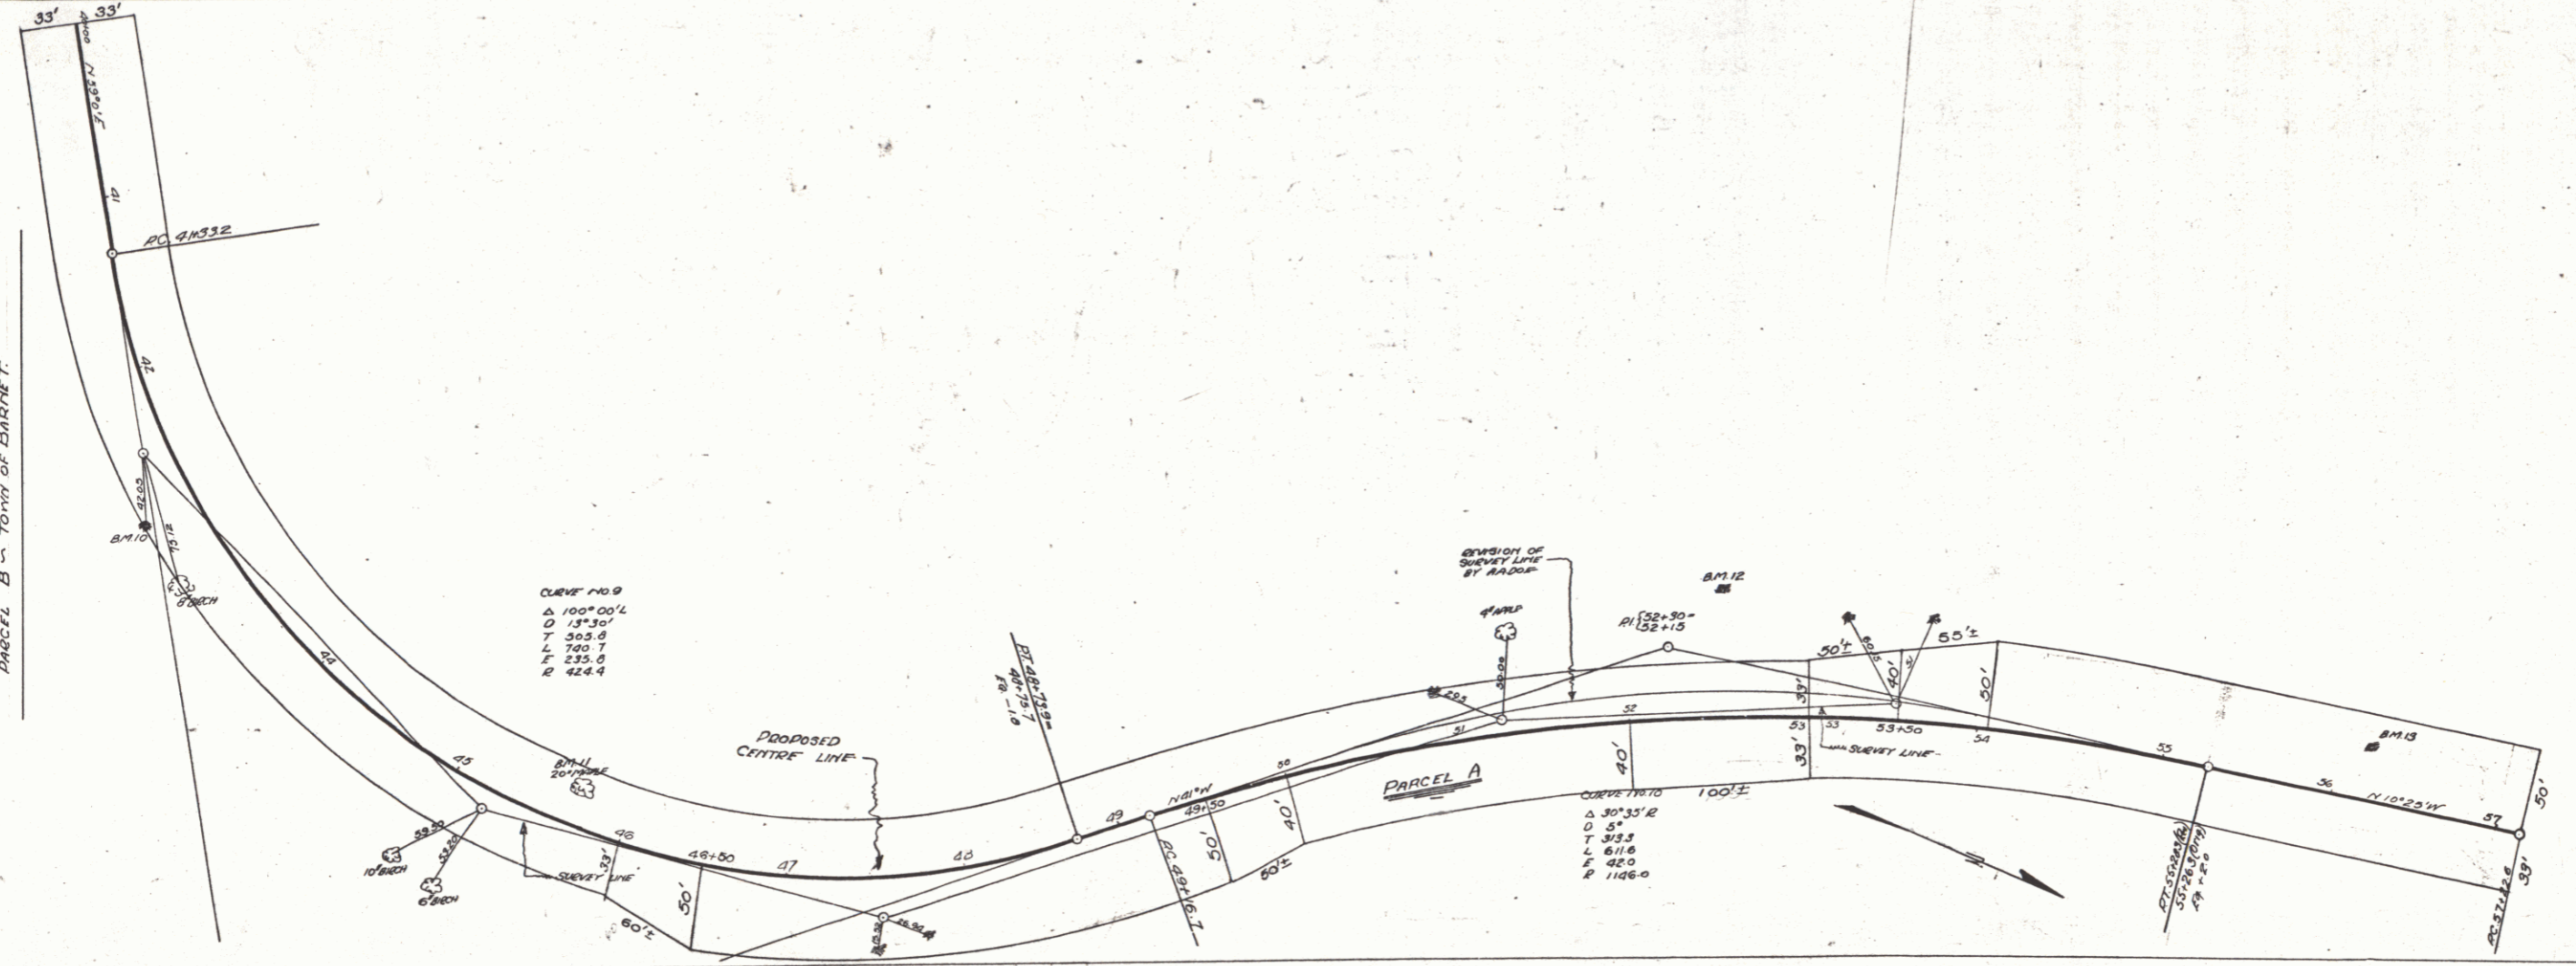

SHEET 2E

6