

PLAN
 DATE 8/24
 DRAWN BY THOMAS
 CHECKED BY MILLER
 NO. 7/04

PROFILE
 DATE 8/24
 DRAWN BY MILLER
 CHECKED BY MILLER
 NO. 7/04

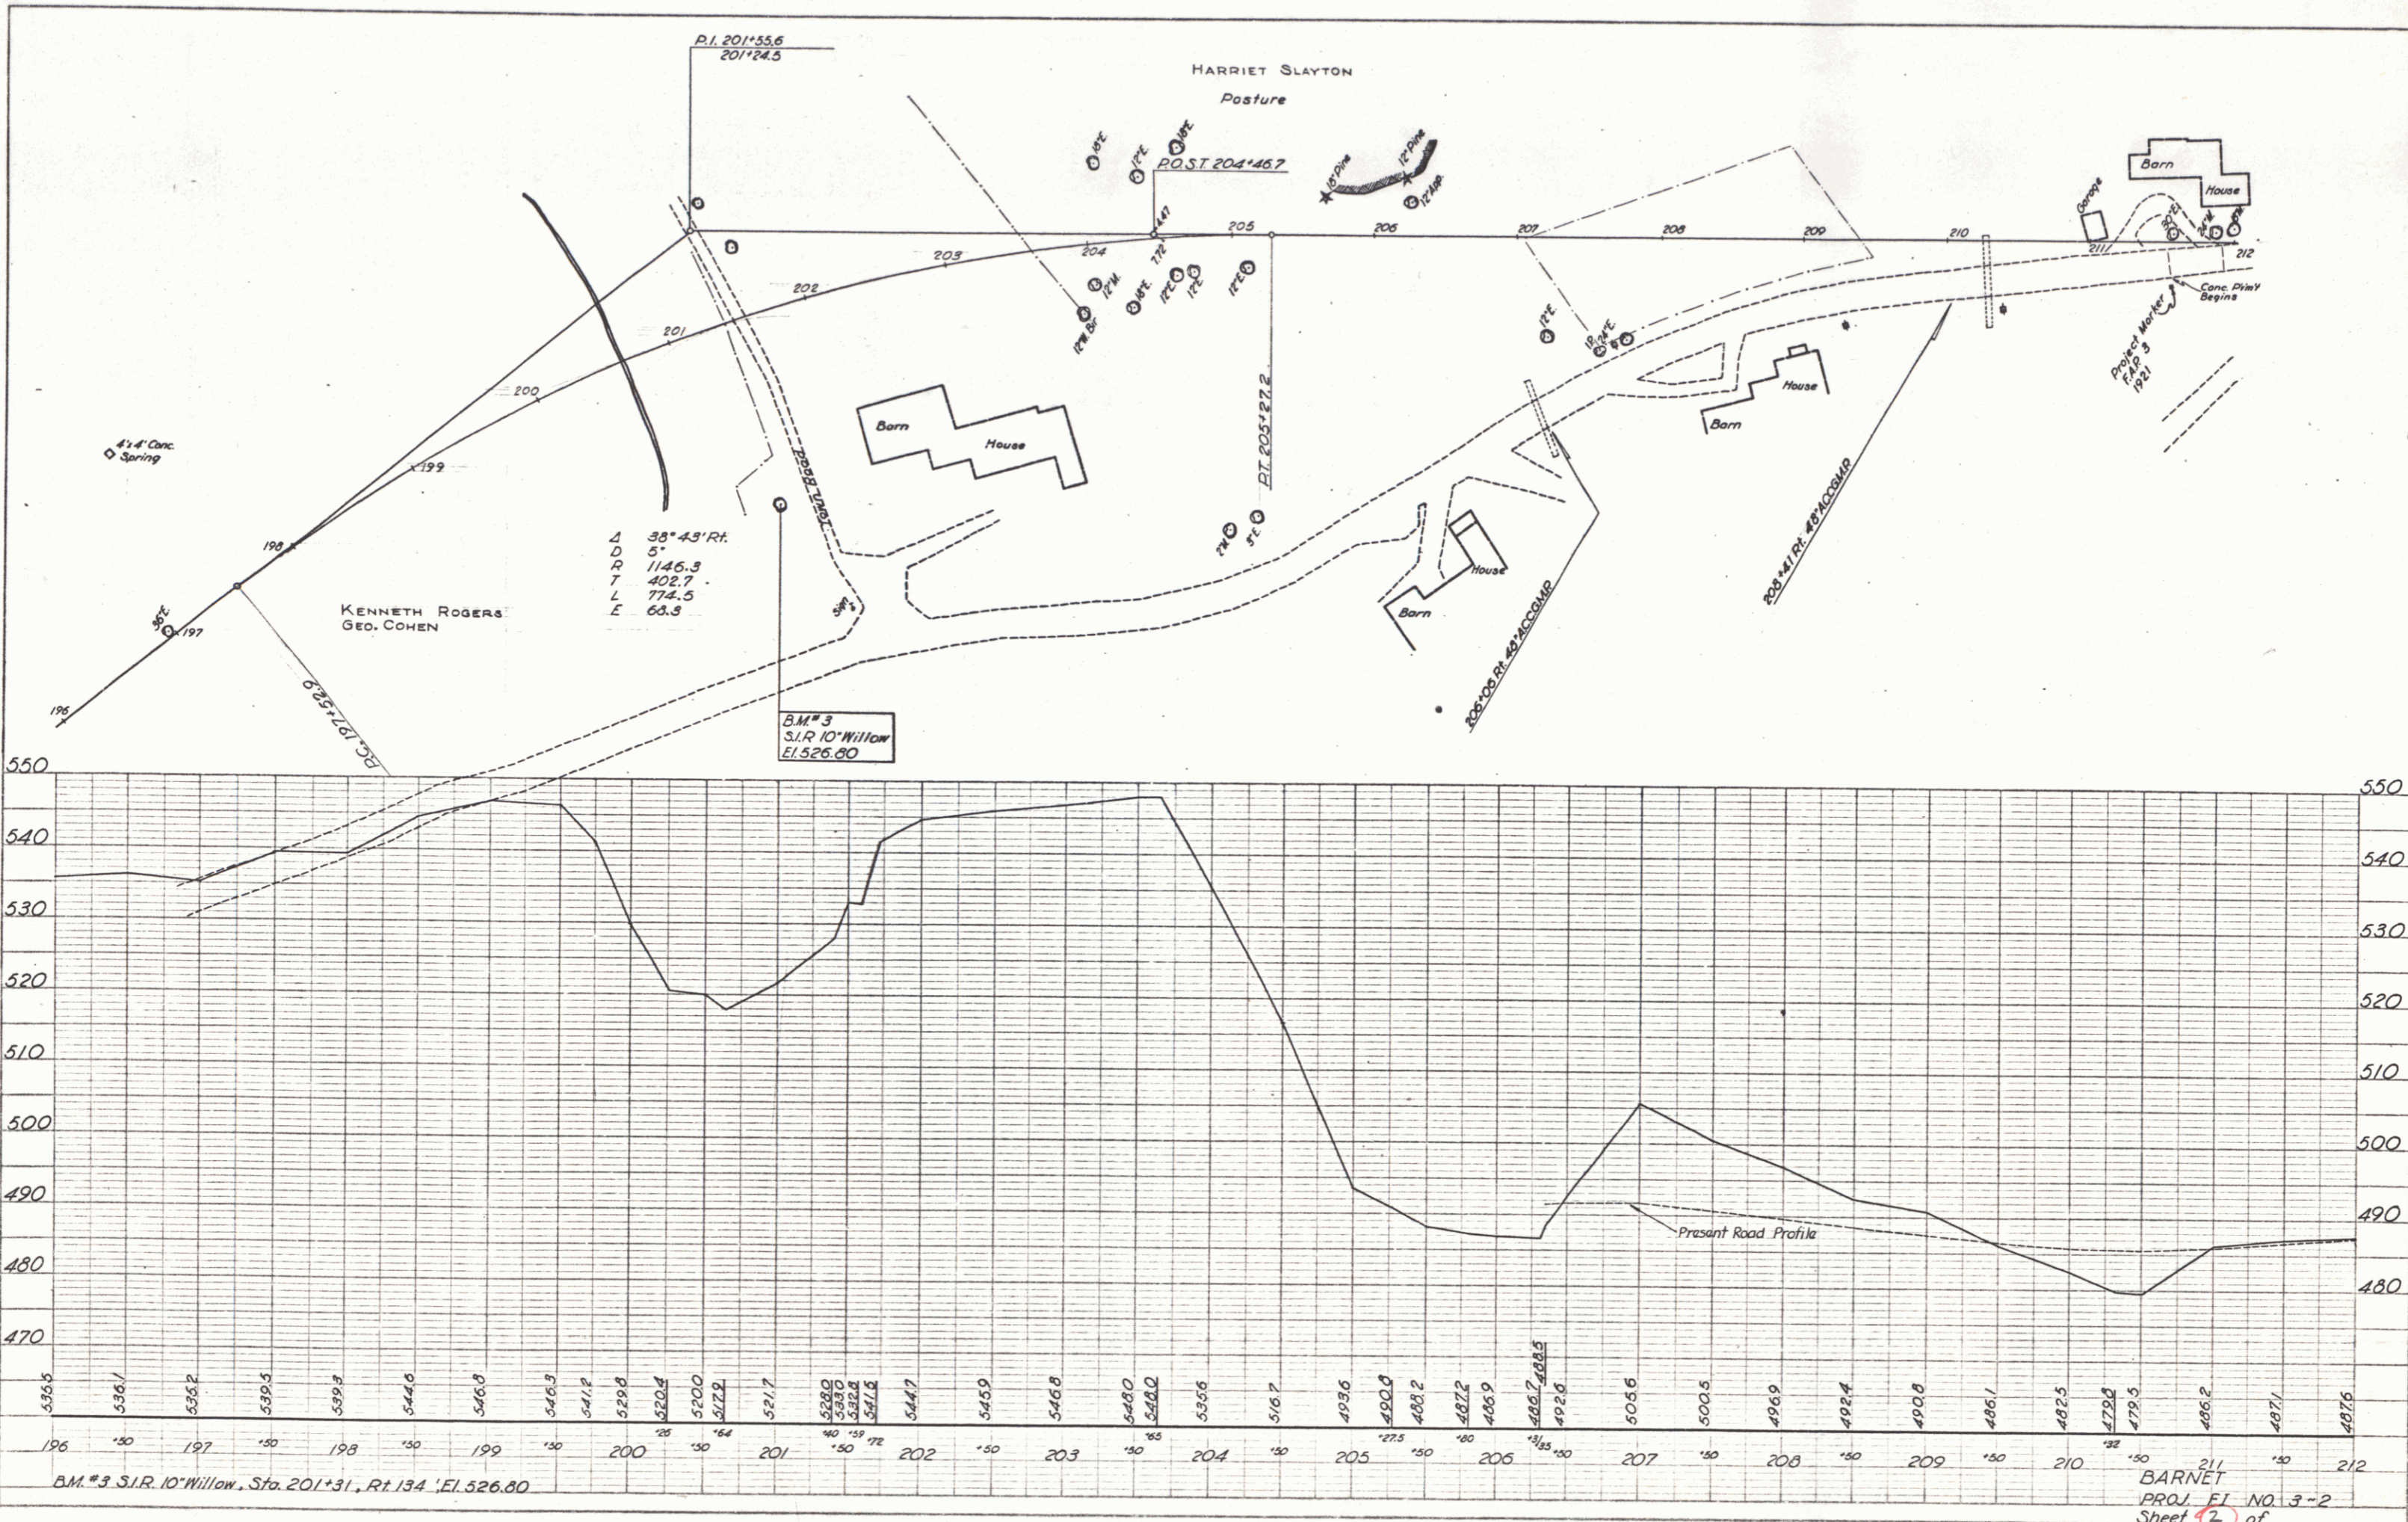


PLATE 1 - FULL PROFILE OF P. & H. STATIONS
 HOFFEL & SONS CO. NEW YORK
 1/2" = 100' HORIZ. SCALE
 1" = 10' VERT. SCALE