
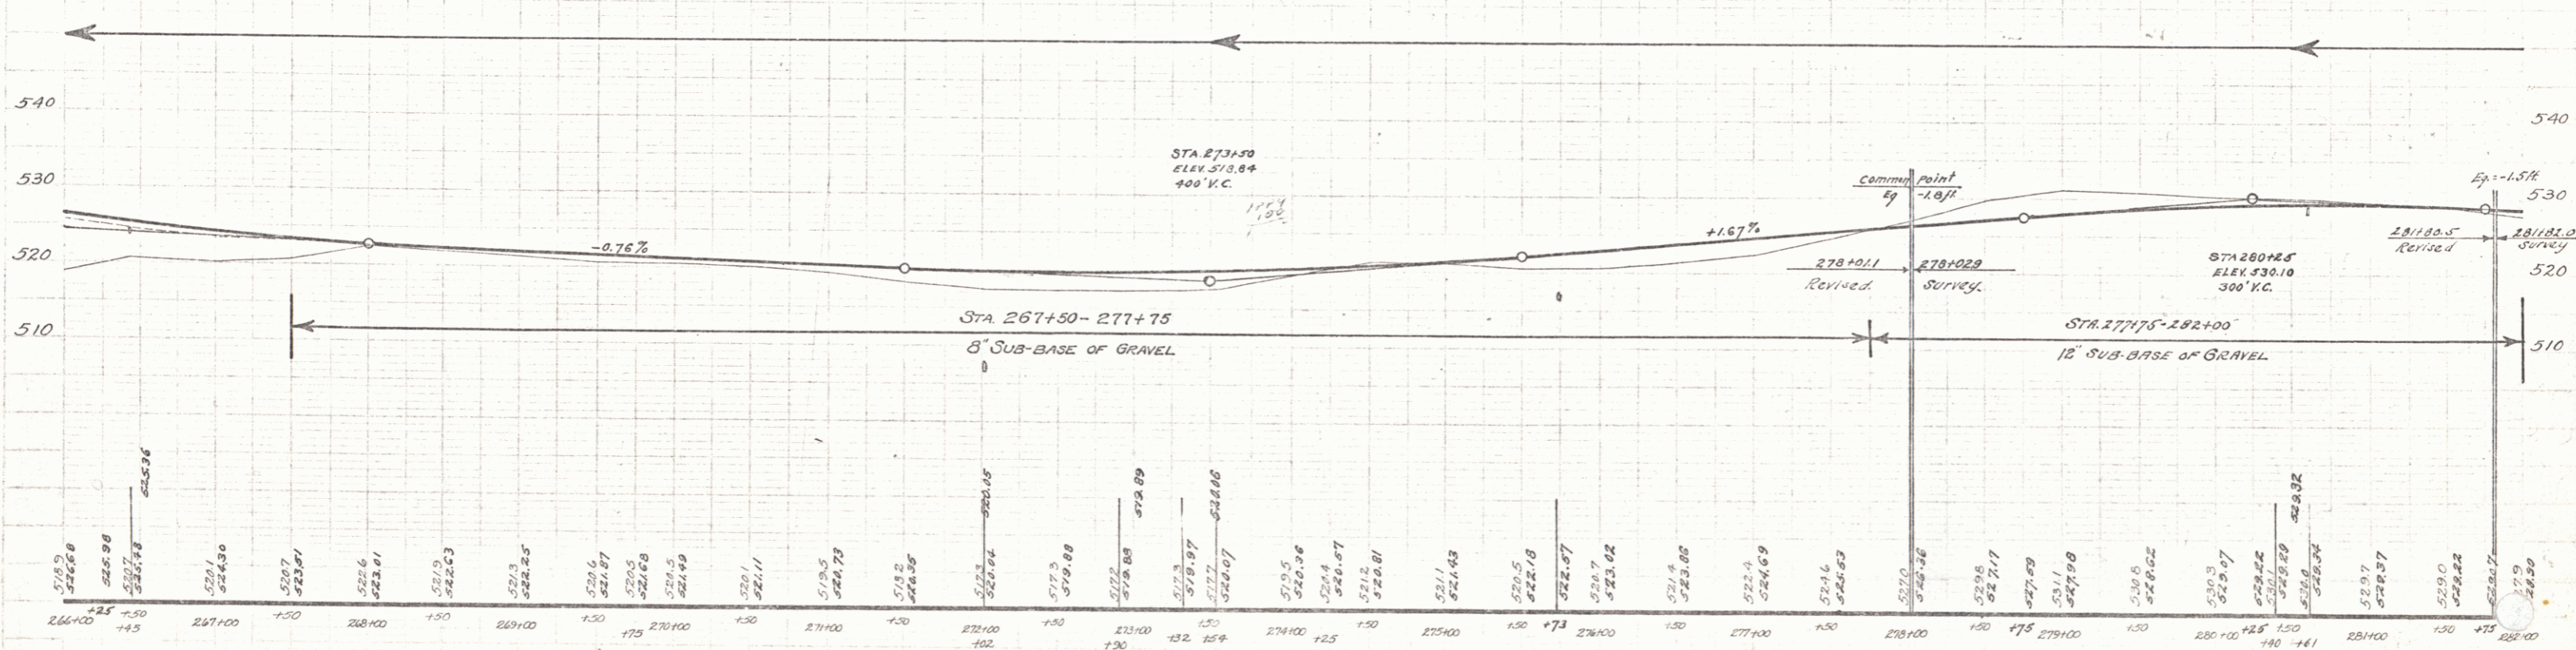


WOOD GUANO RAIL REQUIRED			CABLE GUANO RAIL REQUIRED			NEW CAST IRON PIPE CULVERTS REQUIRED		
Culvert Station	Width	Length	Stations	Width	Length	Station	Diam.	Length
272102	24	-				272102	18"	45
275173	24	24	271100-273+00	200'	-	275173	18"	39
280160	24	24				280160	18"	36

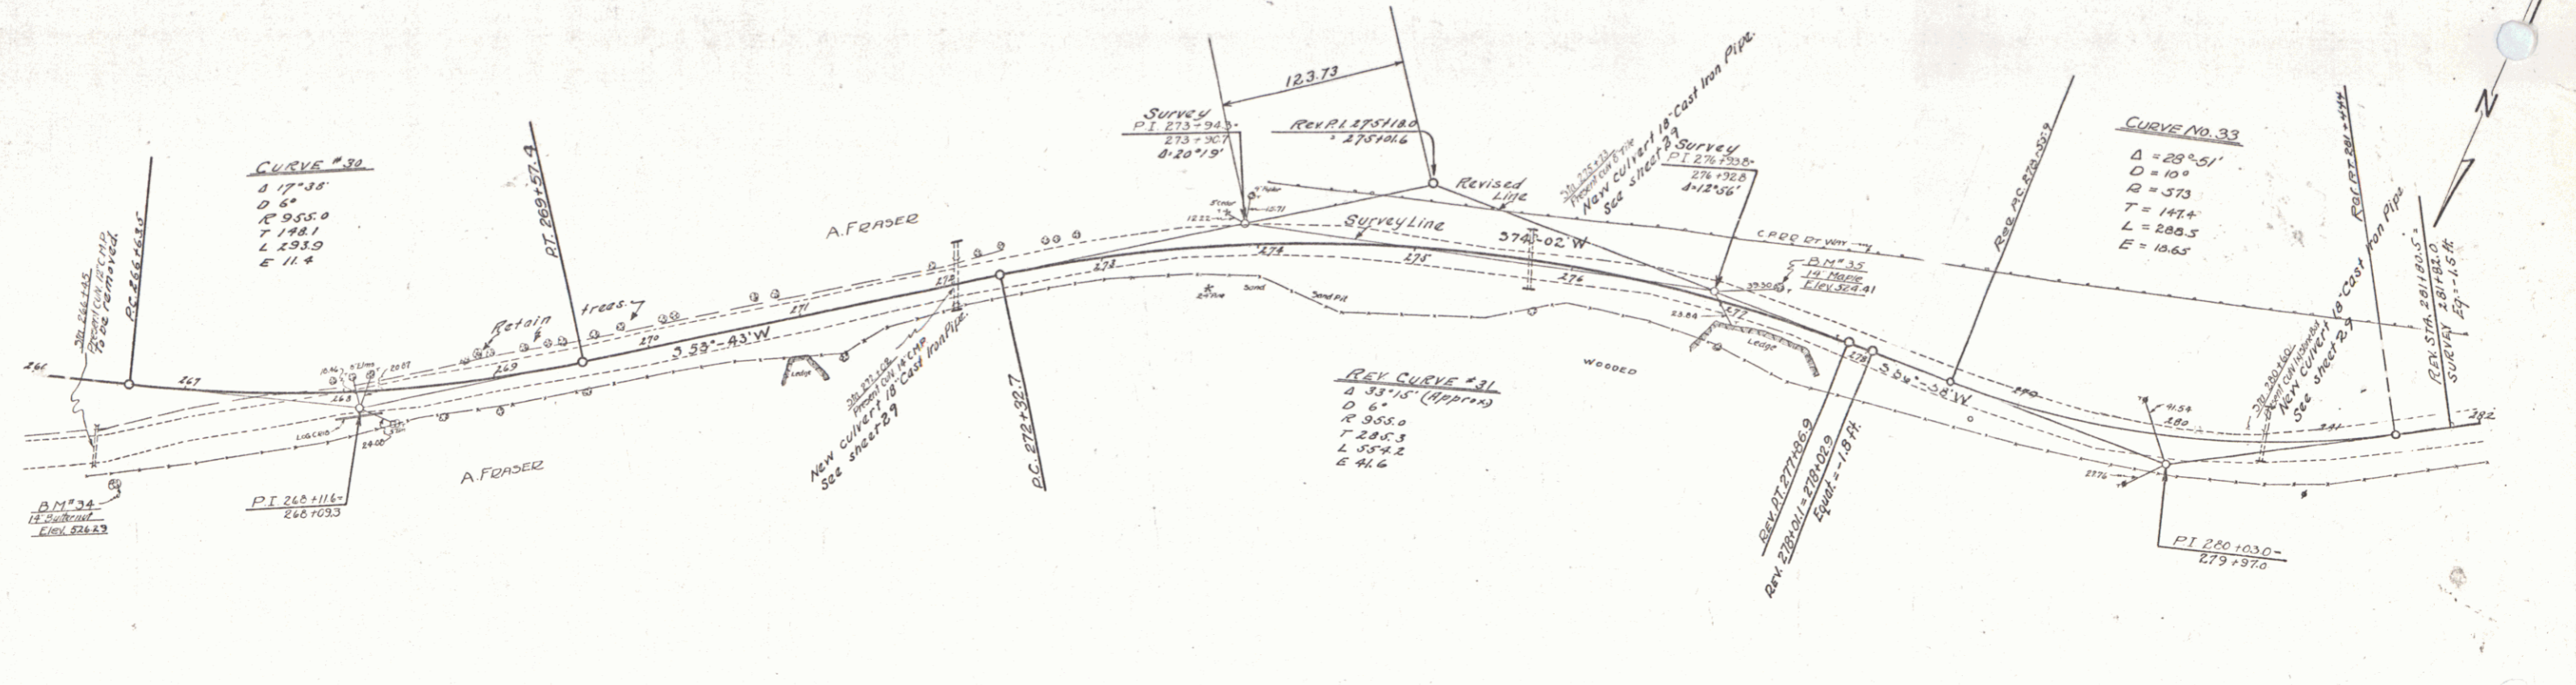

DM # 34 SPIKE IN FOOT OF 14" BUTTERNUT, 62 FT. E. OF STA 266+60 - ELEV 526.29
 DM # 35 SPIKE IN FOOT OF 14" MAPLE, 17.5 FT. E. OF STA 277+51 - ELEV 524.41

Series # 15-B
 Sheet 17 of 19

E. D. Wood
 E. Flanagan
 1928
 1925
 1928