
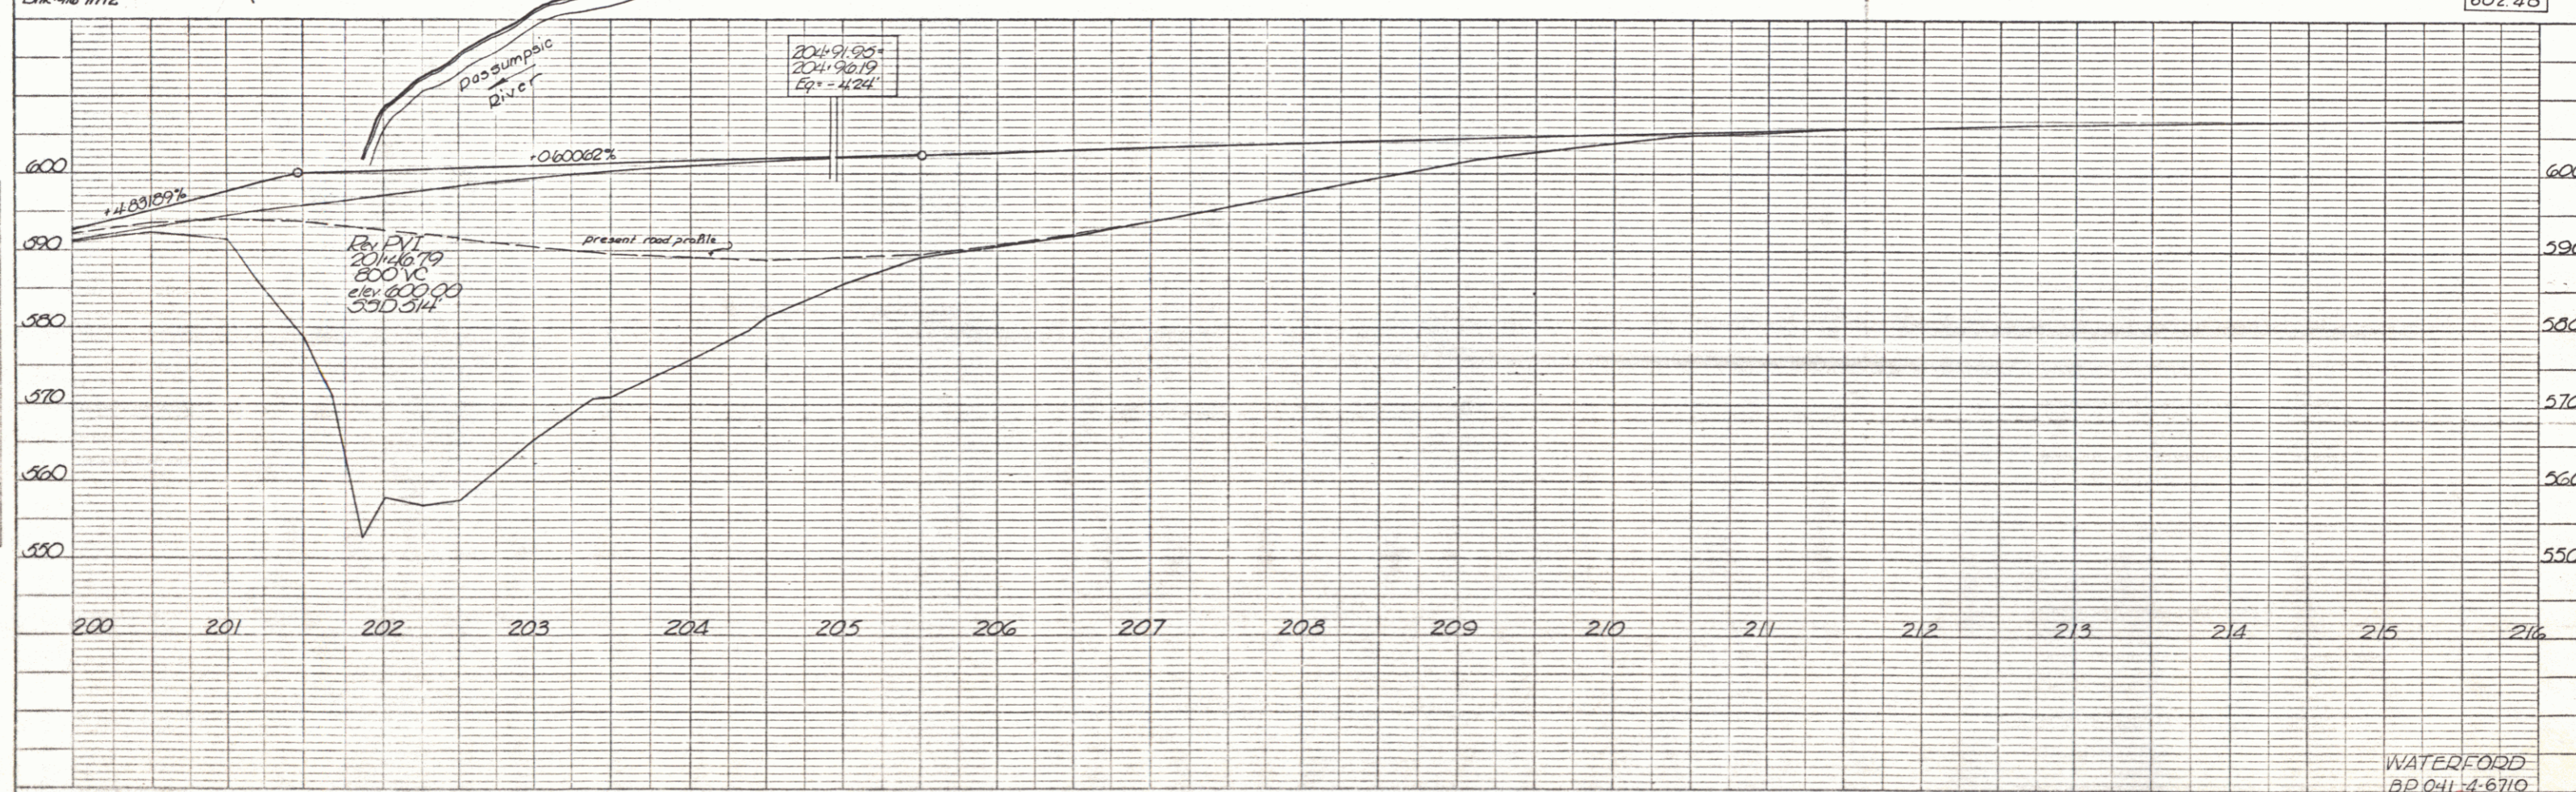


PLAN  
 DRAWN BY: Smith  
 CHECKED BY: [blank]  
 DATE: 11/86  
 SCALE: 1" = 40'

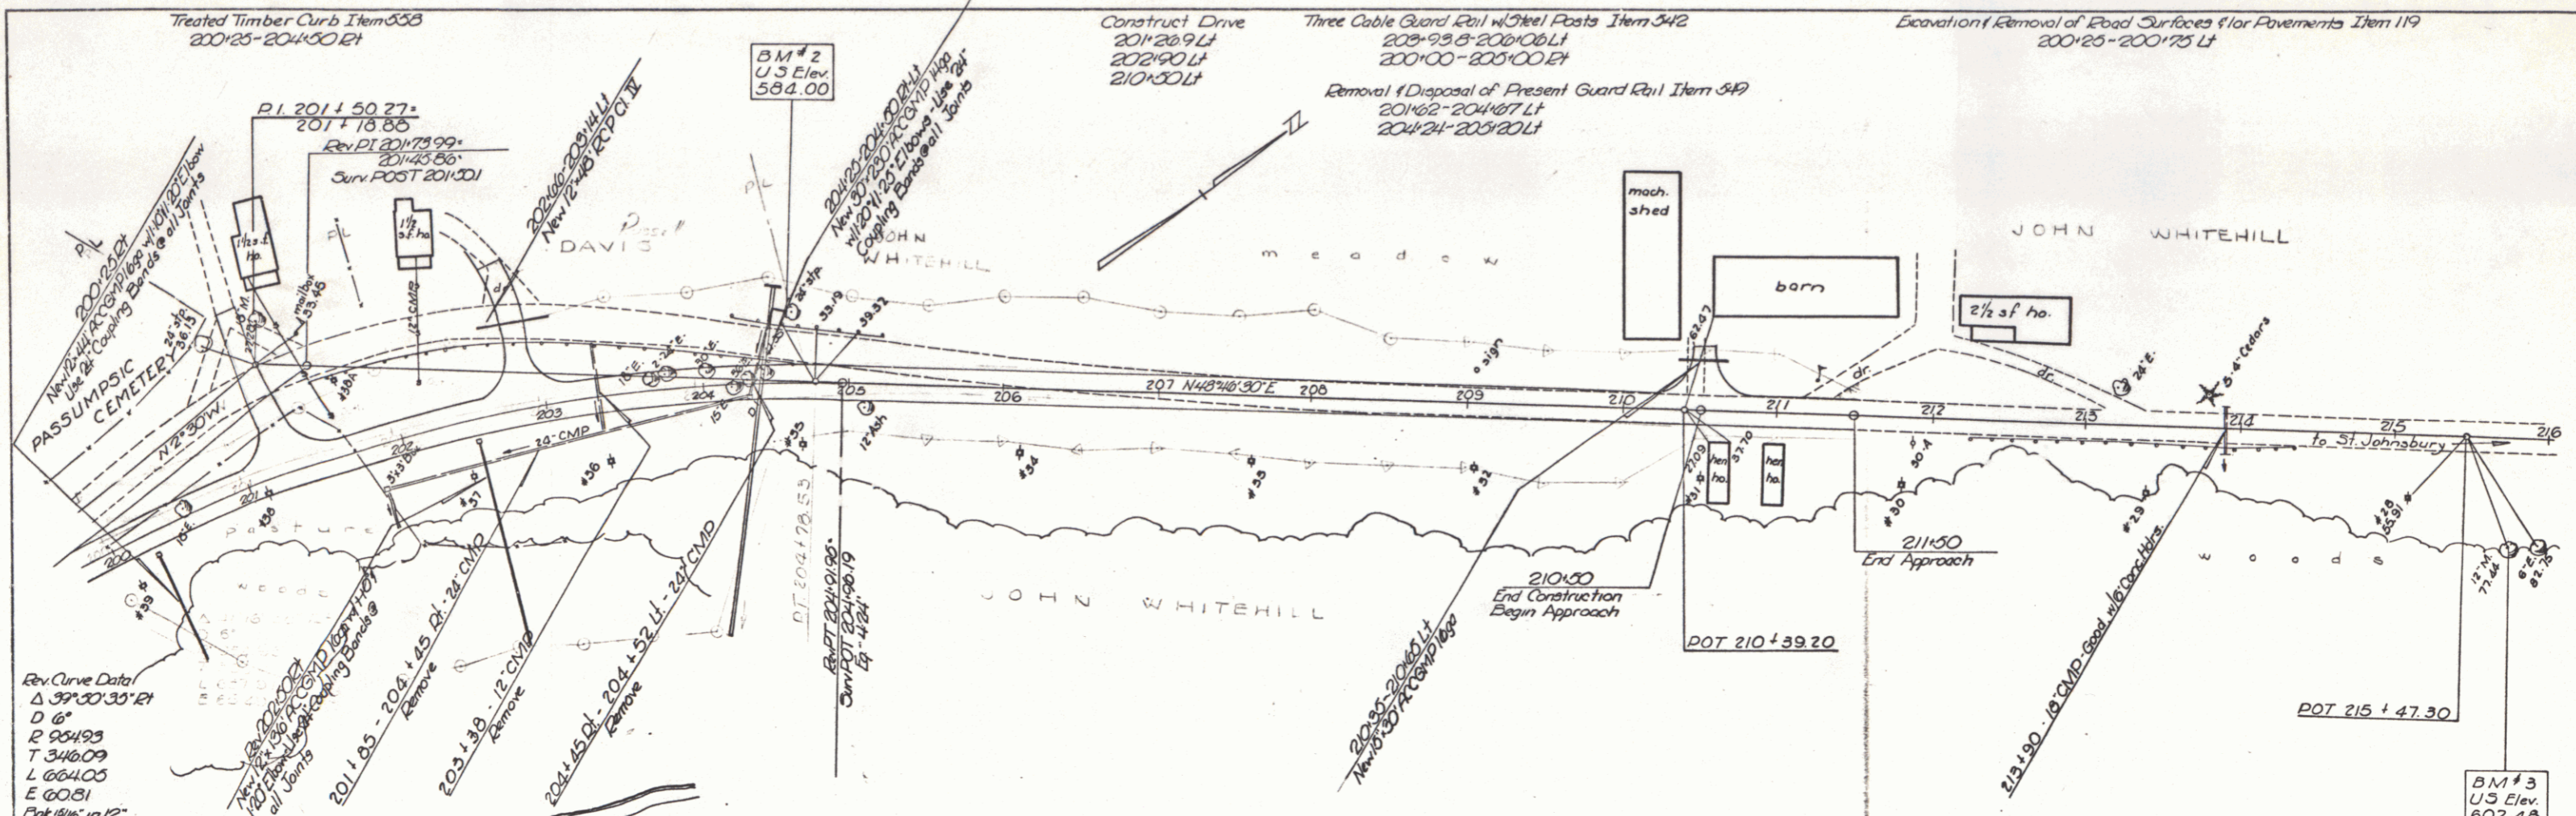

PROFILE  
 DRAWN BY: Smith  
 CHECKED BY: [blank]  
 DATE: 11/86  
 SCALE: 1" = 40'

Rev. Curve Data  
 Δ 391.00.35.21  
 D 6°  
 R 904.93  
 T 346.09  
 L 664.05  
 E 608.81  
 Chk 1/16" in 12"