


STATE OF VERMONT TO
 ALICE G. CALKINS BY
 QCD RECORDED 5/8/75
 IN BK 152/6-B

CVPS to State of VT
 QCD for an easement of
 ingress + egress for
 CALKINS, ALICE G.
 removing borrow, sand + gravel
 dated 6/23/42 BK 216 Pg 520, 521

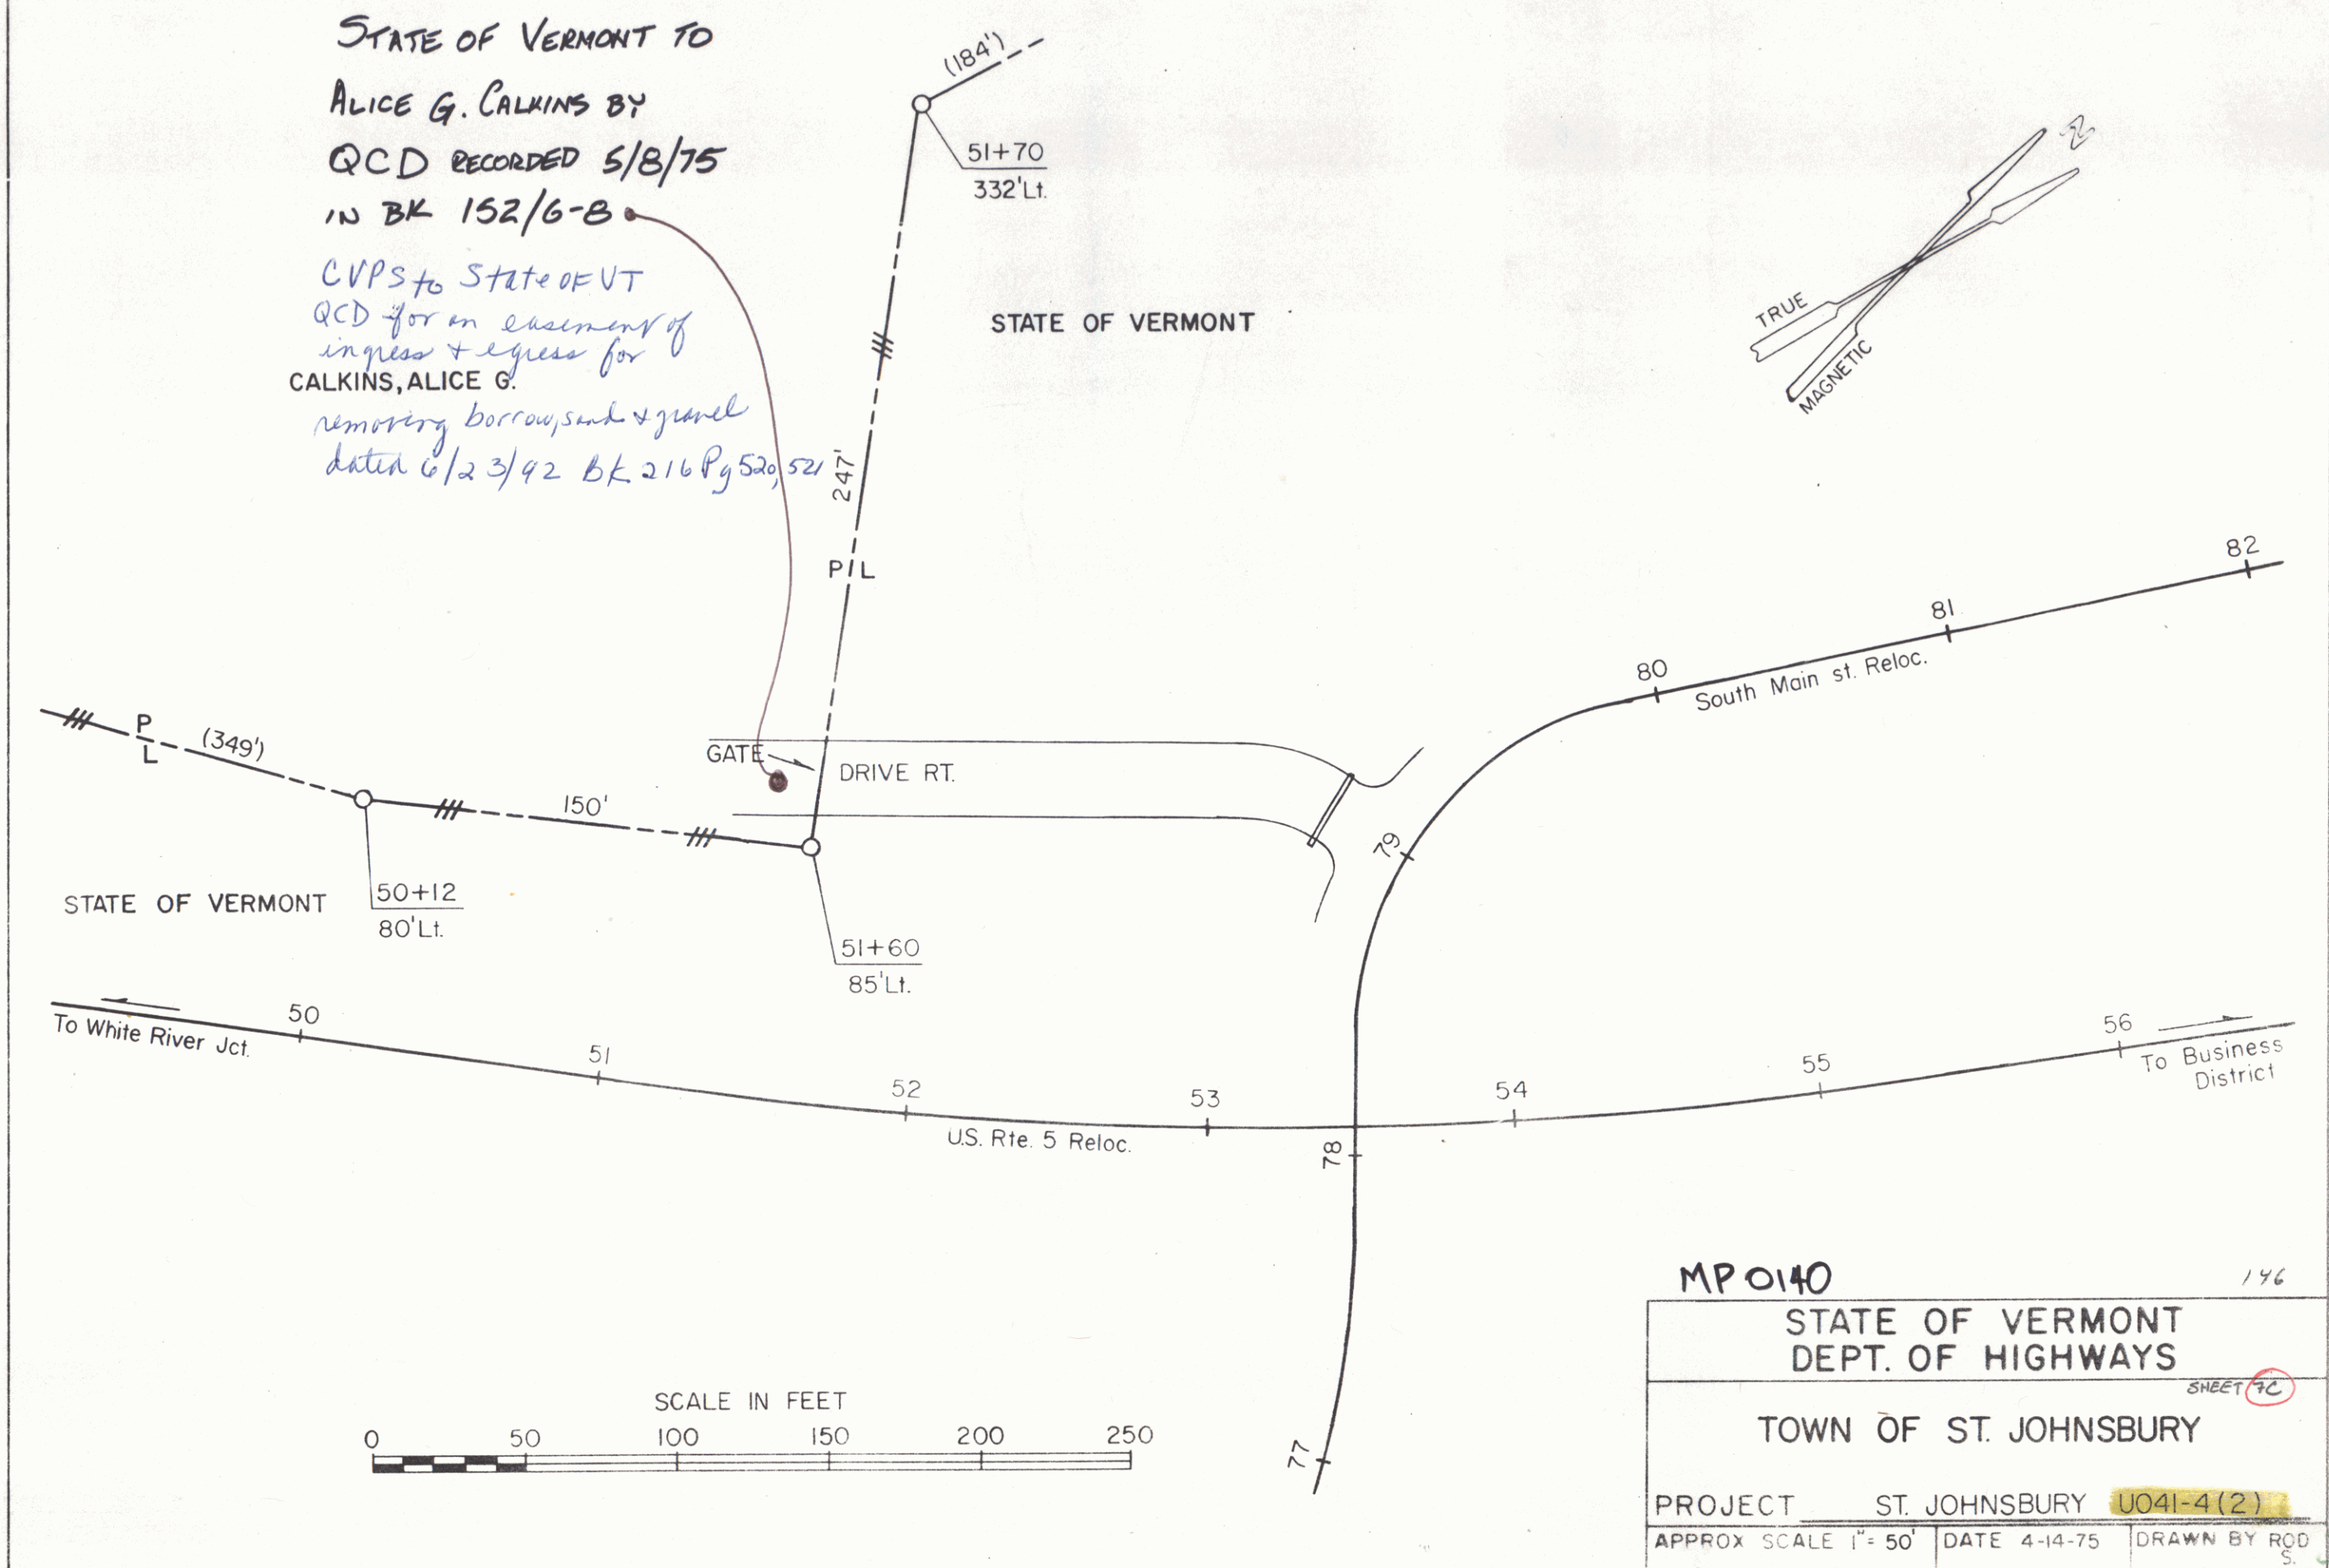

MP 0140 146

STATE OF VERMONT
 DEPT. OF HIGHWAYS

TOWN OF ST. JOHNSBURY

PROJECT ST. JOHNSBURY U041-4(2)

APPROX SCALE 1" = 50' DATE 4-14-75 DRAWN BY ROD S