


PARCEL 8 - ACQUIRED FROM ERNEST N. & VERONIQUE M. GAUVIN
BY W.D. RECORDED 12-19-72 IN BK.144 PGS.425 & 426

PARCEL 9 - ACQUIRED FROM IRA A. HATCH BY COND.
RECORDED JULY 16, 1973 IN BK.146 PGS. 490-500

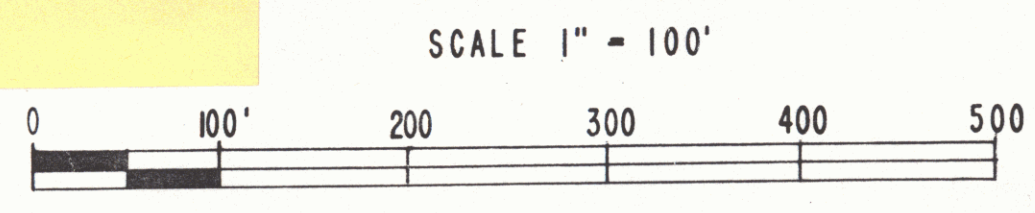

REF.: R.O.W. SHEET 8 OF 12 1155

STATE OF VERMONT DEPT. OF HIGHWAYS		
SHEET 05		
TOWN OF ST. JOHNSBURY		
PROJECT ST. JOHNSBURY U041-4(2)		
APPROX. SCALE 1"=100'	DATE 2-15-77	DRAWN BY KDP

8