
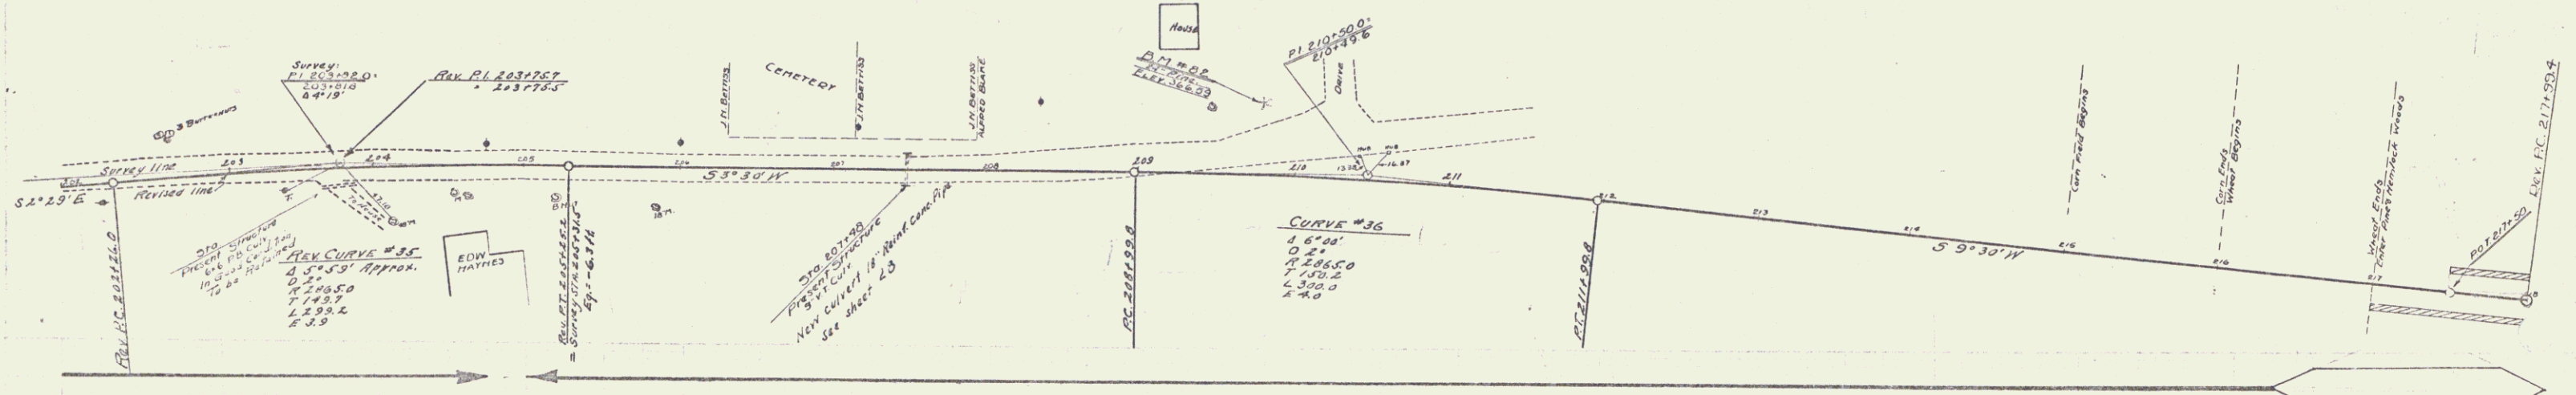


WOOD GUARD RAIL REQUIRED
 Station 127136-207160 24" 24"


NEW REIN. CONC. P.C. CURB REQUIRED
 Station 207148 18" 32" S.C.Y. 33"

GRADED COBBLE GUTTER REQUIRED
 Station 21700-21800 17' 100# 44.73 yds 4' 8"
 21700-21800 21' 50# 22.1' 4' 8"
 For Design See Sheet 2

77E 1929 10 73

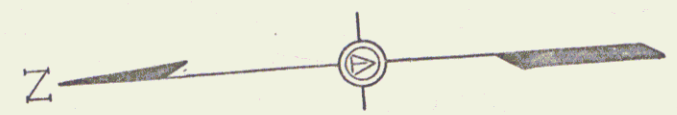

RLS
 H.S.

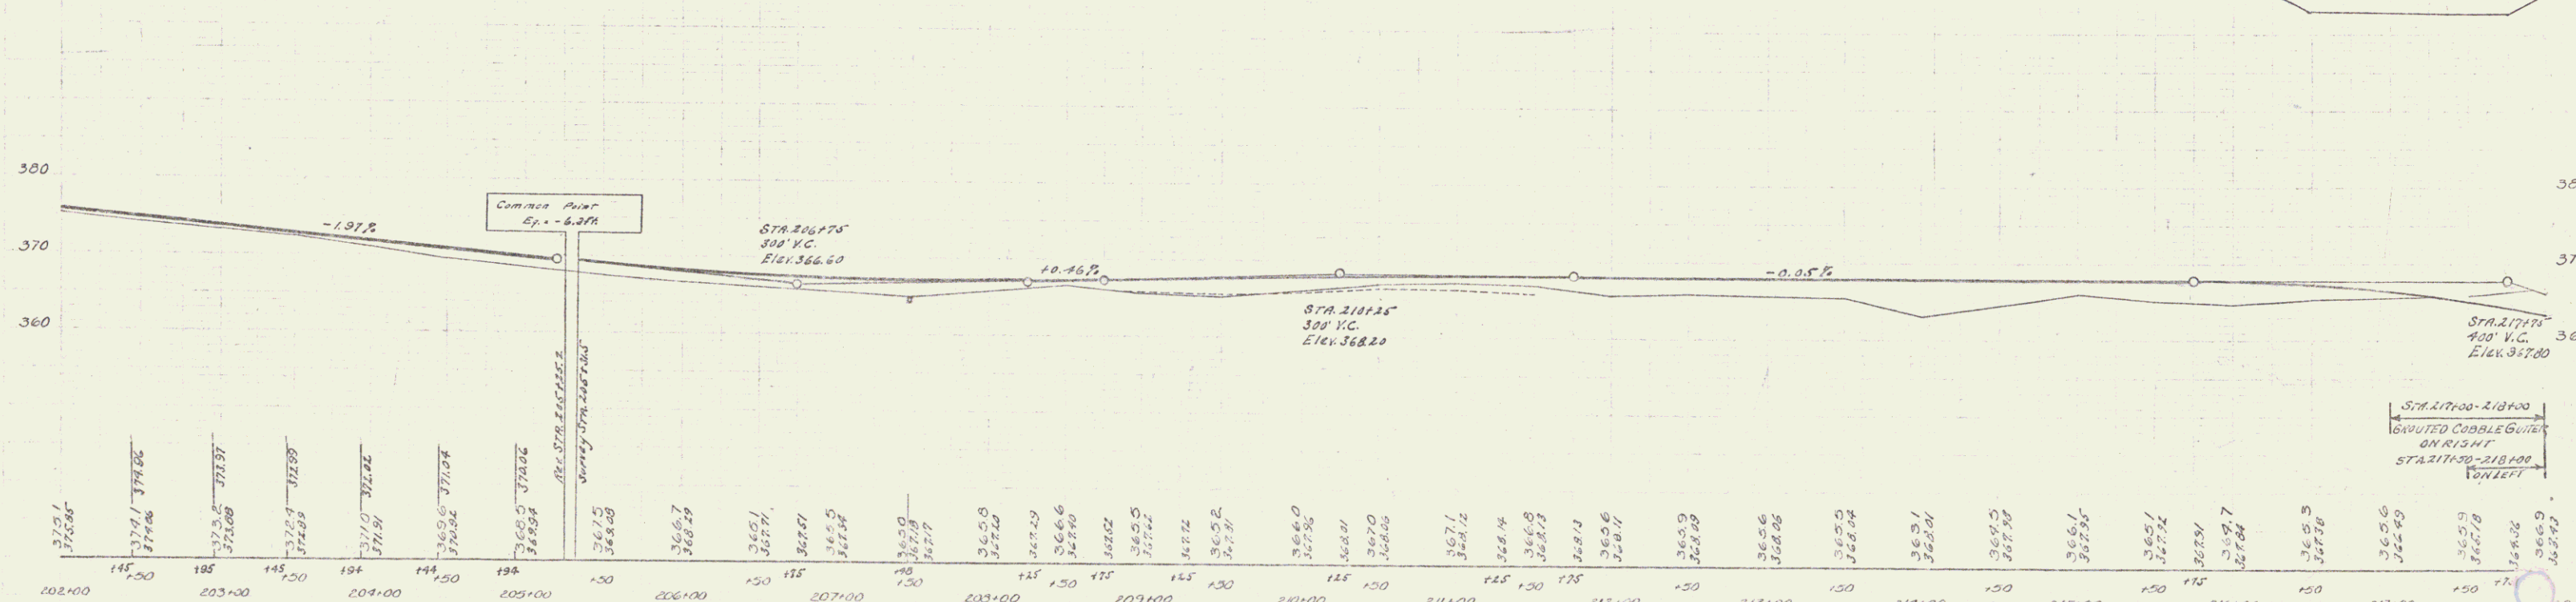

BM # 62 24" PINE, LEFT STA. 209'80" ~ ELEV. 366.59

DESIGNED BY No 77E
 SHEET 10 OF 73

16