
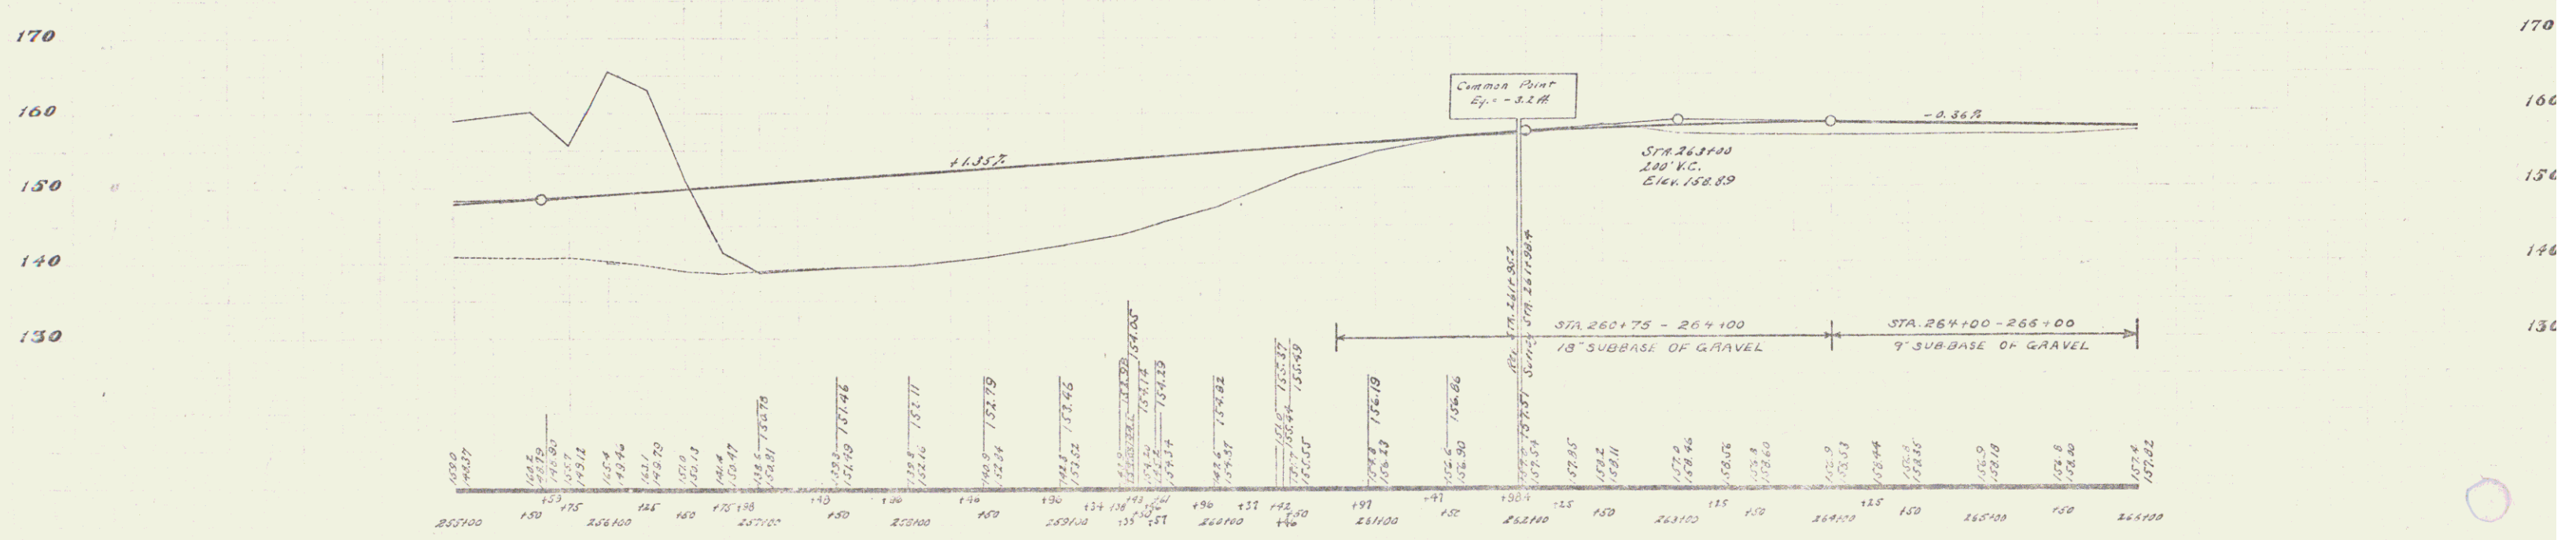


CHOLE GUARD RAIL REQUIRED
 Station Left Right
 256130-260130 100ft
 258100-260100 200ft

NEW REIN. CONC. BOX CULVERTS REQUIRED
 Station Size Conc. P. Steel
 259130 31x3 254cy 1710"

776 1020 22 73

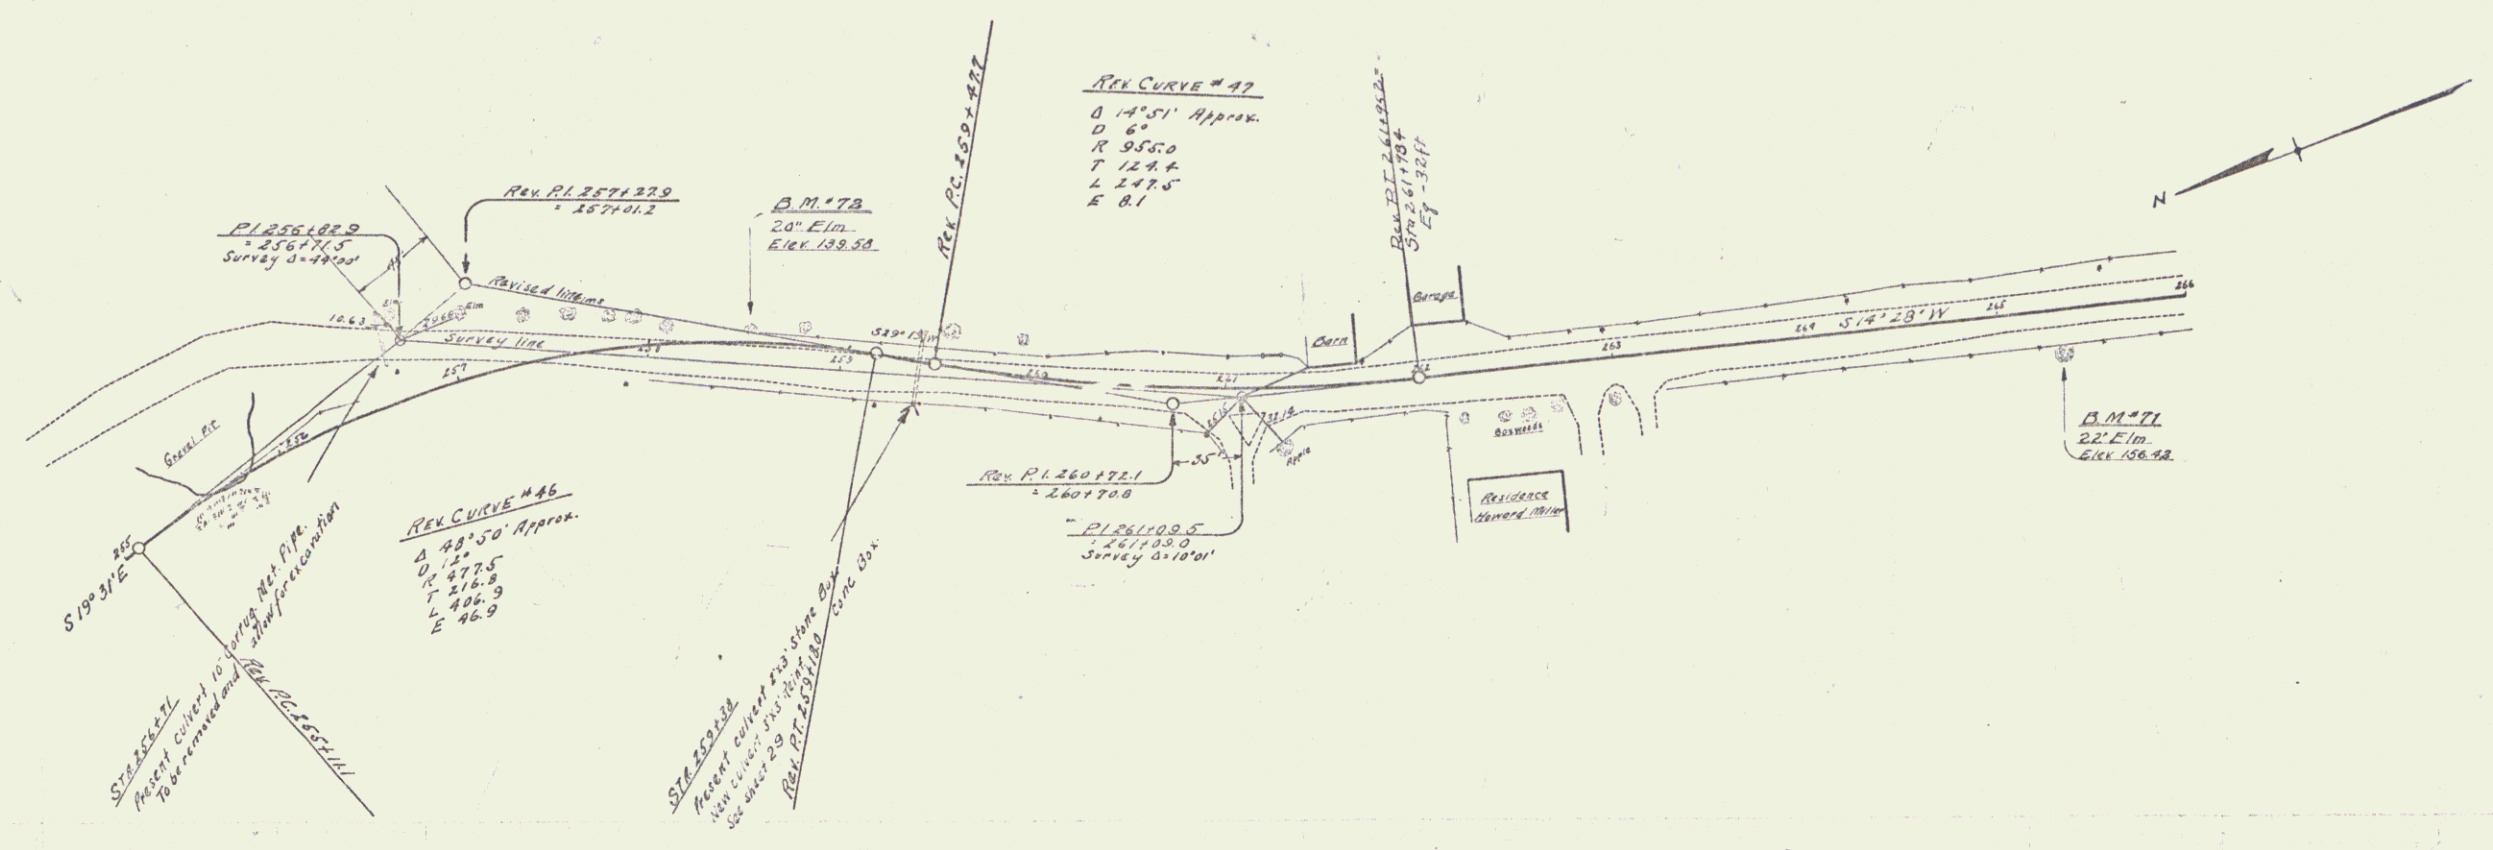

Δ M 71 22° 21' right of STA 25938 Elev 158.45
 Δ M 72 20° 21' left of STA 258155 Elev 159.58

SERIES F. # 77-E
 SHEET 22 OF 73