
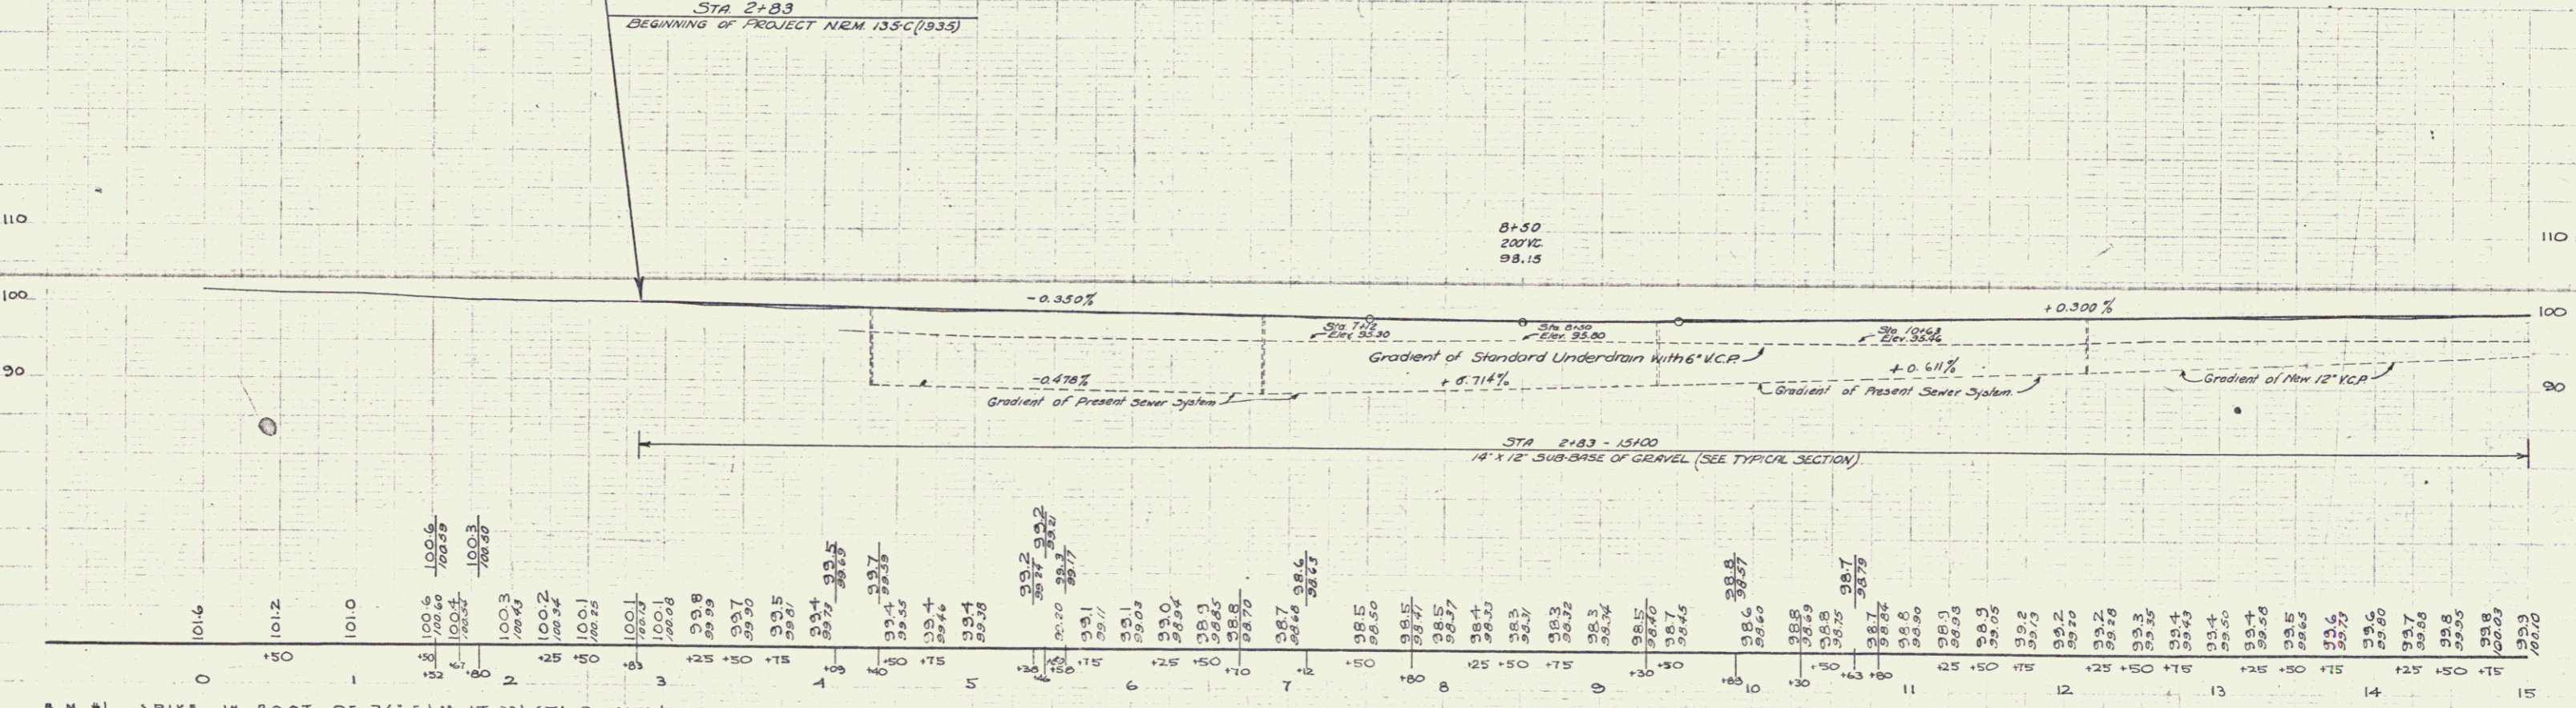


FARRINGTON 8/34  
 D. MACCHI 9/34  
 TRACED D. MACCHI

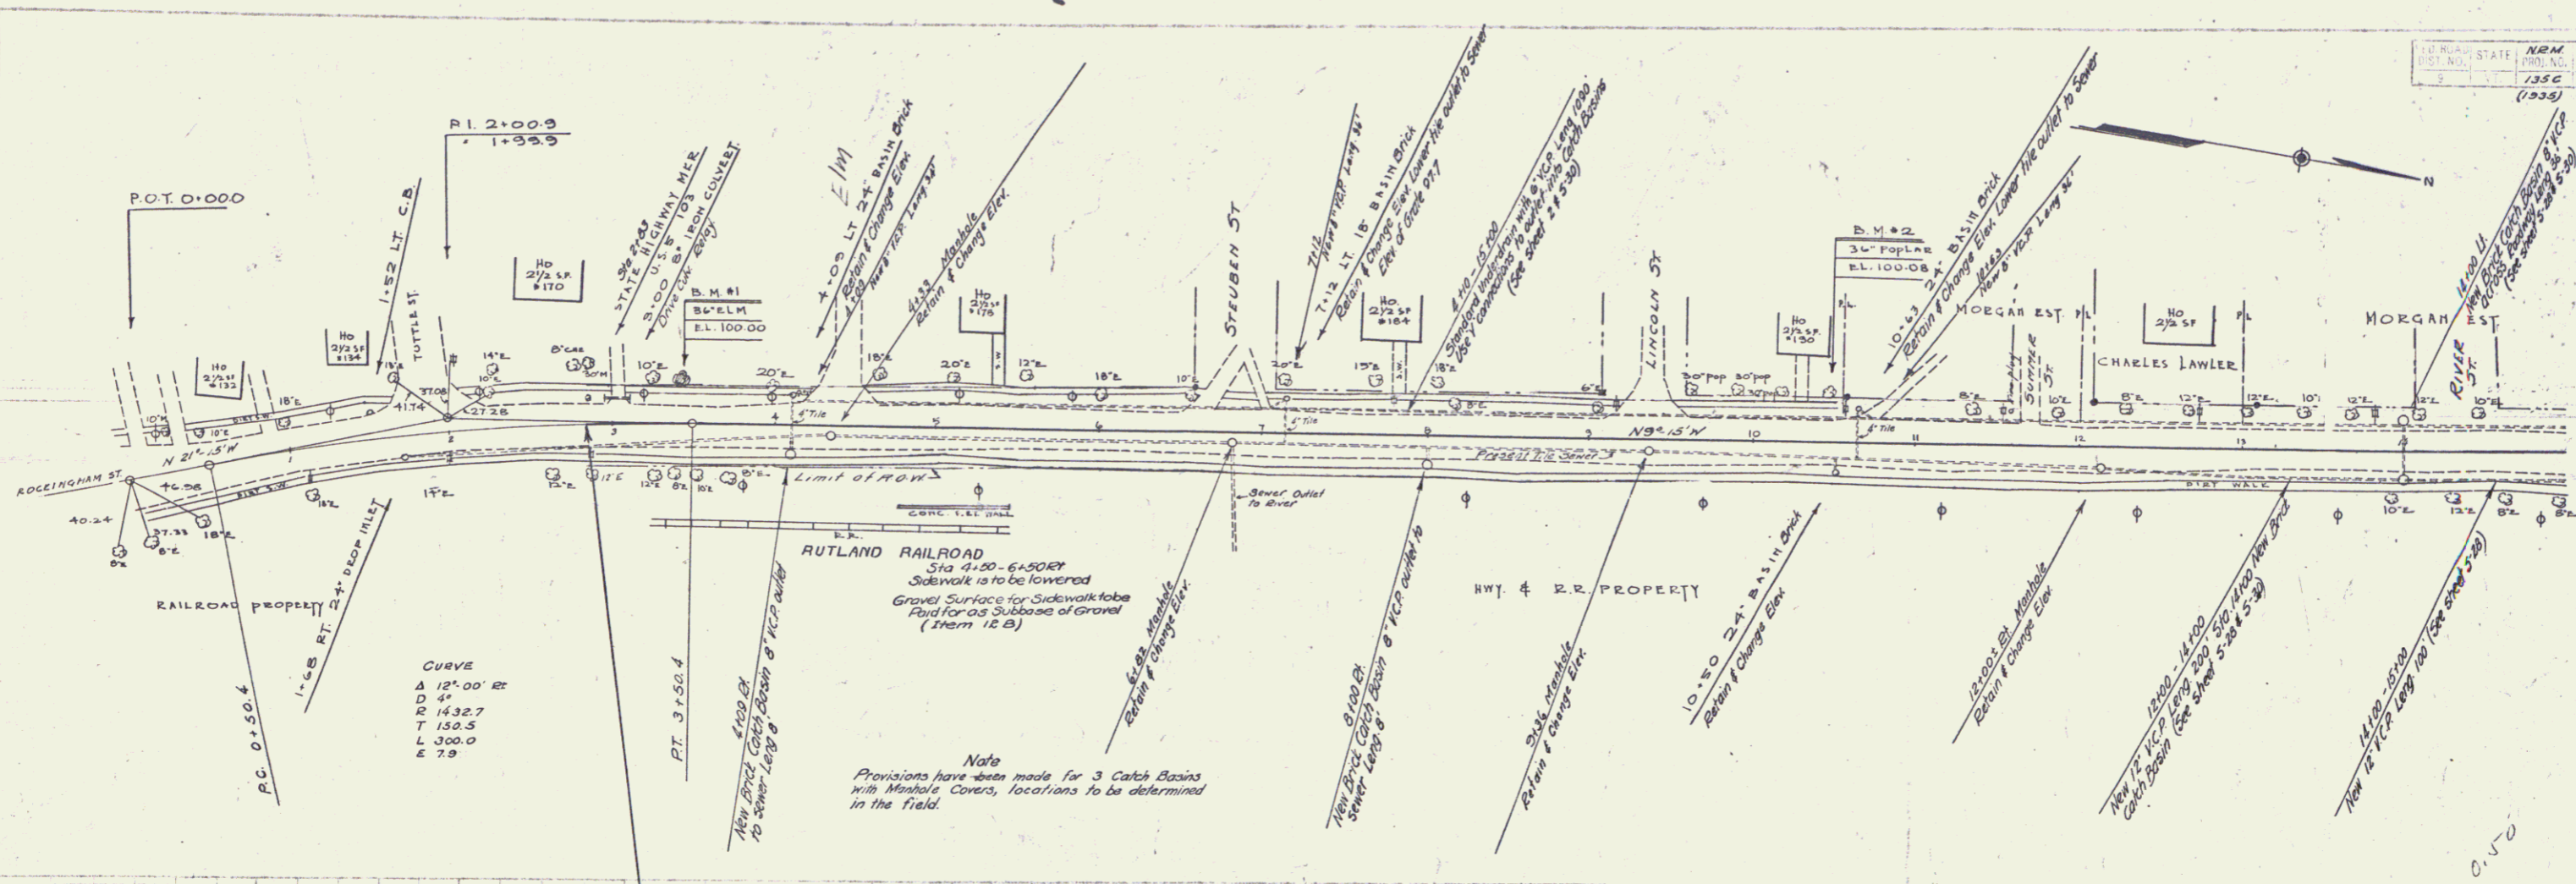

B.M. #1 SPIKE IN ROOT OF 36' ELM LT. 23' STA 3+41 EL. 100.00  
 B.M. #2 36' POPLAR LT. 28' STA 10+46 EL. 100.08