



LANE
H.R. CALLAWAY
8-27-38

LANE
H.R. CALLAWAY
8-27-38

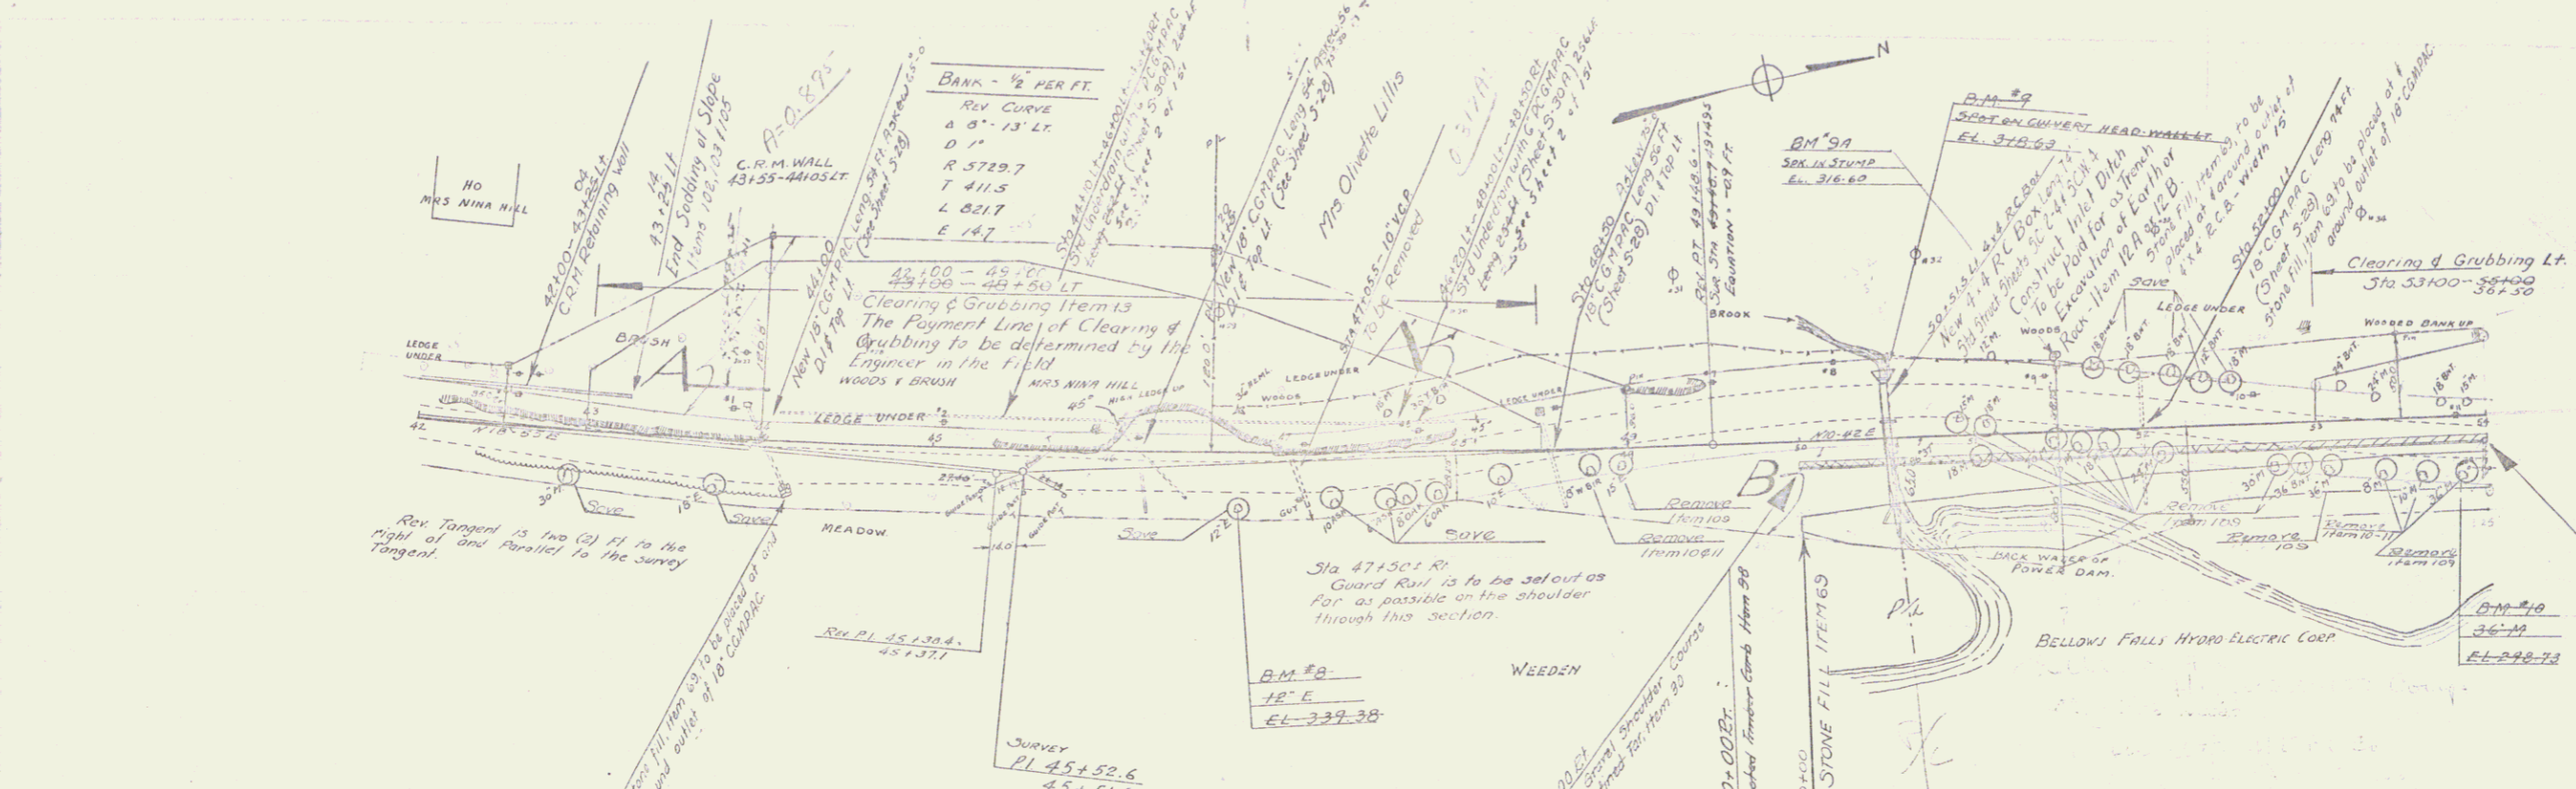

PARCEL INTERMENT	DATE	GRANTOR	GRANTEE	RECORDED ROCKINGHAM	REMARKS
A	7-29-40	NINA HILL	ST OF VT	80X 124	83-20
B	7-29-40	MATHE W WEEDEN	ST OF VT	65 145	83-40
A'	11-30-40	OLIVETTE LILLIS	ST OF VT	65 149	123-20

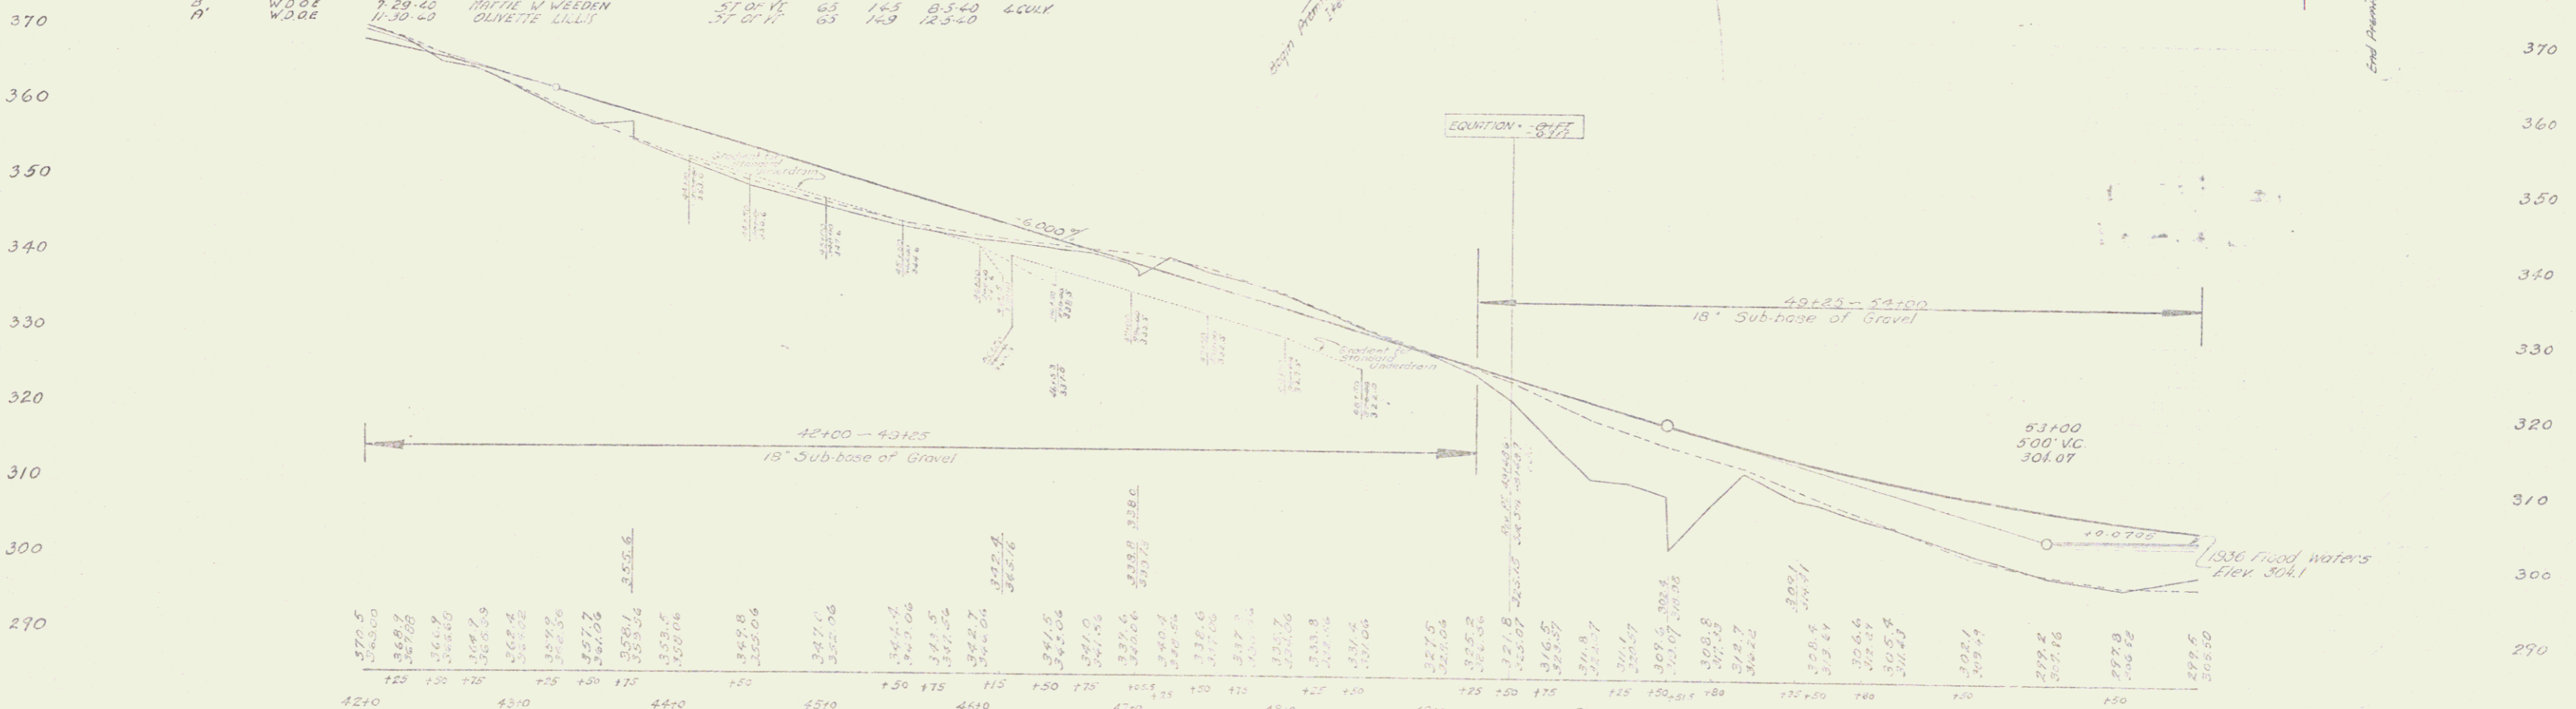

BM #9A 51.00' 1/2" DIA. STAINLESS STEEL STA 5110.0 ELEV. 316.62
 BM #B 54R 12" ELM 27' RT. STA 40+15 ELEV. 339.38
 BM #9 SPOT ON CULTURE HEAD WALL LT. ELEV. 318.64
 BM #10 3-1 TRUNK 34-M 33R-5TH 33+24 ELEV. 296.73

ROCKINGHAM
 JACOB'S FIRE NO. 195 J(1)
 SHEET 9 OF 151