



C.E. PROCTOR  
 L.F. CONE  
 Z.F. CONE  
 1936  
 1936  
 1936

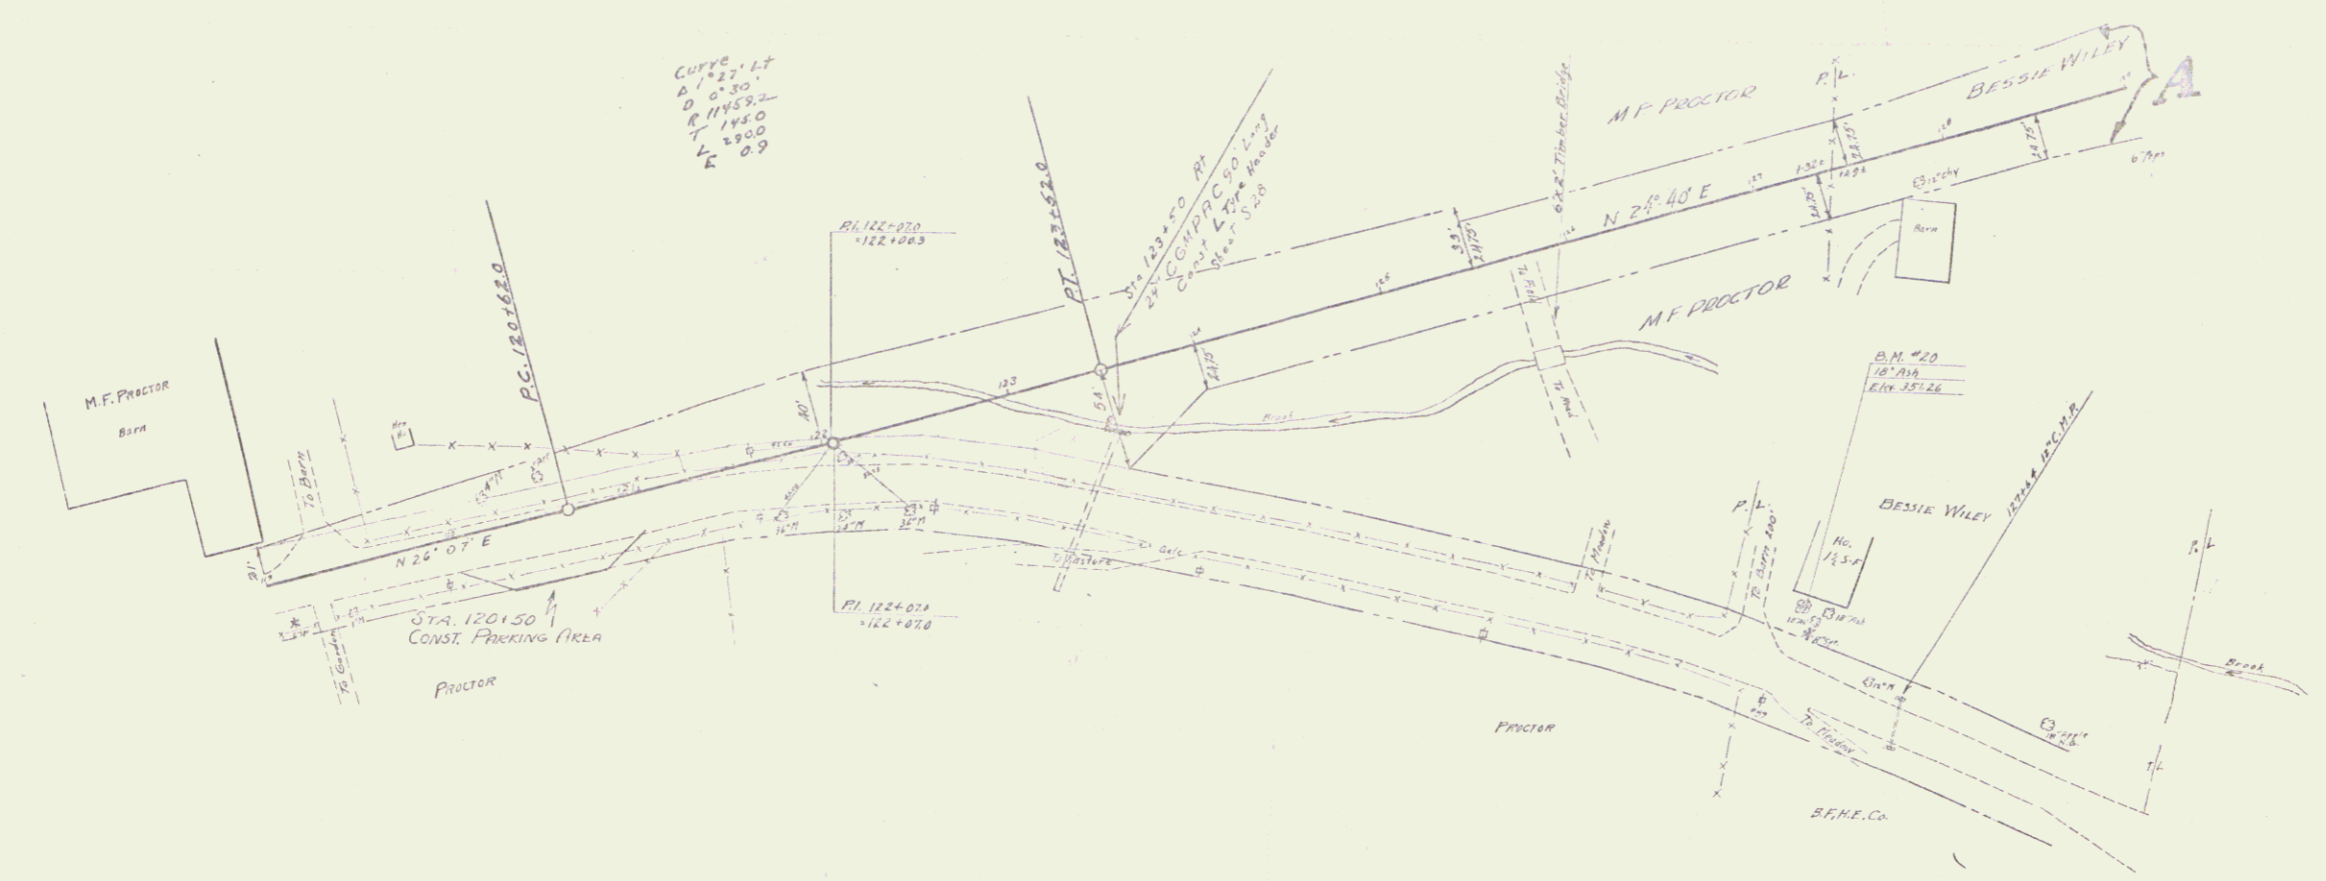

CURVE - LT  
 R 1152.2  
 D 115.0  
 T 115.0  
 L 115.0  
 K 0.9

PARCEL	KIND OF INSTRUMENT	DATE OF INSTRUMENT	GRANTOR	GRANTEE	RECORDED BOOK PAGE DATE	REMARKS
A.B.	W.D.	2-7-36	BESSIE WILEY		87 11-12 2-13-36	

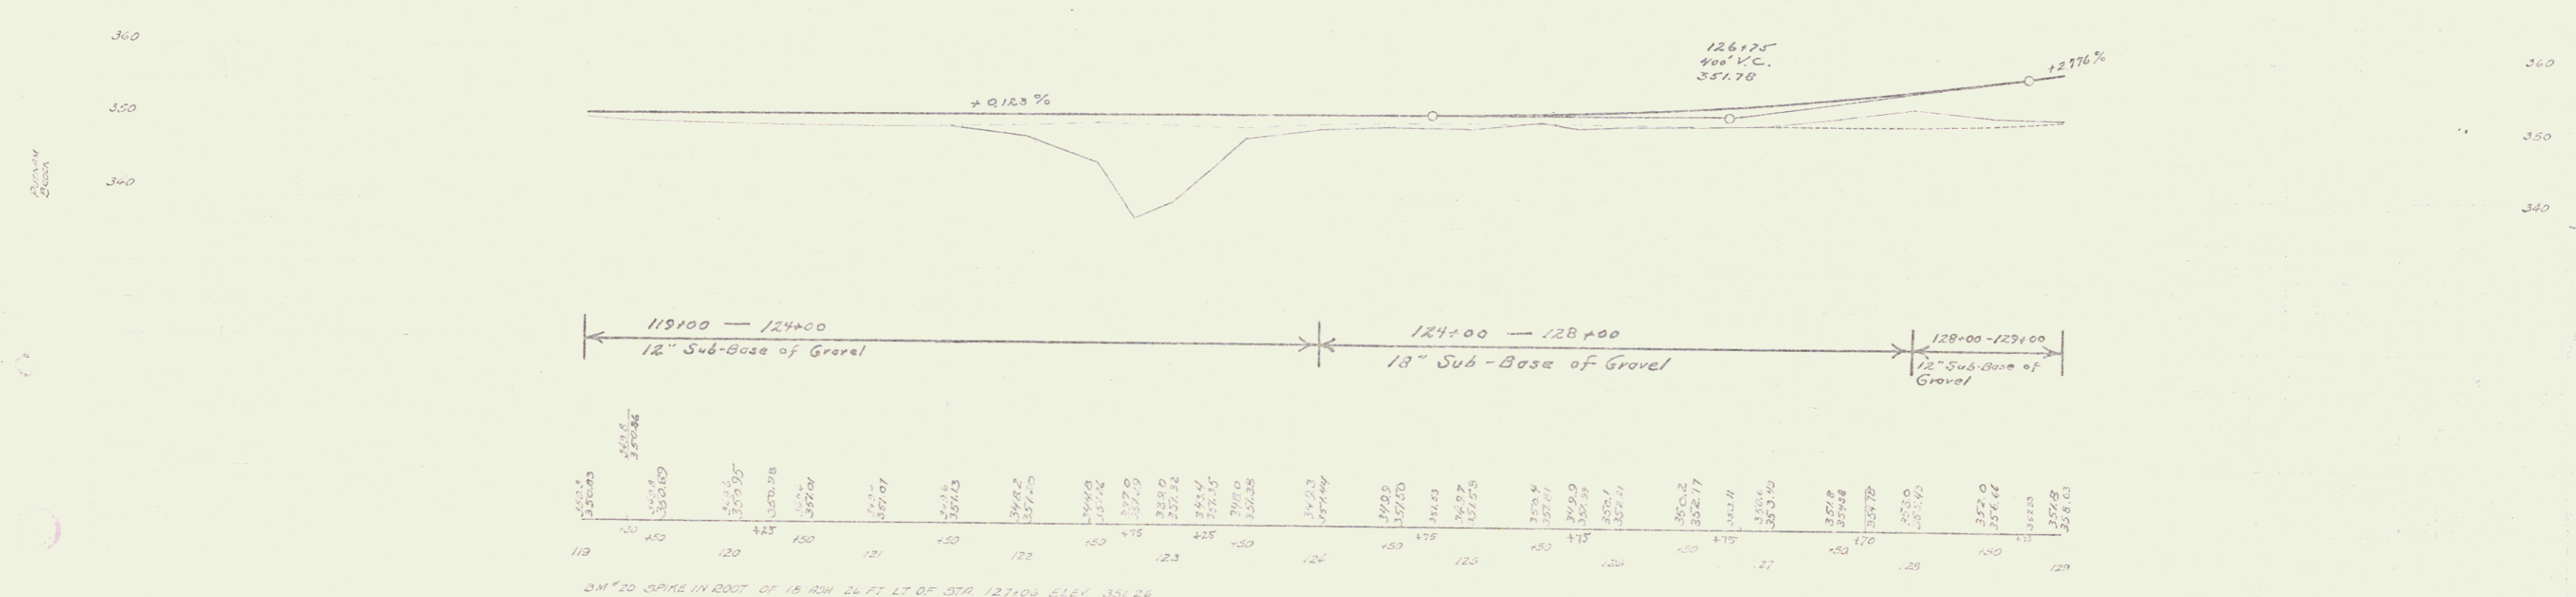

BM #20 SPIKE IN ROOT OF 16' DIA 26' FT LT OF STA. 127+00 ELEV. 351.26

SERIES WPH No. 135-F  
 SHEET **B** OF 49 SHEETS

5