



E-135A 1932
 (M) E-135B 1932

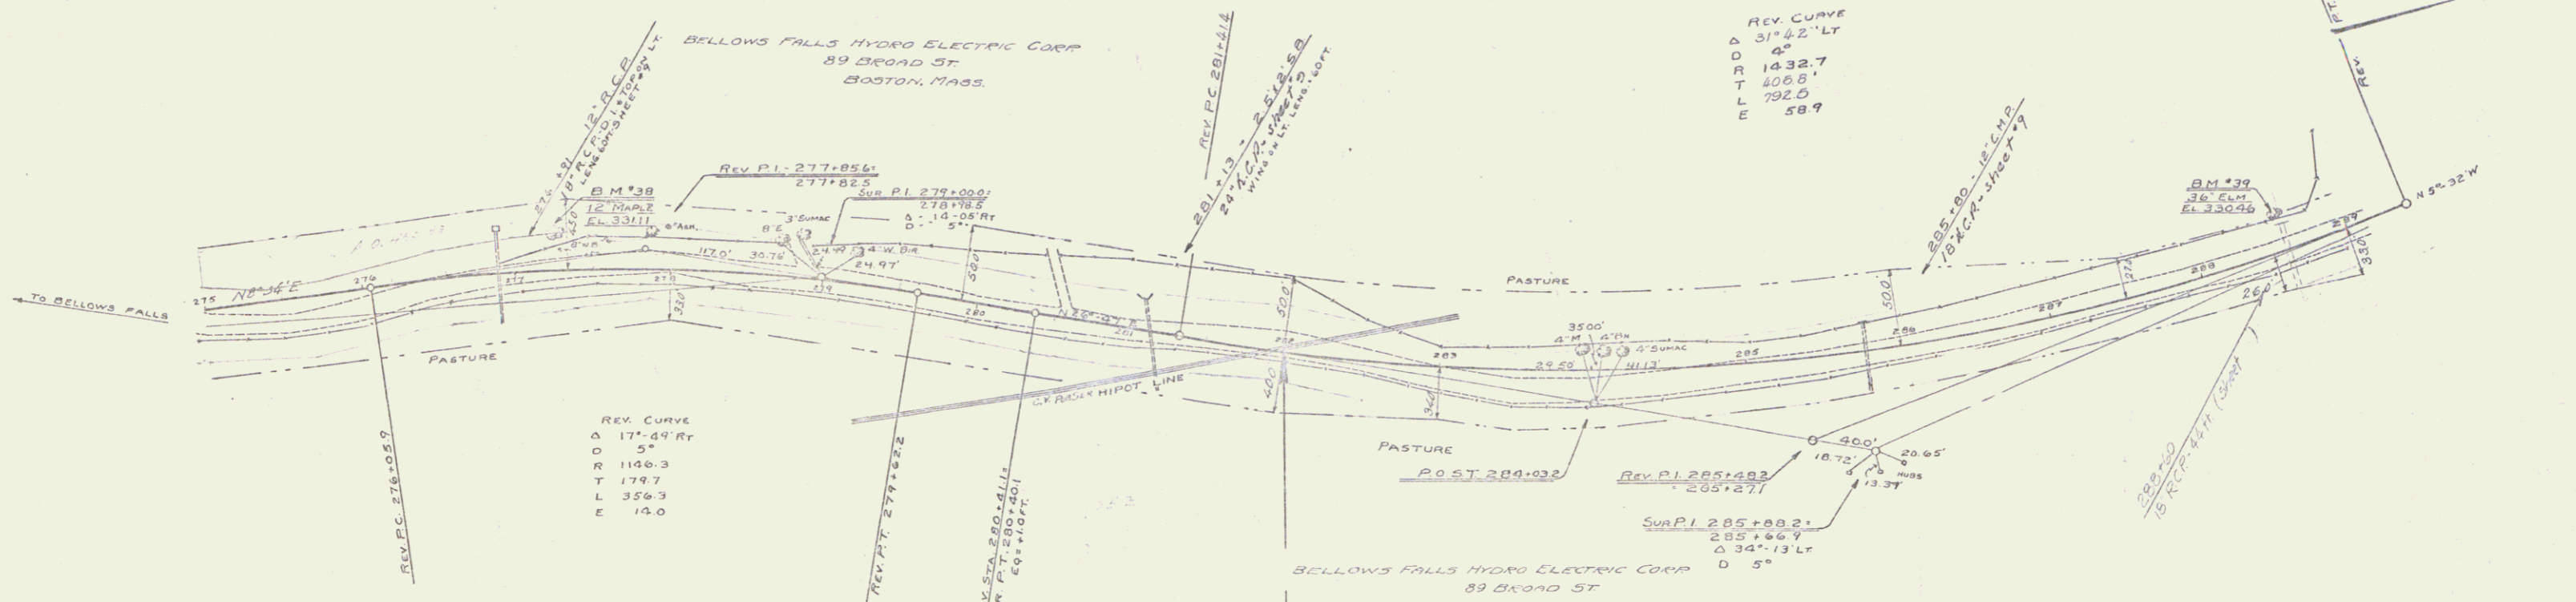

PARCEL	KIND OF DATE OF INSTRUMENT	GRANTOR	GRANTEE	TOWN BOOK	RECORDED PAGE DATE	REMARKS
B, C	CONF. Q.C.	6-26-1933	BELLOWS FALLS HYDRO ELECTRIC CORP.	ST. OF VT. SPRINGFIELD 44	89-90 7-5-1933	SEE SHEET 7
A, B, C	CONF. Q.C.	6-26-1933	BELLOWS FALLS HYDRO ELECTRIC CORP.	ST. OF VT. SPRINGFIELD 44	93-95 7-5-1933	SEE SHEET 5 OF CIVIL FROM E-135 B

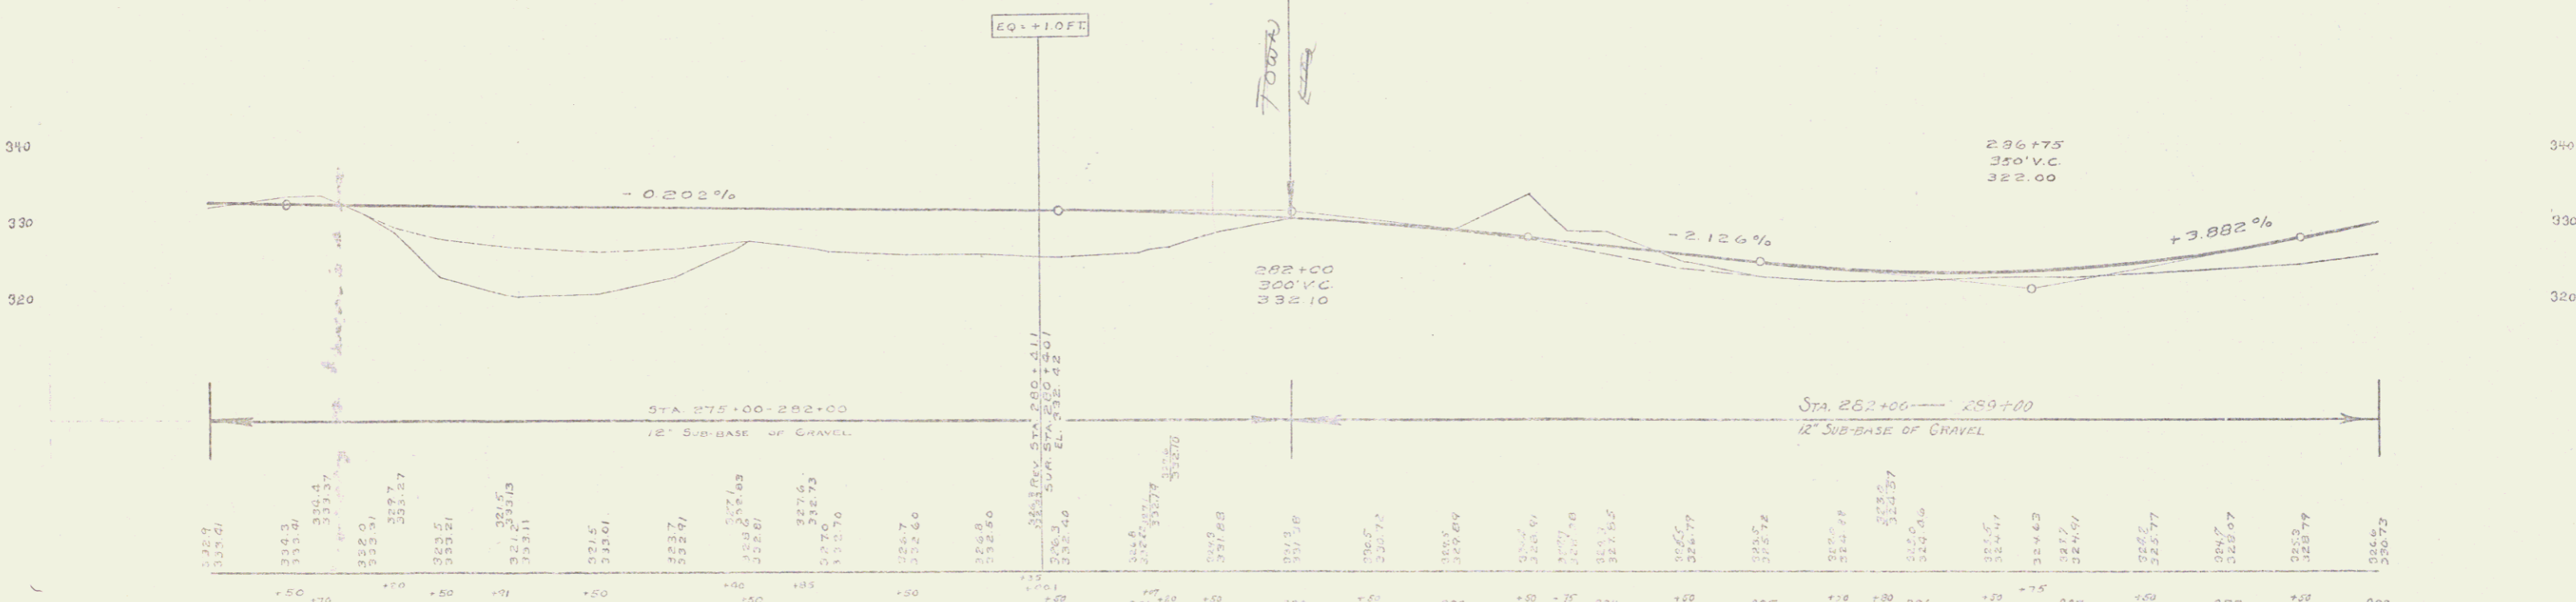

275 276 277 278 279 280 281 282 283 284 285 286 287 288 289
 12" SUB-BASE OF GRAVEL
 12" SUB-BASE OF GRAVEL

B.M. 38 SPIKE IN ROOT 12" MAPLE 277+00 ELEV. 331.11
 B.M. 37 SPIKE IN ROOT 36" ELN 277+02 ELEV. 330.75

SERIES E No. E-135-A
 SHEET 8 OF 67

5