
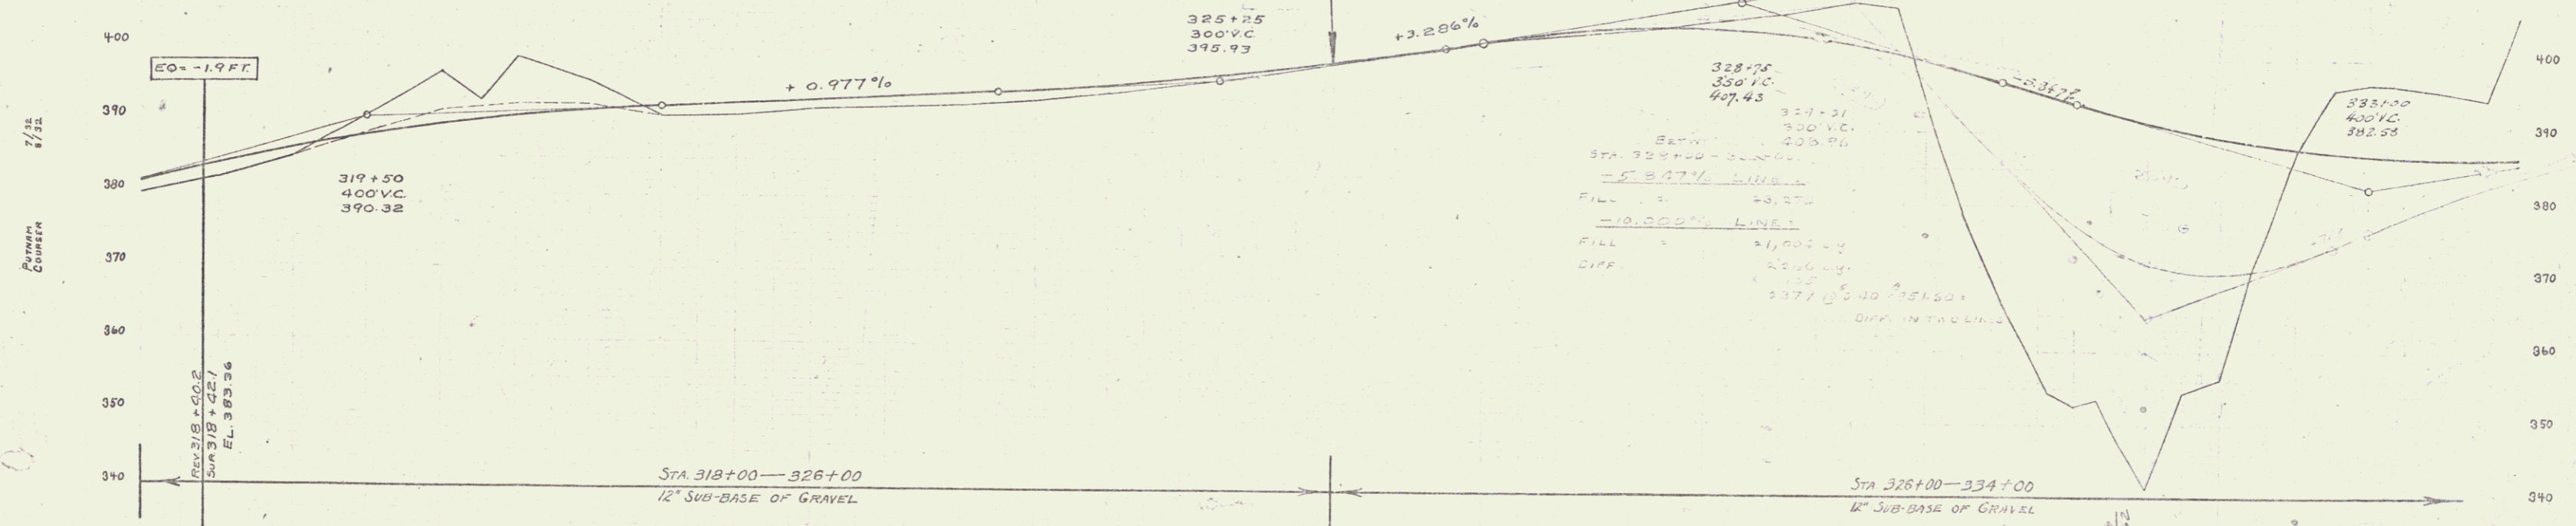


PARCEL INSTRUMENT DATE GRANTOR GRANTEE RECORDED
 A-0 G.C.O. 3-23-33 MRS. A.C. DENT ST. OF VT. BANK FILE DATE
 3 109 823-33

6:135-8193E 7 20

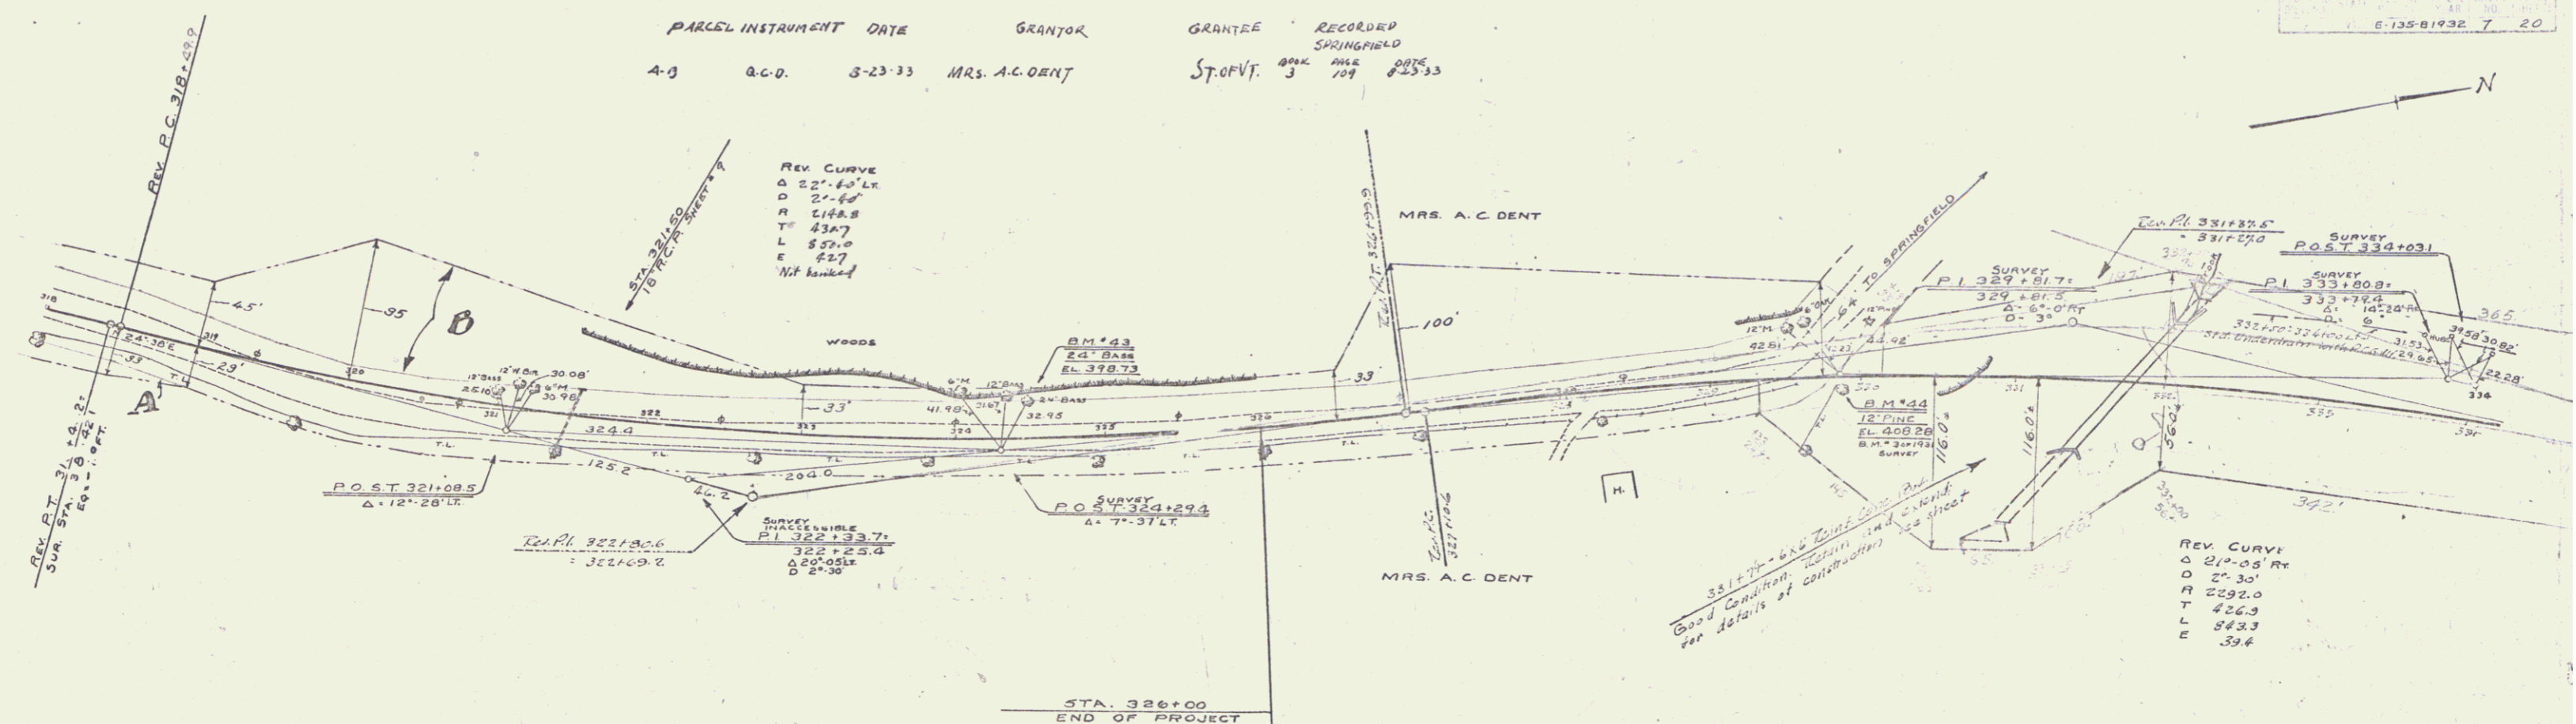

318	319	320	321	322	323	324	325	326	327	328	329	330	331	332	333	334
387.34	387.5	387.94	387.83	387.74	387.67	387.65	387.63	387.67	387.76	387.85	387.94	388.0	388.1	388.2	388.3	388.4
387.34	387.5	387.94	387.83	387.74	387.67	387.65	387.63	387.67	387.76	387.85	387.94	388.0	388.1	388.2	388.3	388.4

B.M. #43 SPIKE IN ROOT 2 1/2 BRSSWOOD 22 FT. LT. STA. 324+47 ELEV. 318.73
 B.M. #44 SPIKE IN ROOT 12" PINE 1 FT. RT. STA. 321+80 ELEV. 308.88

318+00
 319+00
 320+00
SERIES F No. E 135-81
 SHEET 7 of 20