



REG. ROAD DIST. NO.	STATE	FED. AID PROJ. NO.	FISCAL YEAR	SHEET NO.	TOTAL SHEETS
150	MO.	135 H (1)	1940	11	76

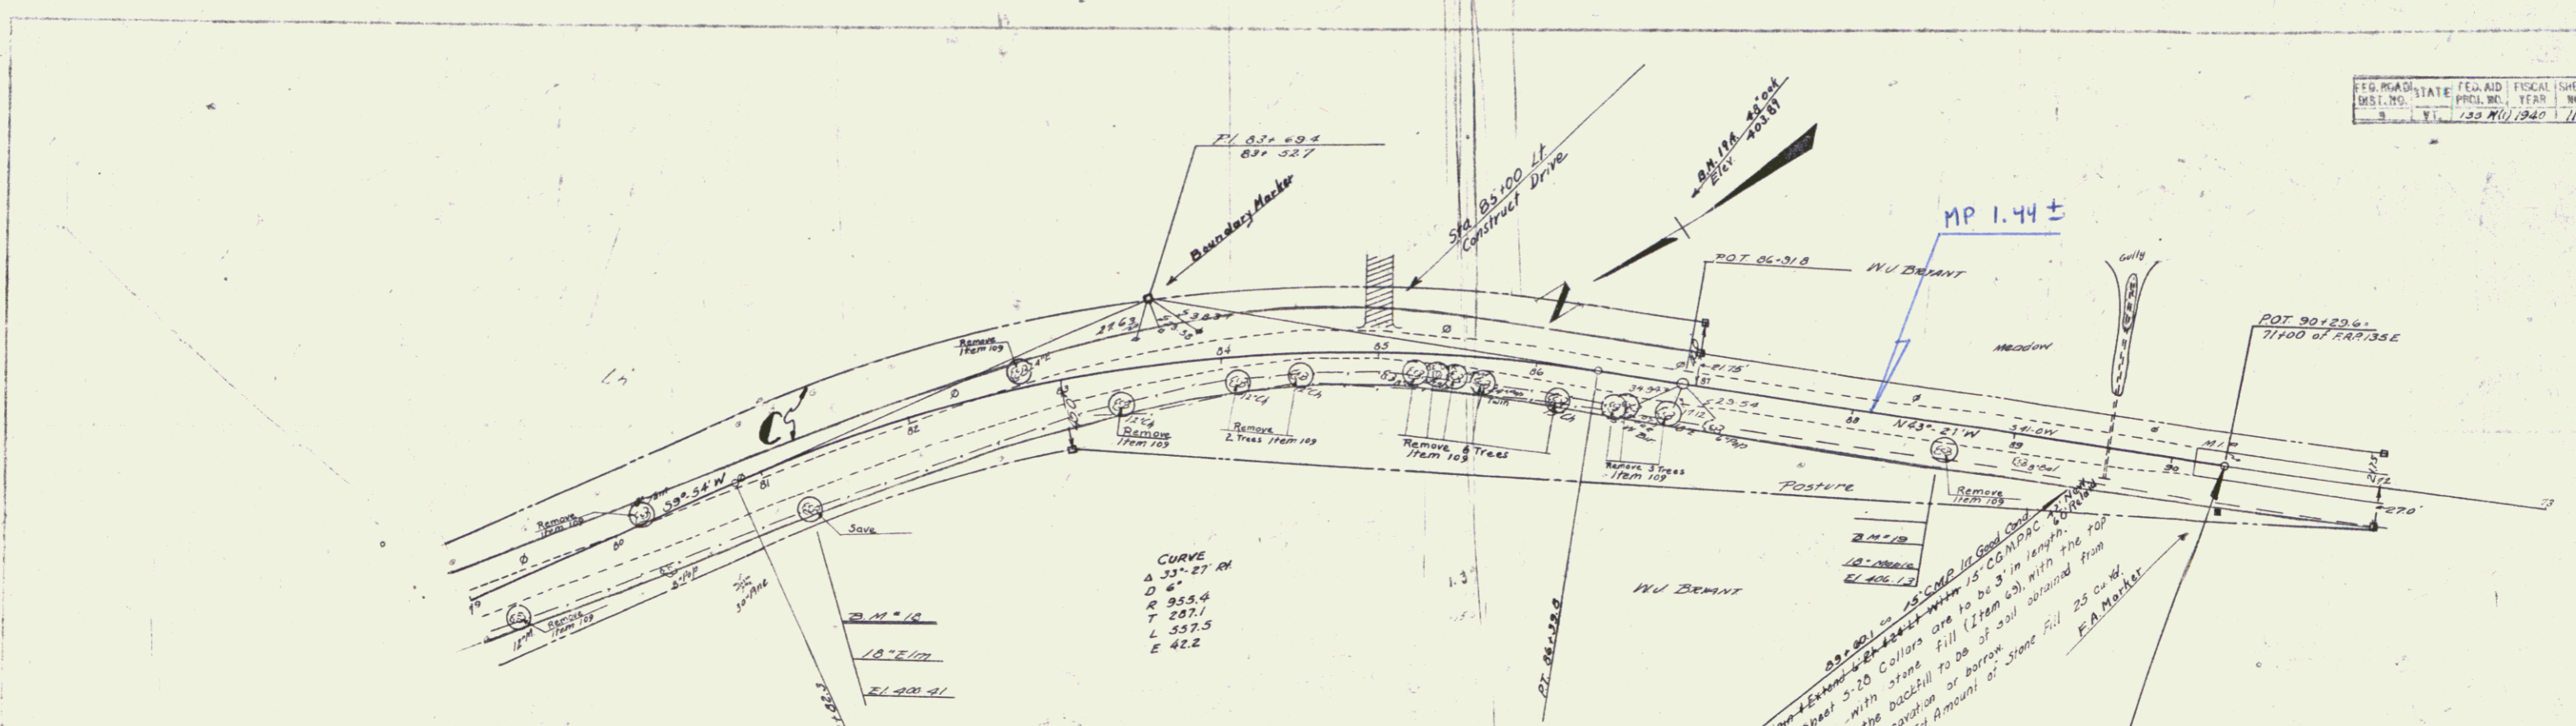

PARCEL	INSTRUMENT	DATE	GRANTOR	GRANTEE	RECORDED	REMARKS
C	W.D.	6-7-38	WILLIAM J. & FRANCIS H. BRYANT	SPRINGFIELD	BOOK PAGE DATE	
					26 68-9 6-27-38	

MP 1.44 ±
 MP 1.40 ±
 STA 90+296 = STA 71+000
 END OF FA PROJECT 135 H (1) BEGINNING OF FA PROJECT 135-E

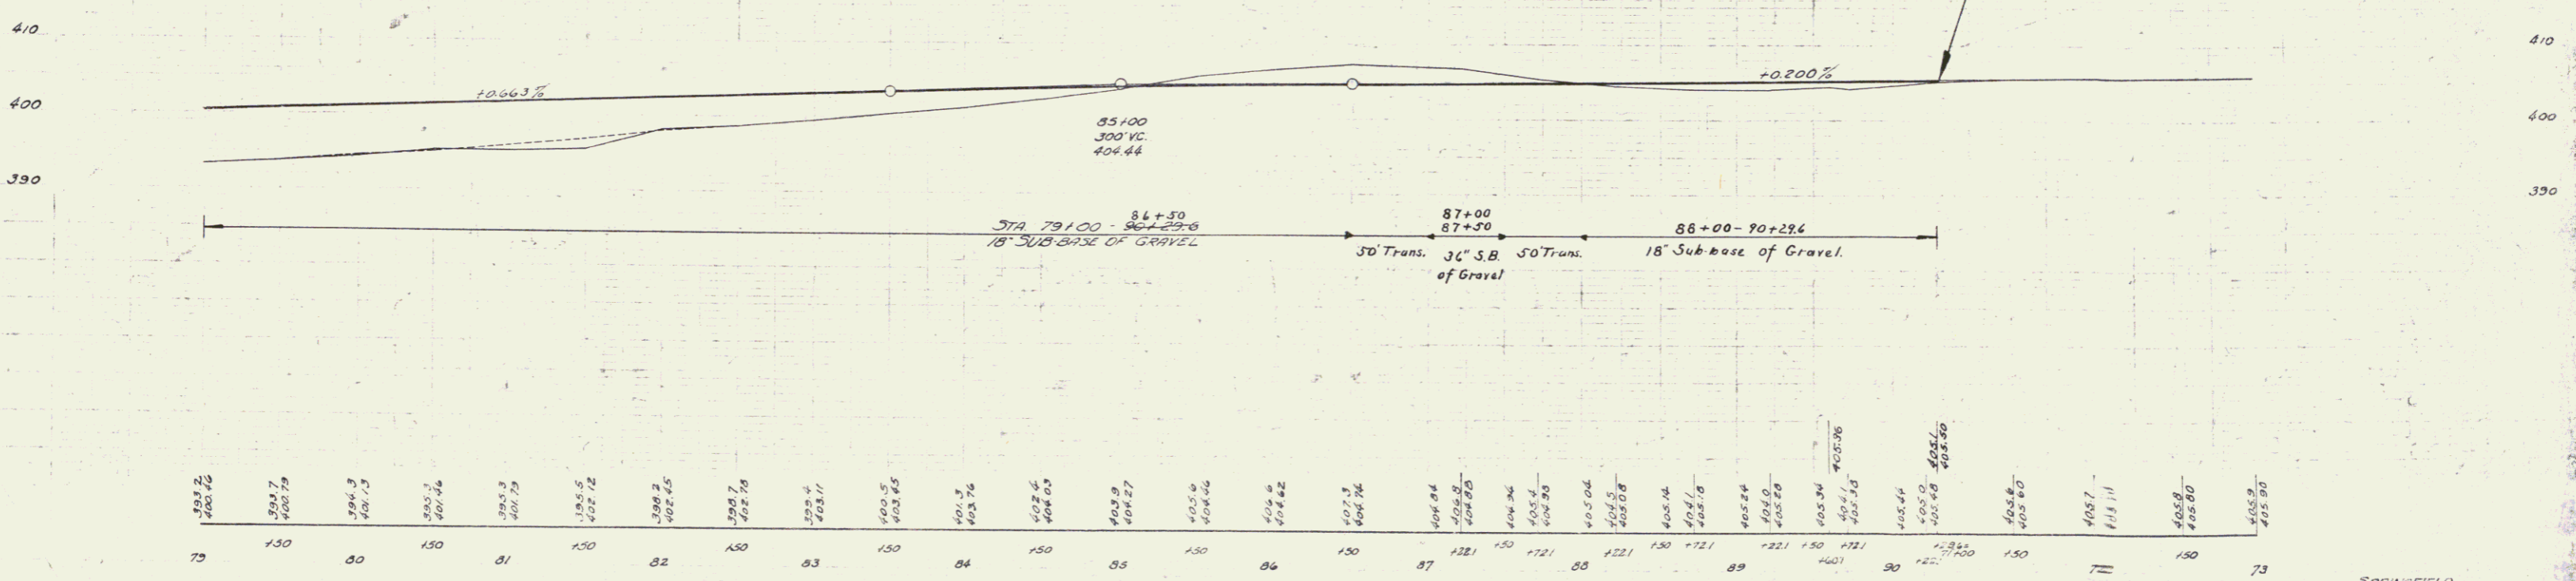

2 1/2" x 10" STRIKE IN ROOT OF 10" ELM 30' BT STA 81+20 ELEV 400.41
 2 1/2" x 10" " " " " 18" MAPLE 15' " " 82+05 ELEV 406.13