


Plan	By	Date
Survey	Ensign	8/63
Detail	Ensign	3/60
Notes	Ensign	2/67

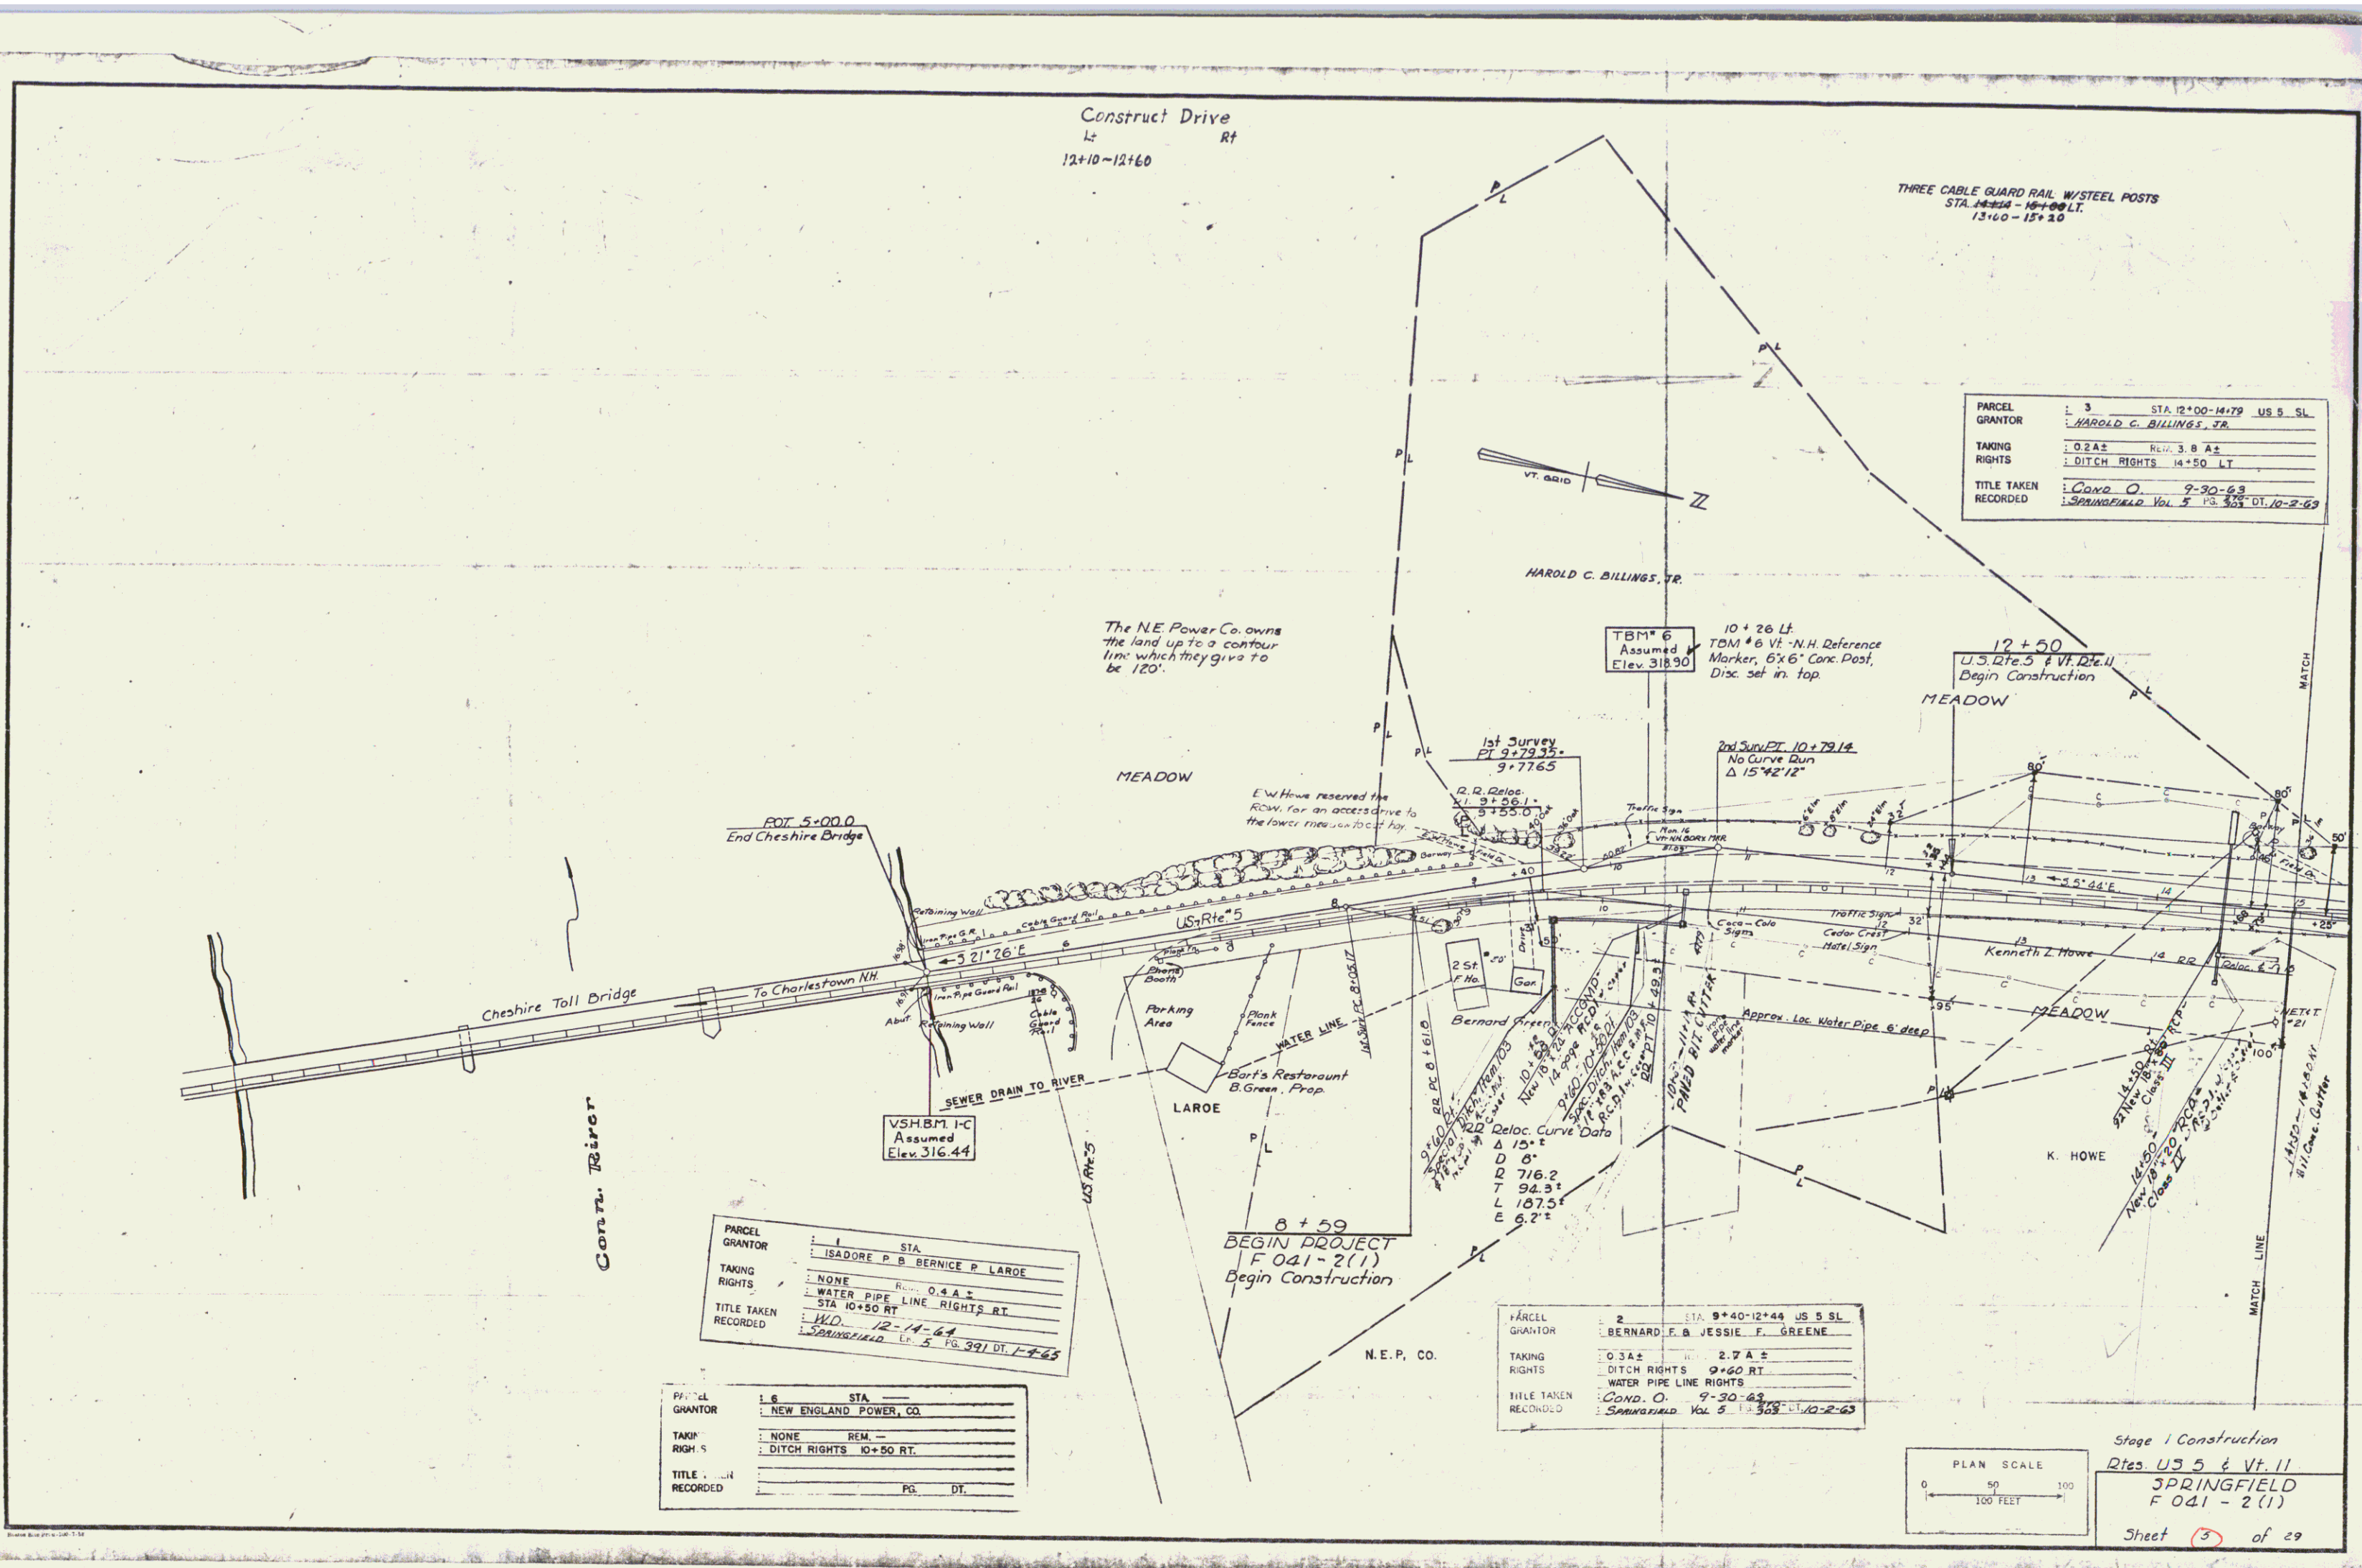


PARCEL	3	STA. 12+00-14+79	US S. SL.
GRANTOR	HAROLD C. BILLINGS, JR.		
TAKING RIGHTS	0.2A±	RECORD	3.8 A±
DITCH RIGHTS	14+50 LT.		
TITLE TAKEN	COND. O. 9-30-63		
RECORDED	SPRINGFIELD Vol. 5 Pg. 305 DT. 10-2-63		

PARCEL	1	STA.	
GRANTOR	ISADORE P. & BERNICE P. LAROE		
TAKING RIGHTS	NONE	RECORD	0.4 A±
DITCH RIGHTS	10+50 RT.		
TITLE TAKEN	W.D. 12-14-64		
RECORDED	SPRINGFIELD Vol. 5 Pg. 291 DT. 1-7-65		

PARCEL	2	STA.	9+40-12+44	US S. SL.
GRANTOR	BERNARD F. & JESSIE F. GREENE			
TAKING RIGHTS	0.3A±	RECORD	2.7 A±	
DITCH RIGHTS	9+40 RT.			
TITLE TAKEN	COND. O. 9-30-63			
RECORDED	SPRINGFIELD Vol. 5 Pg. 305 DT. 10-2-63			

PARCEL	1	STA.	
GRANTOR	NEW ENGLAND POWER, CO.		
TAKING RIGHTS	NONE	RECORD	-
DITCH RIGHTS	10+50 RT.		
TITLE TAKEN			
RECORDED	Pg. Dt.		

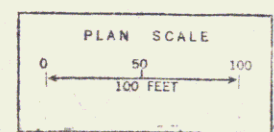

Stage 1 Construction  
 Rtes. US 5 & Vt. 11  
 SPRINGFIELD  
 F 041-2(1)  
 Sheet (3) of 29