


PARCEL	S.A.B.	21A 14+88 - 24+98 US S SL
GRANTD	EDWARD W. B. FESS & HOWE	
TAKING	S. & C.	F.H.
RIGHTS	NONE	
TITLE TAKEN		
RECORDED	BR	PL DT

PARCEL	S.A.	14+88 - 15+28 US S SL
STATIONS		1000 SQ FT.
TAKING		

ASSUMED RR CURVE DATA	
A	45°
B	18°
R	215.3
L	131.8
L	240.0
E	26.2

PARCEL	S.P.	18+26 - 24+98 US S SL
STATIONS		5.6A±
TAKING		

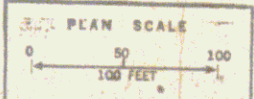

Stage I Construction
 US Rte. 5 F.V. Dte. II
 SPRINGFIELD
 F 041-2(1)
 TA 29