


A 20'-31' Lt.
 O 1'-4.5
 R 3274.2
 T 592.5
 L 1172.4
 E 53.1
 Bank 6" in 20'

PARCEL	INSTRUMENT	DATE	GRANTOR	GRANTEE	RECORDED	REMARKS
A-B	Q.C.D.	12-18-37	DORRÉ & LUCY M. KENDALL	STOF VI	300*	580' PAGE 12-31-37
A'	Q.C.D.	12-18-37	DE KENDALL & WIFE	"	44	583 12-31-37
#1	Q.C.D.	5-27-38	DORRÉ E. KENDALL	"	46	53 6-6-38 CUL. AT #1

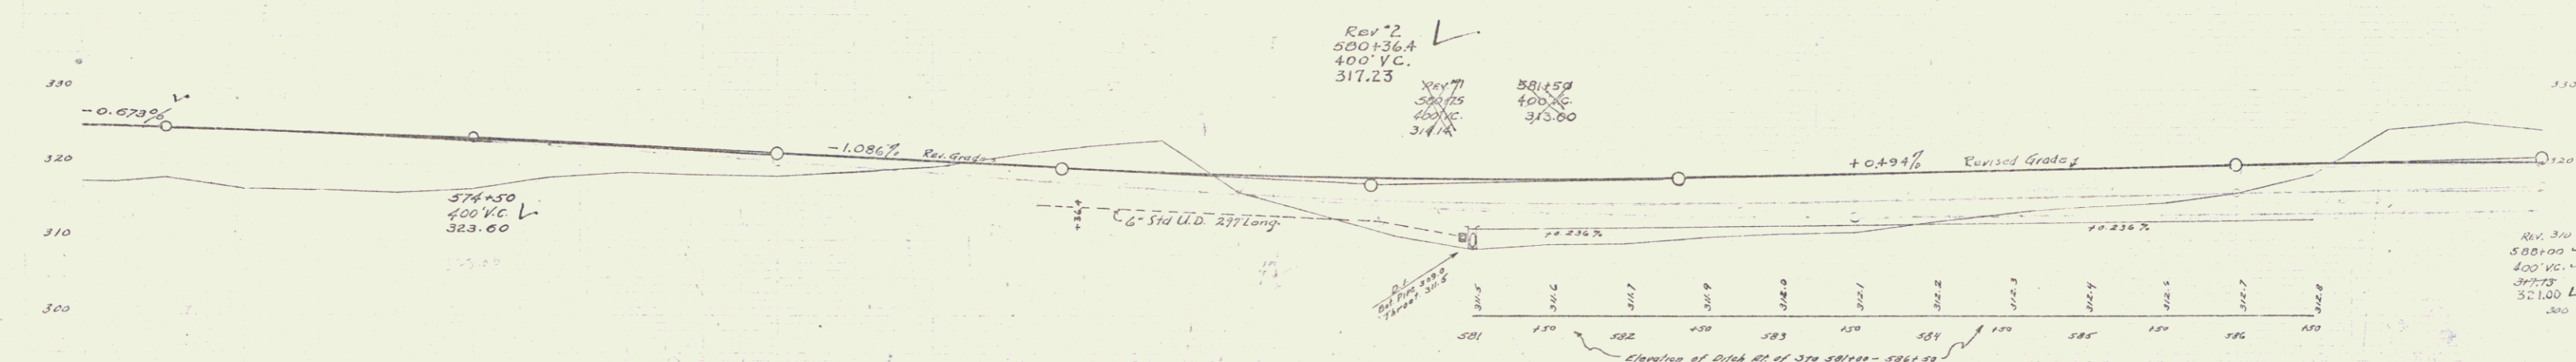

STA	EL. (ft)	REMARKS
572.0	317.9	BM 2-A
572.5	317.4	
573.0	316.7	
573.5	316.6	
574.0	316.2	
574.5	316.0	
575.0	315.9	
575.5	315.8	
576.0	315.8	
BM 2-A Spike in Root 24' Elm Rt. of Sta. 580+80 El. 320.75

SERIES R. NO. 20 SHEET 5 OF 50