



Buttlet
Burg
1936

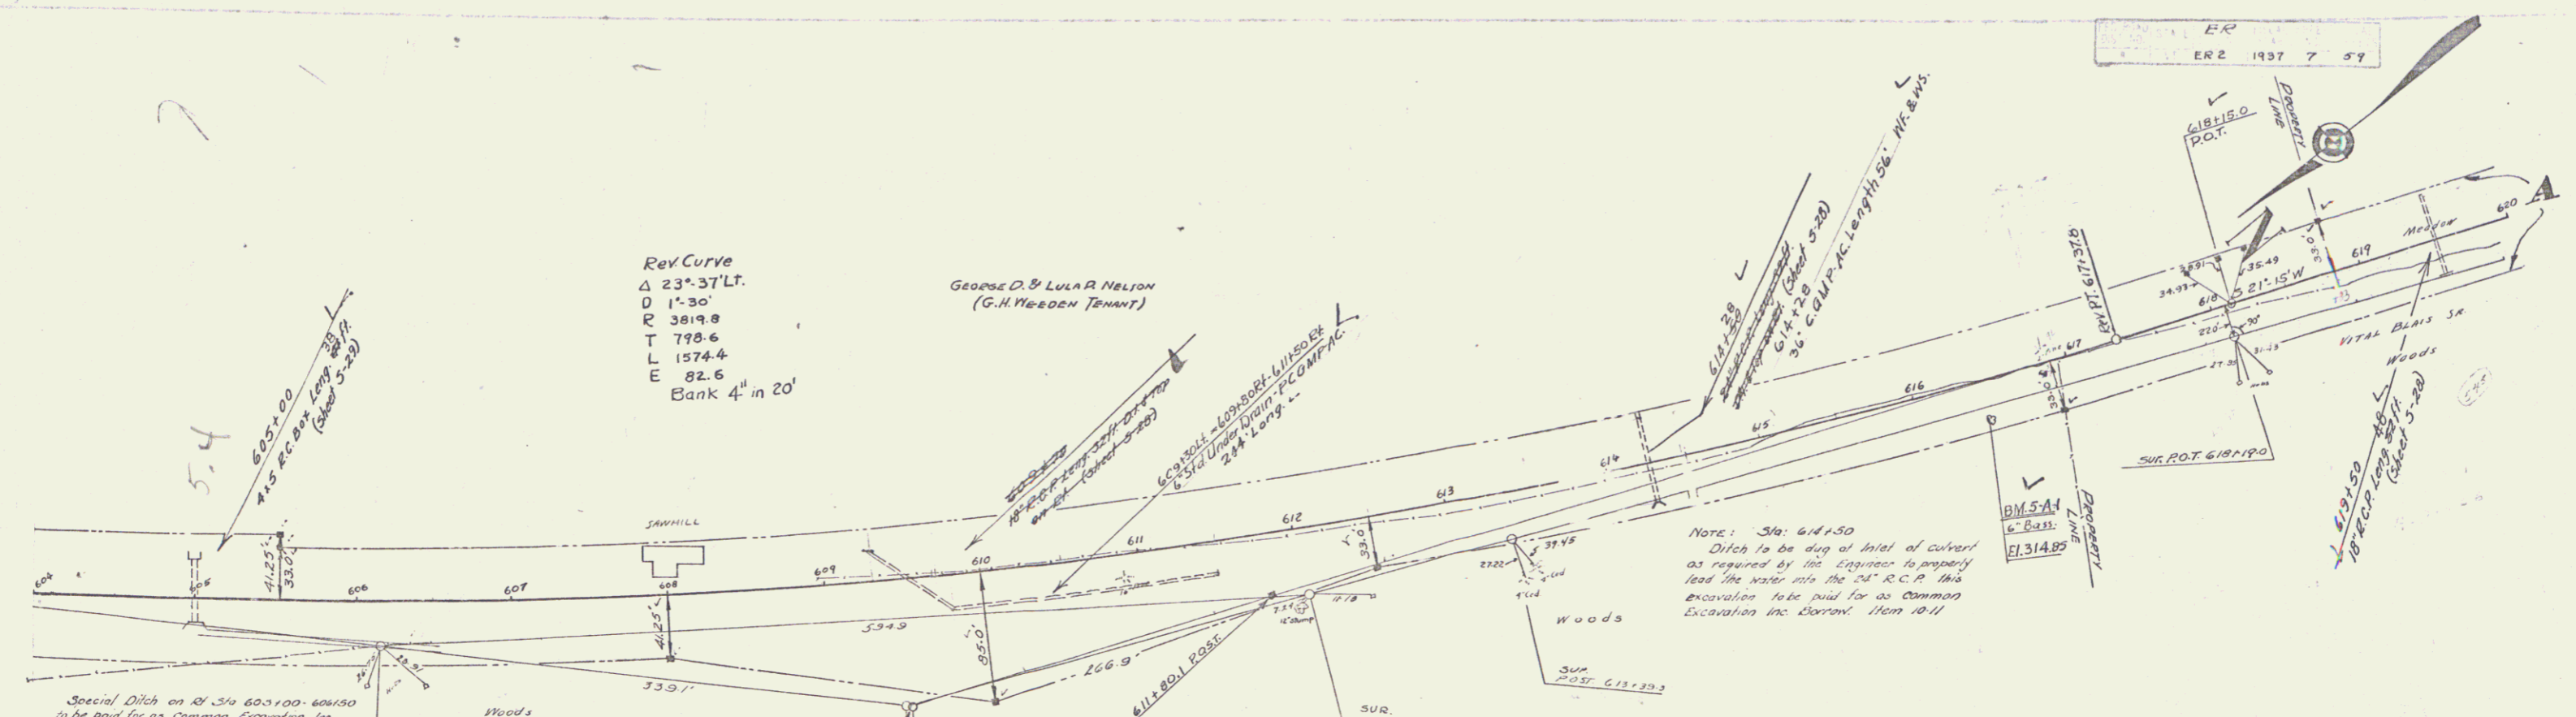

INSTRUMENT	DATE	GRANTOR	GRANTEE	RECORDED BOOK	BASE DATE	REMARKS
A ADMIN DEED	12-30-37	VITAL BLAIS SR ESTATE	STAY FR	44	390	12-31-37
A O.C.D.	12-30-37	ANNIE L. PUTMAN (MORTGAGE)	"	44	382	12-31-37

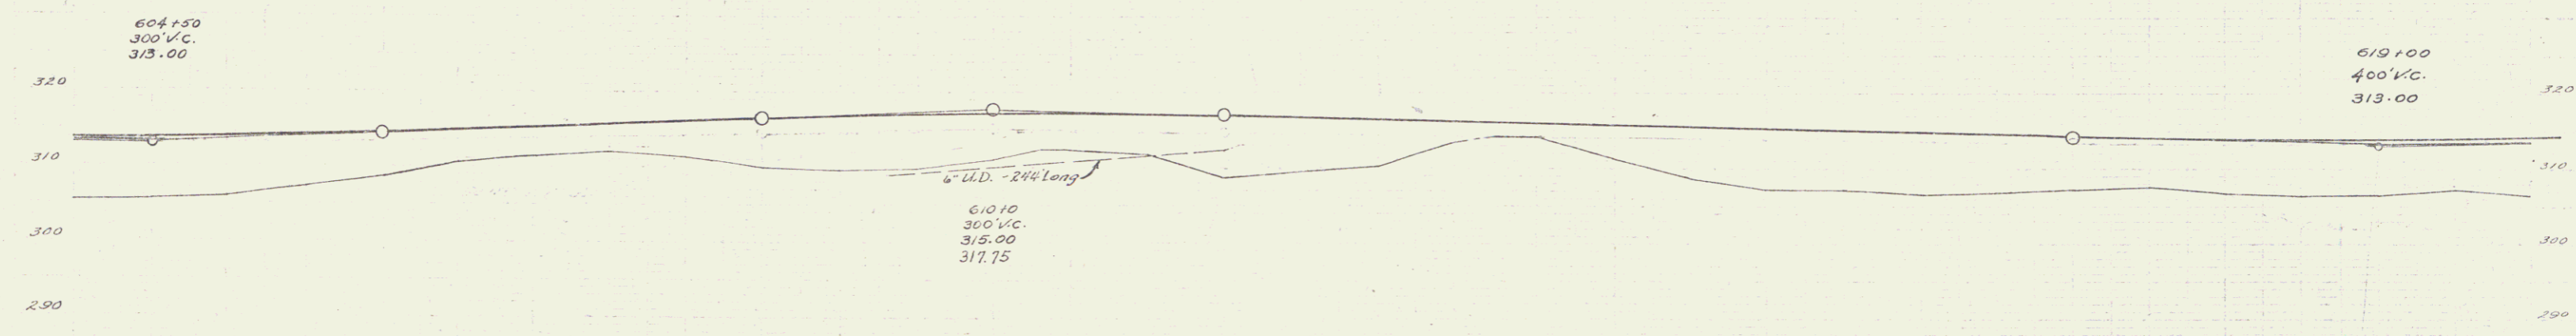

STA. 604+00 TO STA 620+00
12" SUB-BASE OF GRAVEL

STATION	ELEVATION
604+50	313.22
605+00	313.42
605+50	313.62
606+00	313.91
606+50	314.30
607+00	314.73
607+50	315.16
608+00	315.59
608+50	315.80
609+00	316.02
609+50	316.46
610+00	316.83
610+25	317.01
610+50	317.23
610+75	317.26
611+00	317.16
611+25	316.96
611+50	316.69
611+75	316.48
612+00	316.17
612+25	315.90
612+50	315.64
612+75	315.37
613+00	315.11
613+25	314.85
613+50	314.59
613+75	314.32
614+00	314.05
614+25	313.82
614+50	313.65
614+75	313.54
615+00	313.49
615+25	313.51
615+50	313.57

604 B.M. 5' SPIKE IN ROOT OF TREE STA 604+53
606 6" Base 38' RT STA 606+53
610 6" Base 38' RT STA 610+53
615 6" Base 38' RT STA 615+53

610 SERIALS ER NO 2 SHEET 7 OF 59