



Rev. Curve
 Δ 14° 03' Lt.
 D 1°
 R 5729.7
 T 706.1
 L 1405.0
 E 43.3
 Bank 4" in 20'

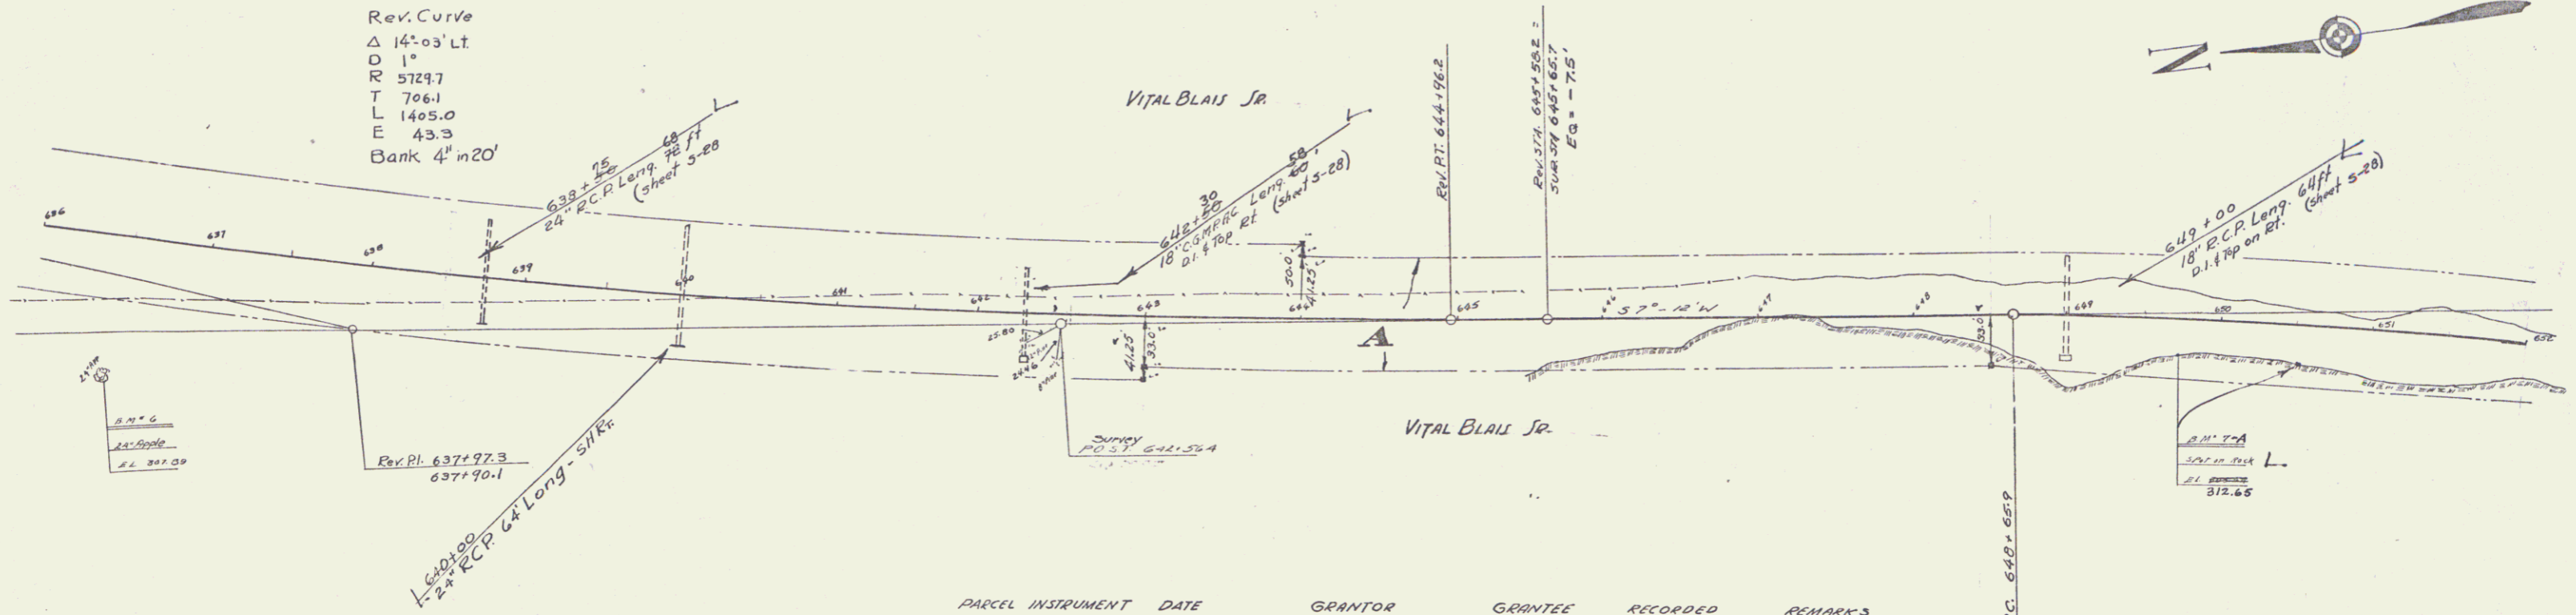

PARCEL	INSTRUMENT	DATE	GRANTOR	GRANTEE	RECORDED	REMARKS
A	ADMIN. DEED	12-30-37	VITAL BLAIS SR. ESTATE	STAFF	SPRINGFIELD BOOK PAGE DATE 44 570 12-31-37	CUL. STA. 619+50 621+00 624+23 637+50 639+50 642+50 647+50 653+00 659+00

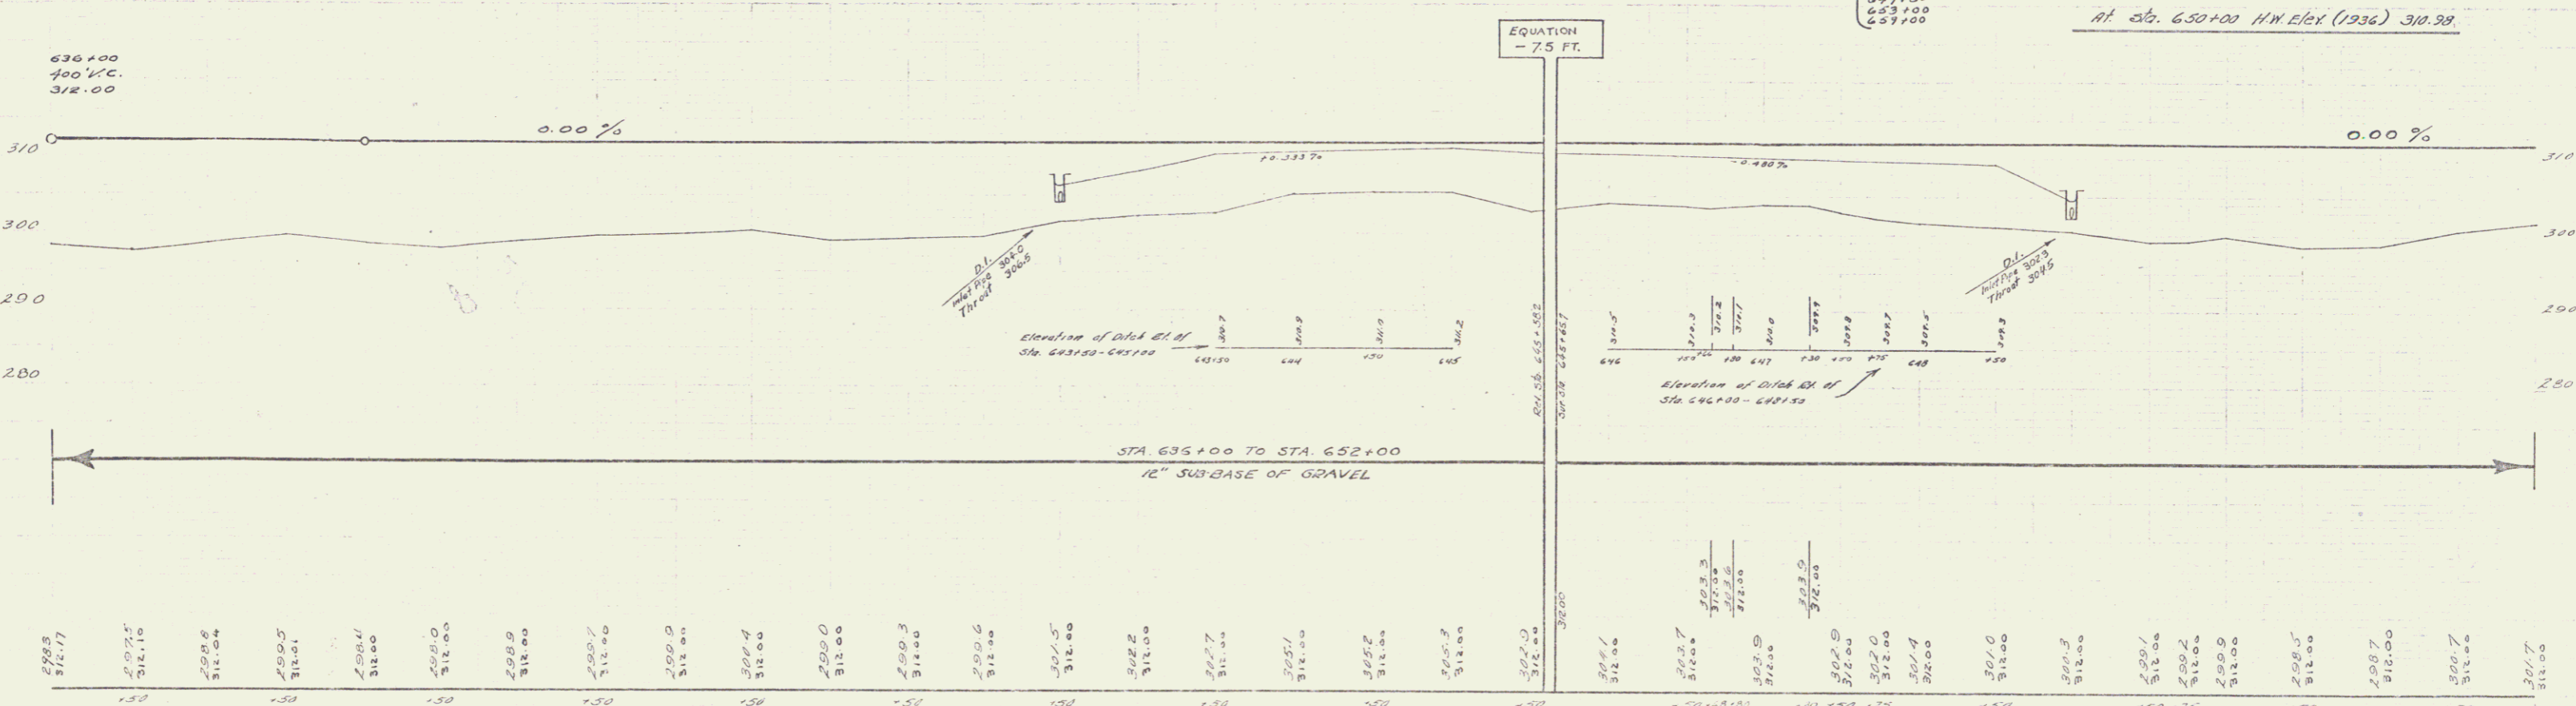

STATION	ELEVATION	STATION	ELEVATION	STATION	ELEVATION	STATION	ELEVATION	STATION	ELEVATION
636	312.17	637	312.16	638	312.04	639	312.01	640	312.00
641	312.00	642	312.00	643	312.00	644	312.00	645	312.00
646	312.00	647	312.00	648	312.00	649	312.00	650	312.00
651	312.00	652	312.00						

636
 B.M. 6 SPIKE IN FOOT OF 24" APPLE B" RT STA 636+43 ELEV 307.89
 B.M. 7A SPOT ON LEDGE 34" RT STA 650+50 ELEV 312.65 L

EQ. -7.5 FT.

SERIES ER NO 2
 SHEET 9 OF 59