
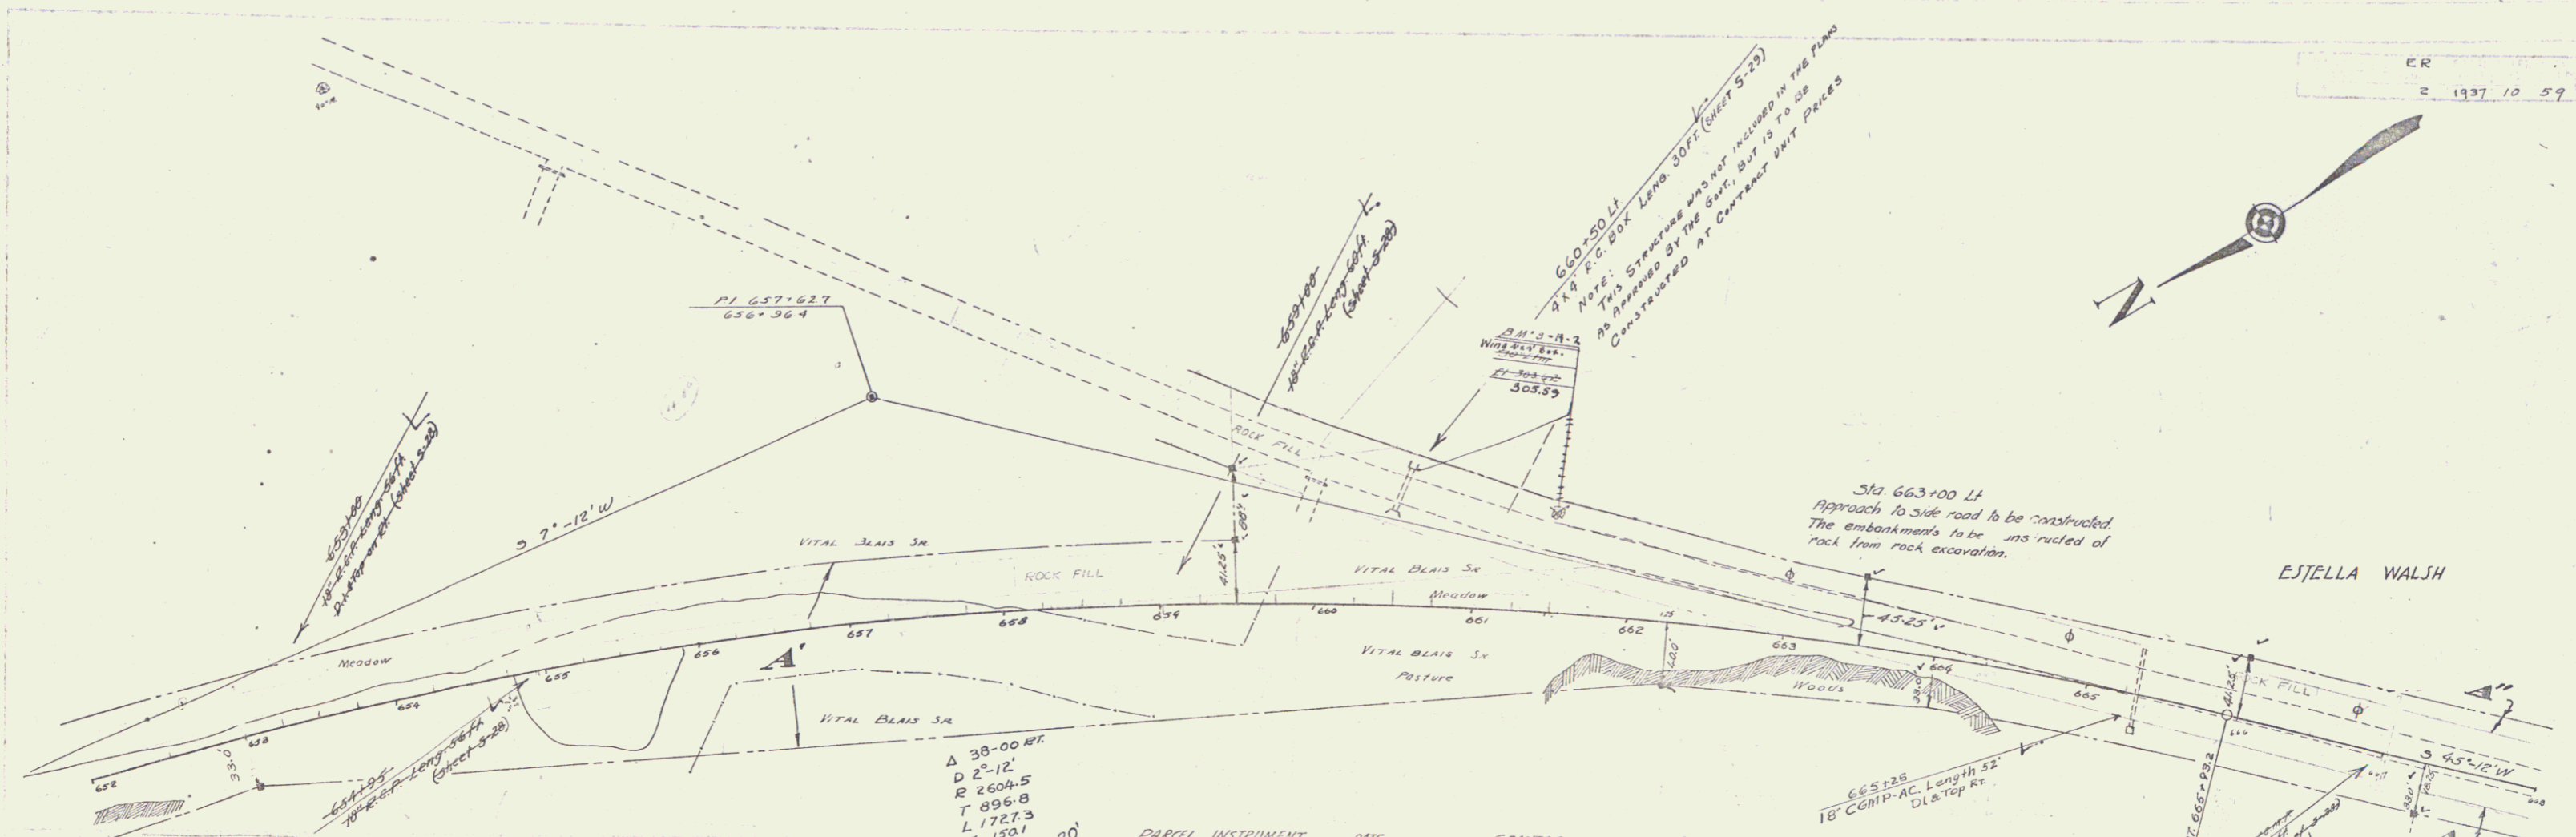



ER
= 1937 10 59

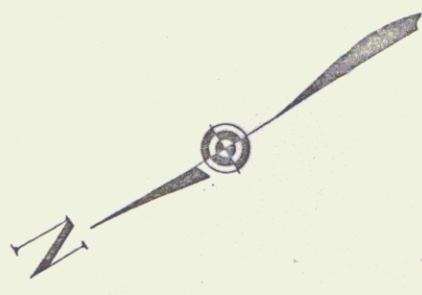

NOTE -- Sta 651+50 - 674+50 LT
Beginning at Sta 651+00 LT the outer four feet of fill is to be made from rock encountered in excavation on the project. This rock fill shall be made full height as shown on Typical Section

Δ 38-00 FT
D 2°-12'
R 2604.5
T 896.8
L 1727.3
E 1501
Bank 6" in 20'

PARCEL INSTRUMENT	DATE	GRANTOR	GRANTEE	RECORDED	REMARKS
A	O.C.D.	DIAMOND MATCH CO		602	SPRINGFIELD
A'	ADMIN. DEED	12-30-37	VITAL BLAIS SR ESTATE	570	VT 44 445 4-27-37
A"	W. D.	12-20-37	ESTELLA WALSH	570	VT 44 377 12-31-37 679100

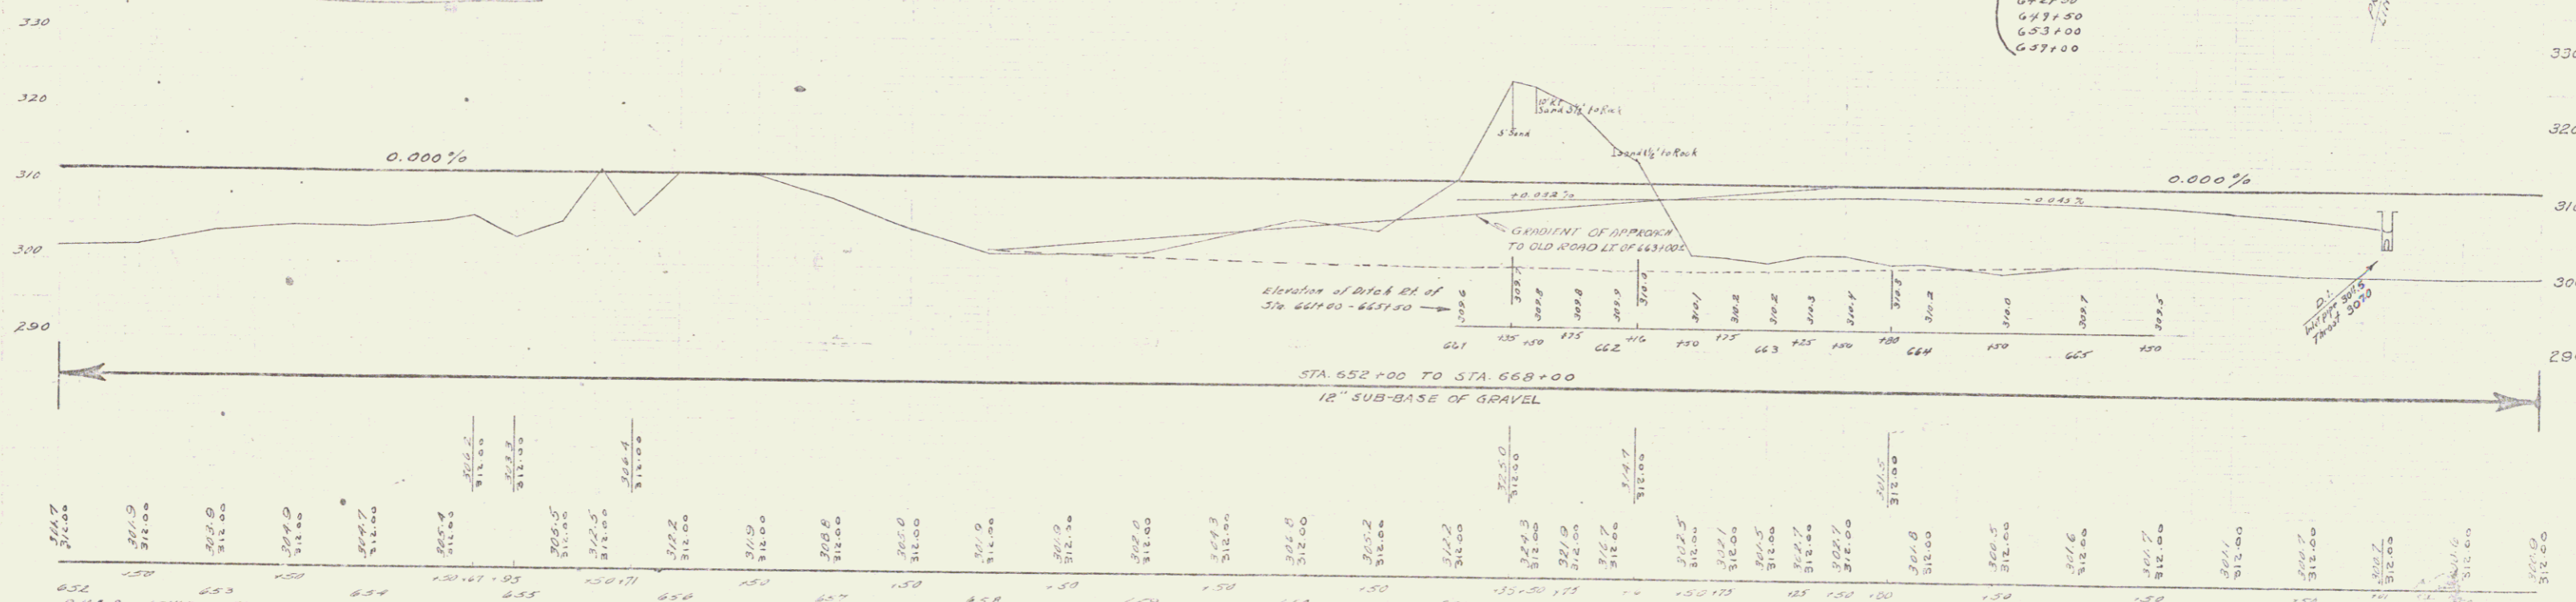

Bl 8-A-7. Spot on Lt. Wing of 4x4 R.C. Box 660+50 Lt Elev. 304.59 V

12311 ER NO 12
SHEET 10 OF 59