

WOOD GUARD RAIL REQUIRED

Stations	Left	Right
349145-349172	24	24
349163-349187	24	-
354153-354177	14	-

CABLE GUARD RAIL REQUIRED

Stations	Left	Right
339100-339180	-	80
349151-349199	-	48
354113-354177	-	64

NEW REIN CONC PIPE CULVERTS REQUIRED

Station	Diam	Len	Conc	Steel
349165	18"	48'	18	54

NEW REIN CONC BOX CULVERTS REQUIRED

Station	Size	Conc	Steel
349160	4'x3'	212	1488
350107	18'x6'	850	6557

CONCRETE CURB AND GUTTER REQUIRED

Station	Left	Right	Length	Conc	Steel
349170-350120	Lt	Rt	30	17	98
349170-350120	Lt	Rt	30	14	48



GRADED COBBLE GUTTER REQUIRED

Station	Left	Right	Length	Area
349170	Lt	Rt	3'-0"	18'

Curb and Gutter of Design as Shown on Sheet 30 (Except That Curb and Gutter is to be lowered to Pavement) to be Built Left and Right of Sta 349170 to Sta 350120 with Graded Cobble Gutter at Sta 349170 on down Face of Fill Slope to Prevent Scour of Embankment.

PARCEL INSTRUMENT DATE GRANTOR GRANTEE RECORDED REMARKS

Parcel	Instrument	Date	Grantor	Grantee	Recorded	Remarks
A	V.D.	3-8-34	JOHN TRYBULSKI	JT of V.	31 219-220 3-19-34	

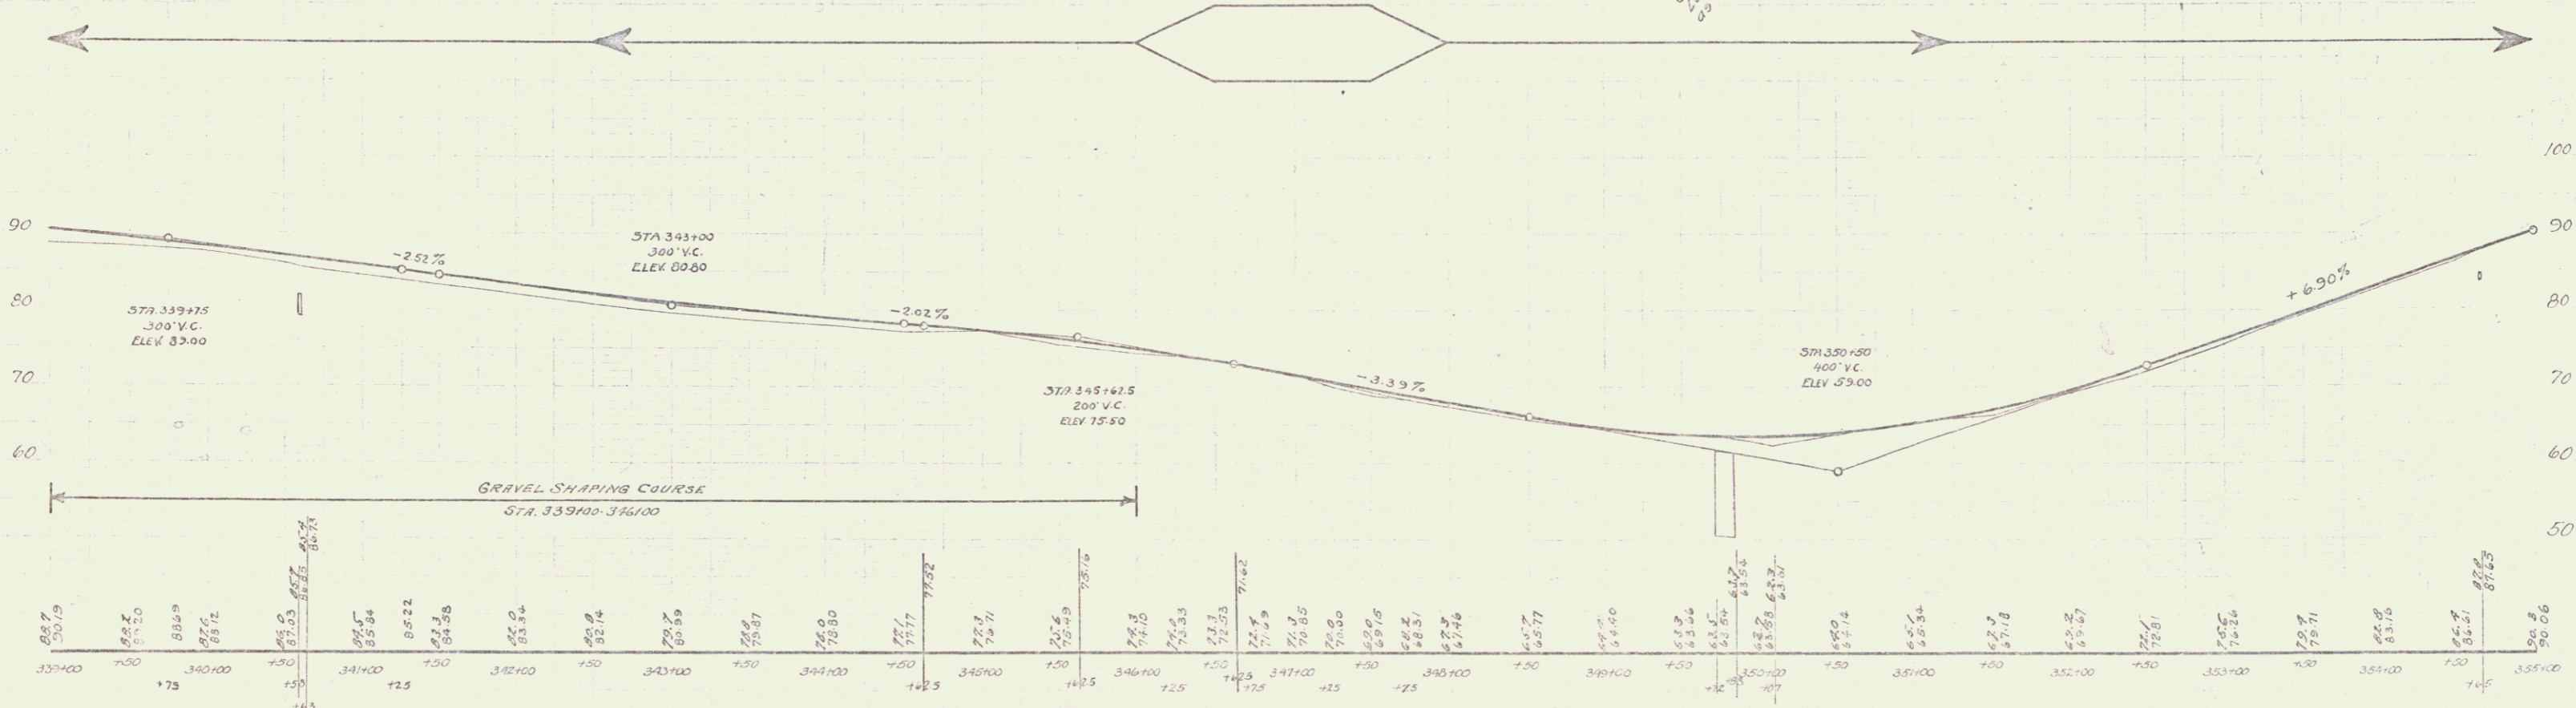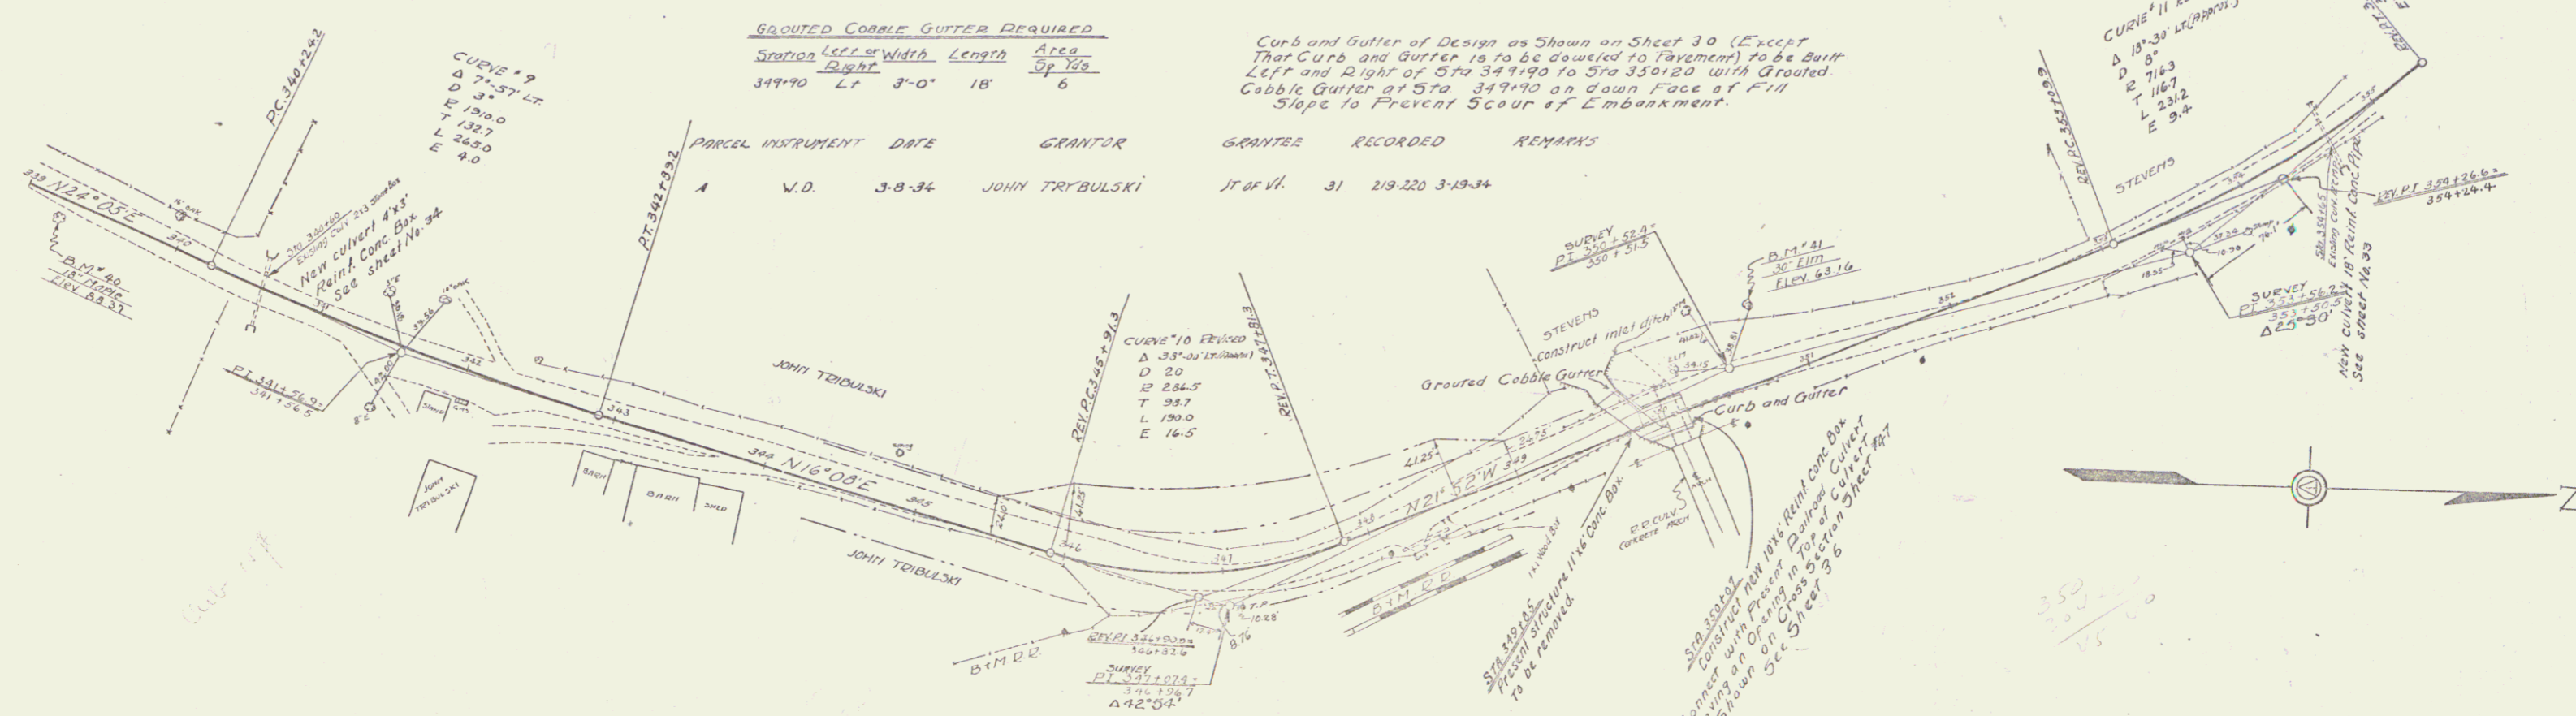

B.M. # 40 - SPIKE INTERV. 15' PABLE, 8 FT. RT. OF STA 339+25 - ELEV 85.37
 B.M. # 41 - SPIKE IN FOOT 30' ELEV, 36 FT. RT. OF STA 350+74 - ELEV 63.16

50705 F 17603 C
 Sheet 7 of 88