
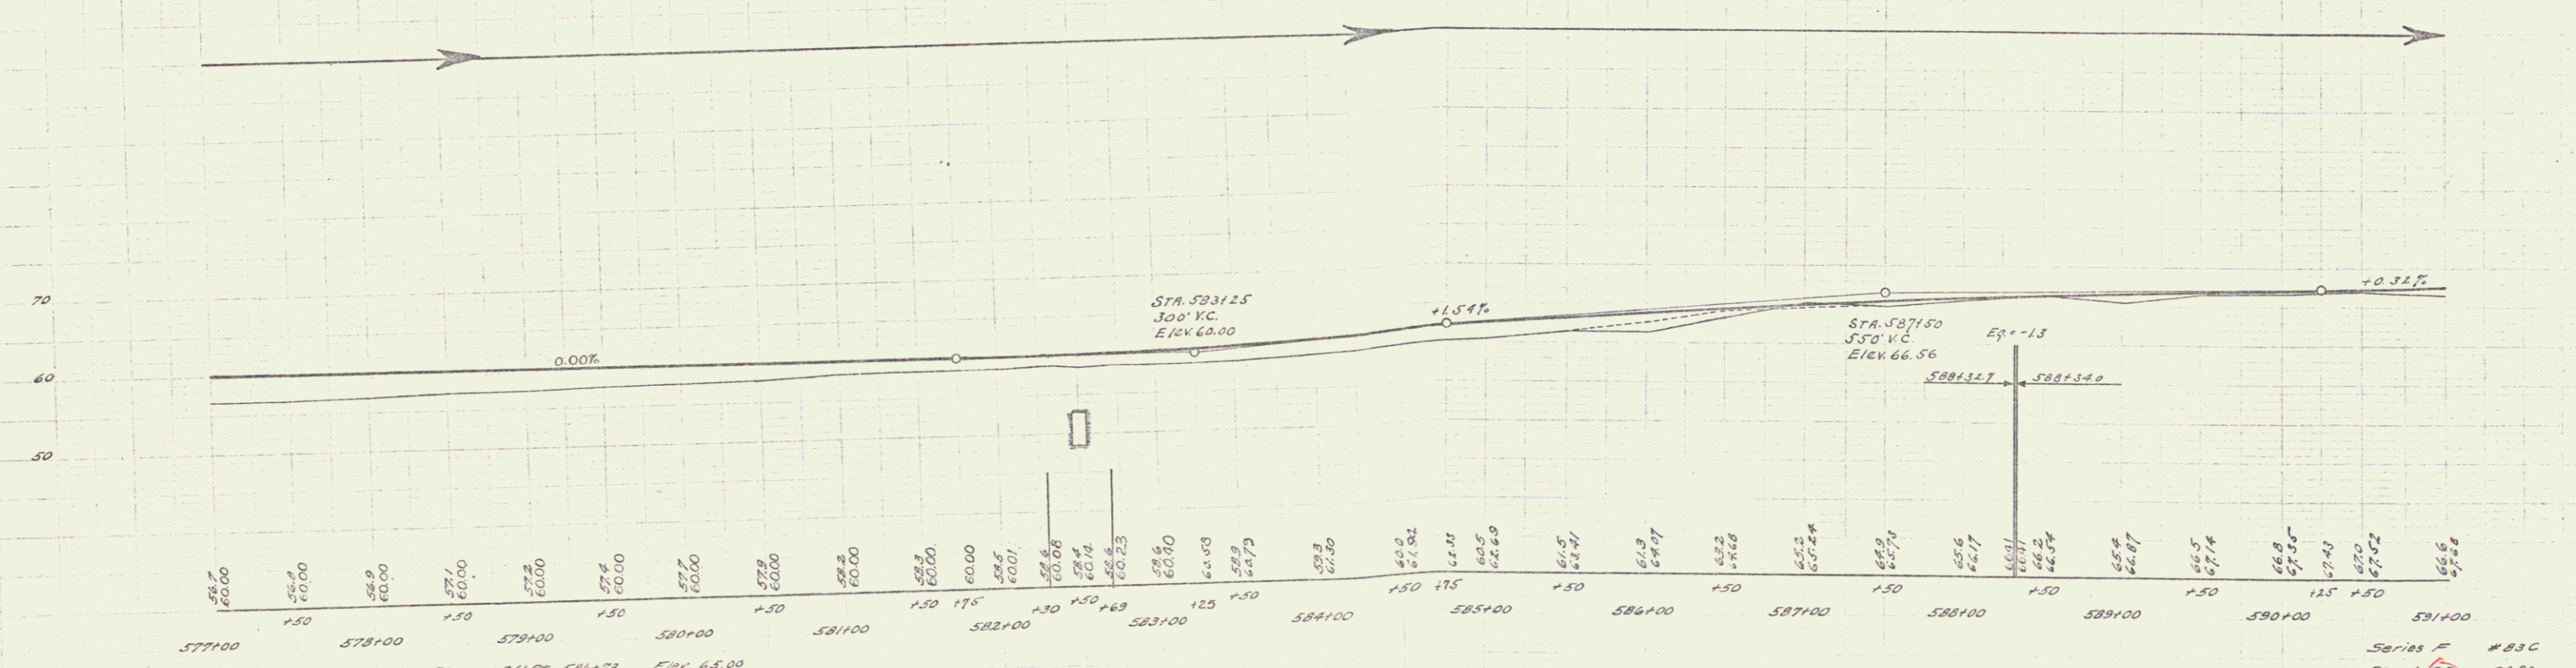


Wood Guard Pile Required  
 110 FE. LIT. FE.  
 Stations 45' Right  
 581150-582162 24 24

NEW RING CONC. BOX CUL. TS REQUIRED  
 Station Size 60' x 36' 3%  
 STEEL 2551

83-C 1929 23 88

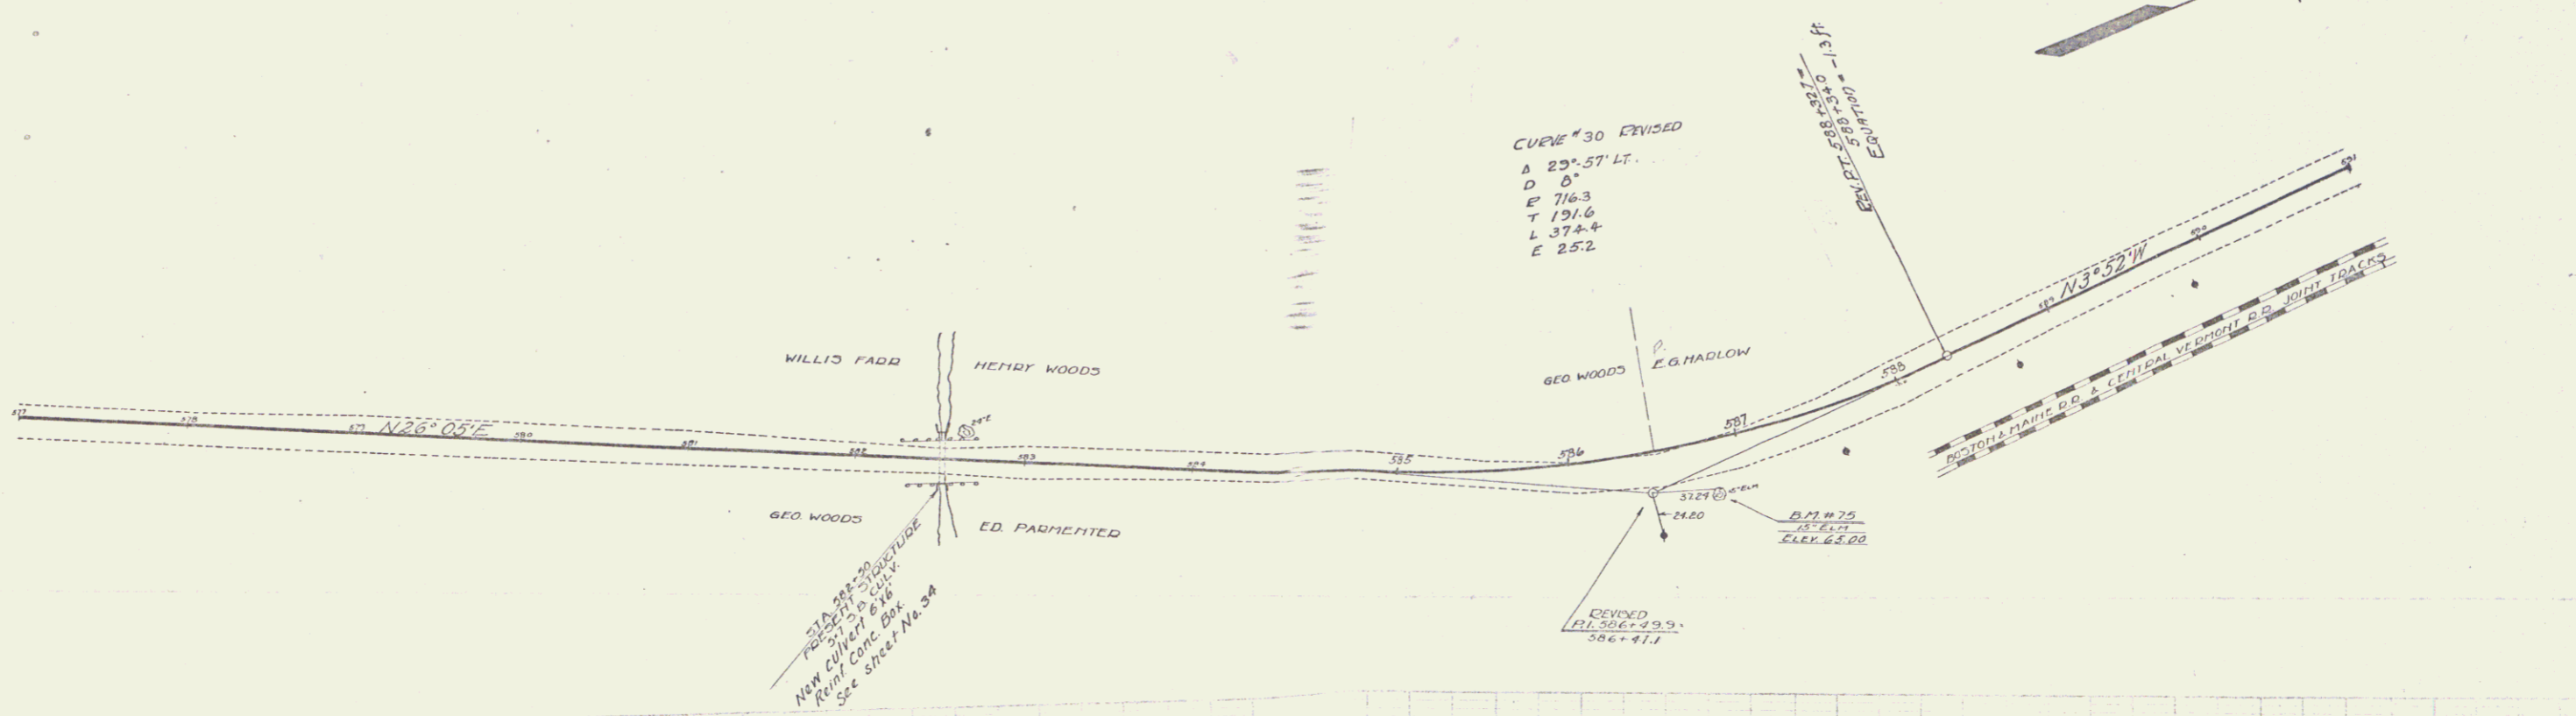

577+00 578+00 579+00 580+00 581+00 582+00 583+00 584+00 585+00 586+00 587+00 588+00 589+00 590+00 591+00  
 D.M. #75 Sp in 24' Elm 26' Rf. 586+73 Elev. 65.00  
 Series A #83C  
 Sheet 23 of 88