



1369
 ROSTERS

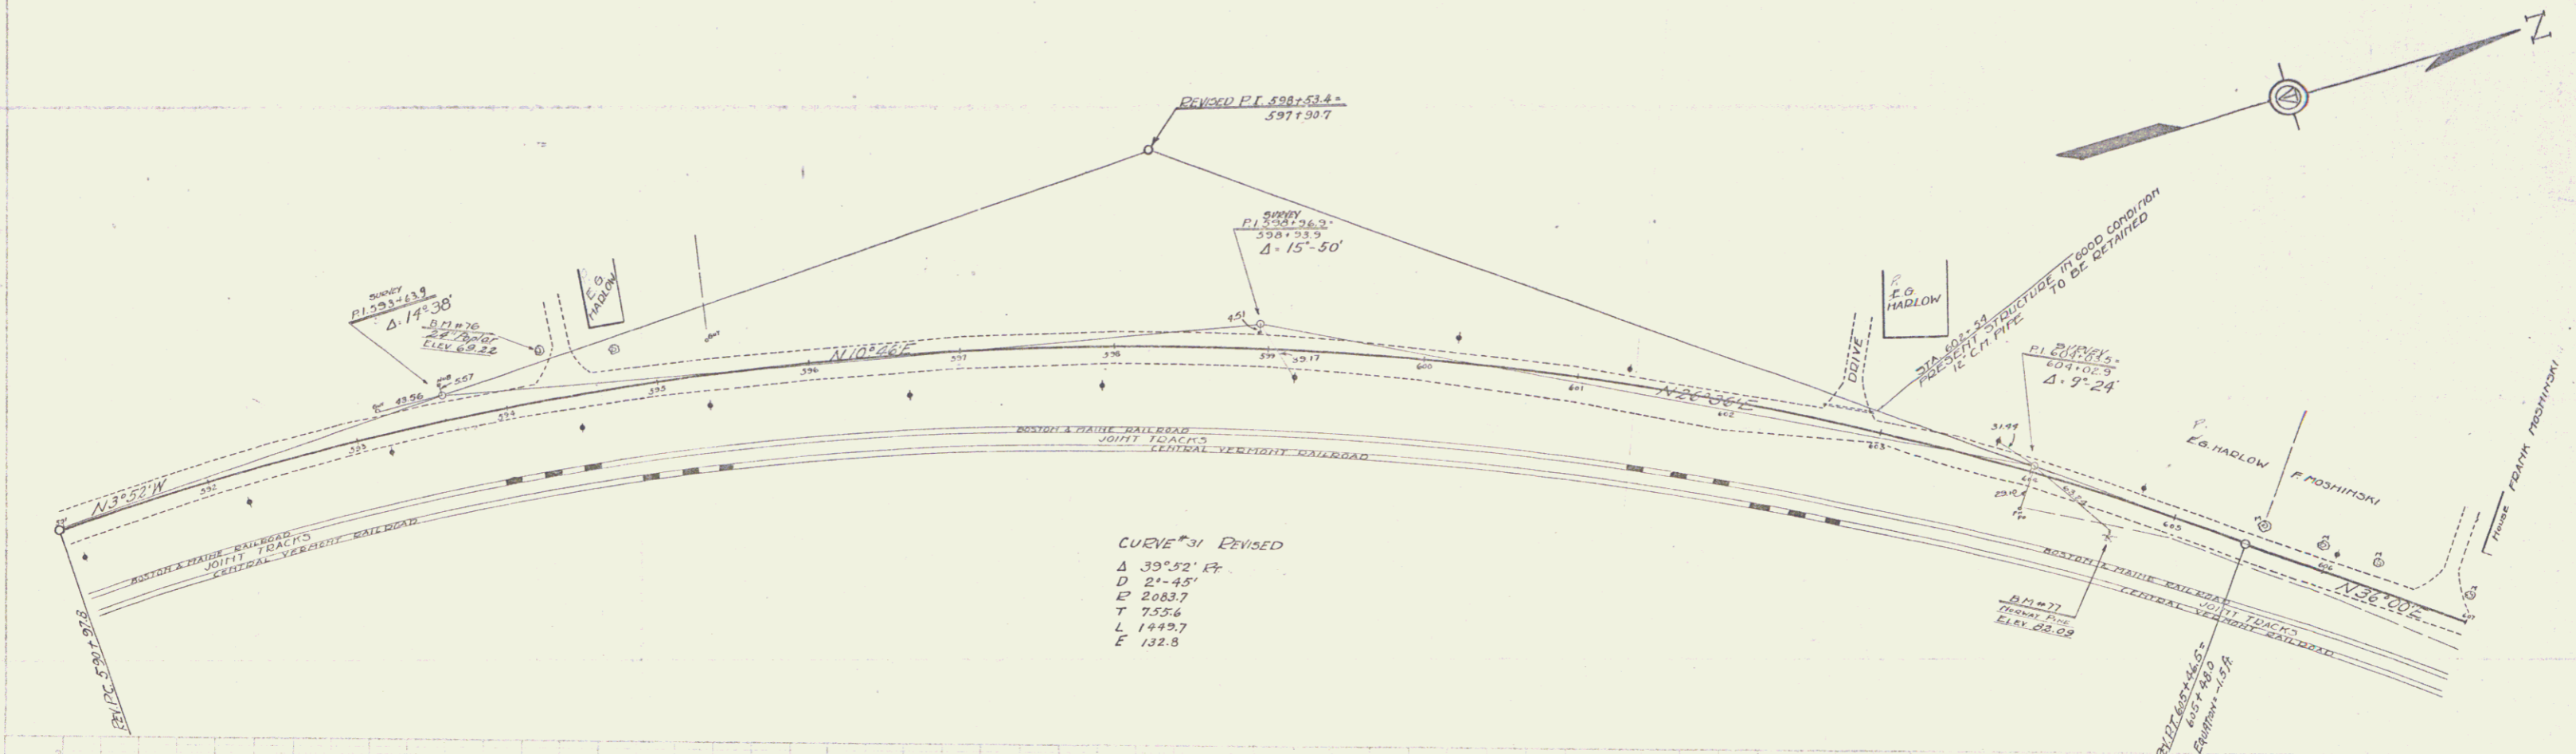

1920
 11-28
 D.C.

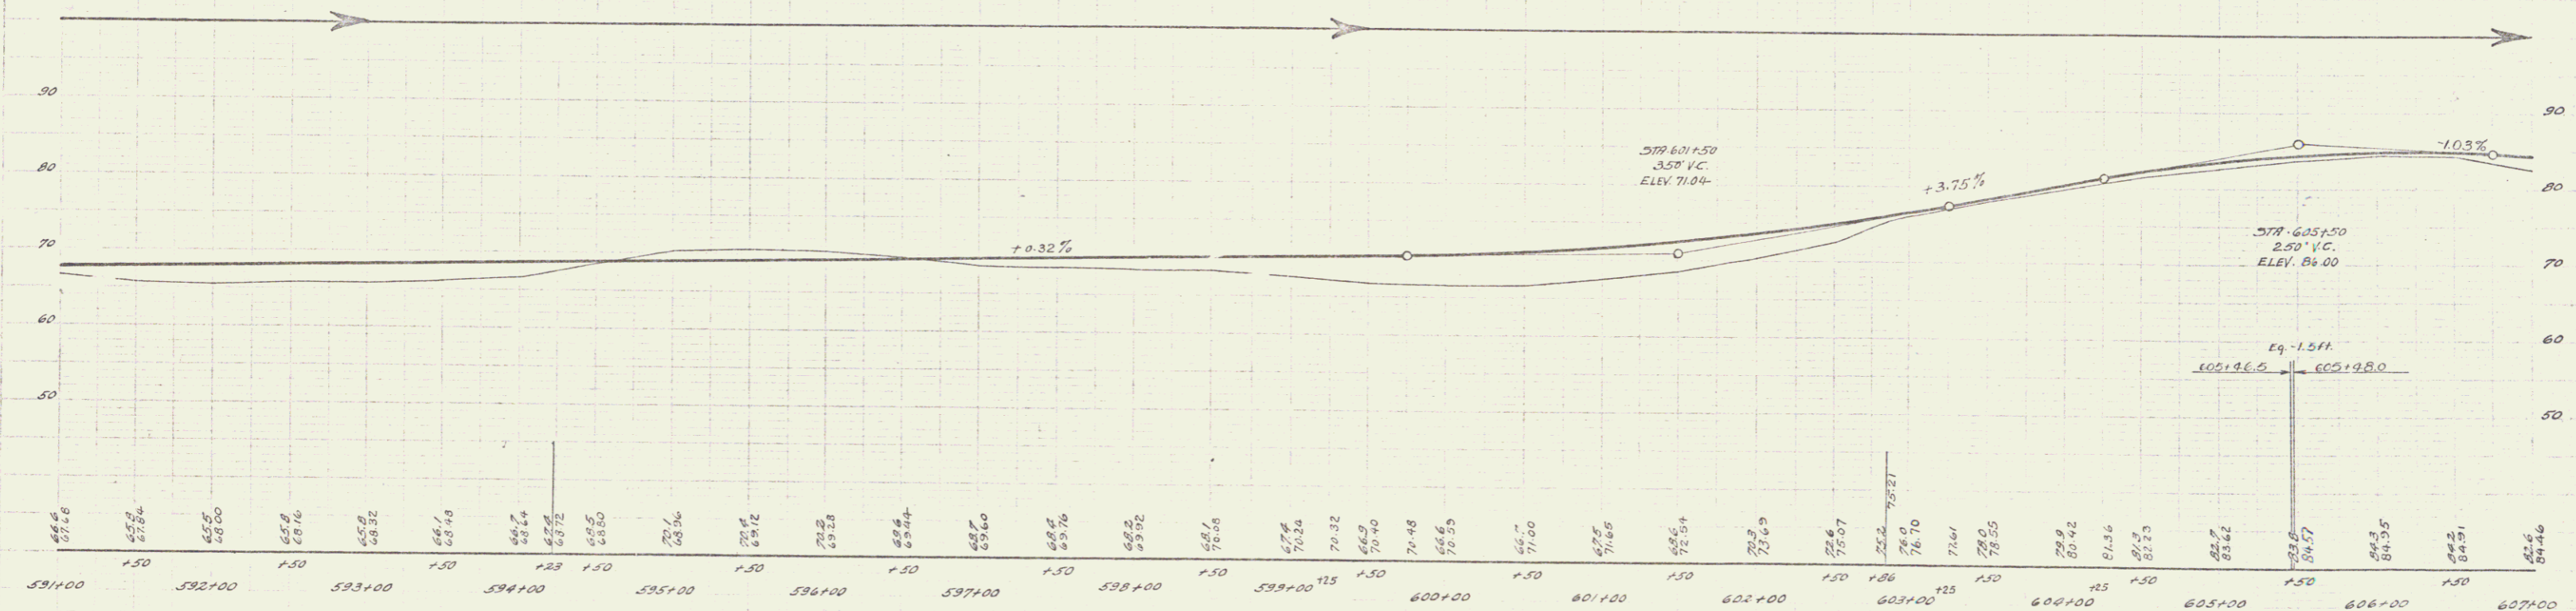

591+00	592+00	593+00	594+00	595+00	596+00	597+00	598+00	599+00	600+00	601+00	602+00	603+00	604+00	605+00	606+00	607+00
67.6	67.8	68.0	68.2	68.4	68.6	68.8	69.0	69.2	69.4	69.6	69.8	70.0	70.2	70.4	70.6	70.8

B.M. #76 Sp. in Roof 24" Paper 29' LT. 594+28 Elev. 69.22
 B.M. #77 Sp. in Roof 10" Navy Pine 21' RT. 604+63 Elev. 82.09

Series F #83C
 Sheet 24 of 28