



WOOD GUARD RAIL REQUIRED			CABLE GUARD RAIL REQUIRED			NEW REINF CONC PIPE CONCRETS REQUIRED		
Stations	Left	Right	Stations	Left	Right	Station	Diag	Length
608140-608144	24	24	61147-61148	24	24	608152	30'	24
614199-615123	24	24				615417	24'	36
618182-619106	24	24				618194	18'	40
								1.8
								54

63-C 1979 Z.5 88

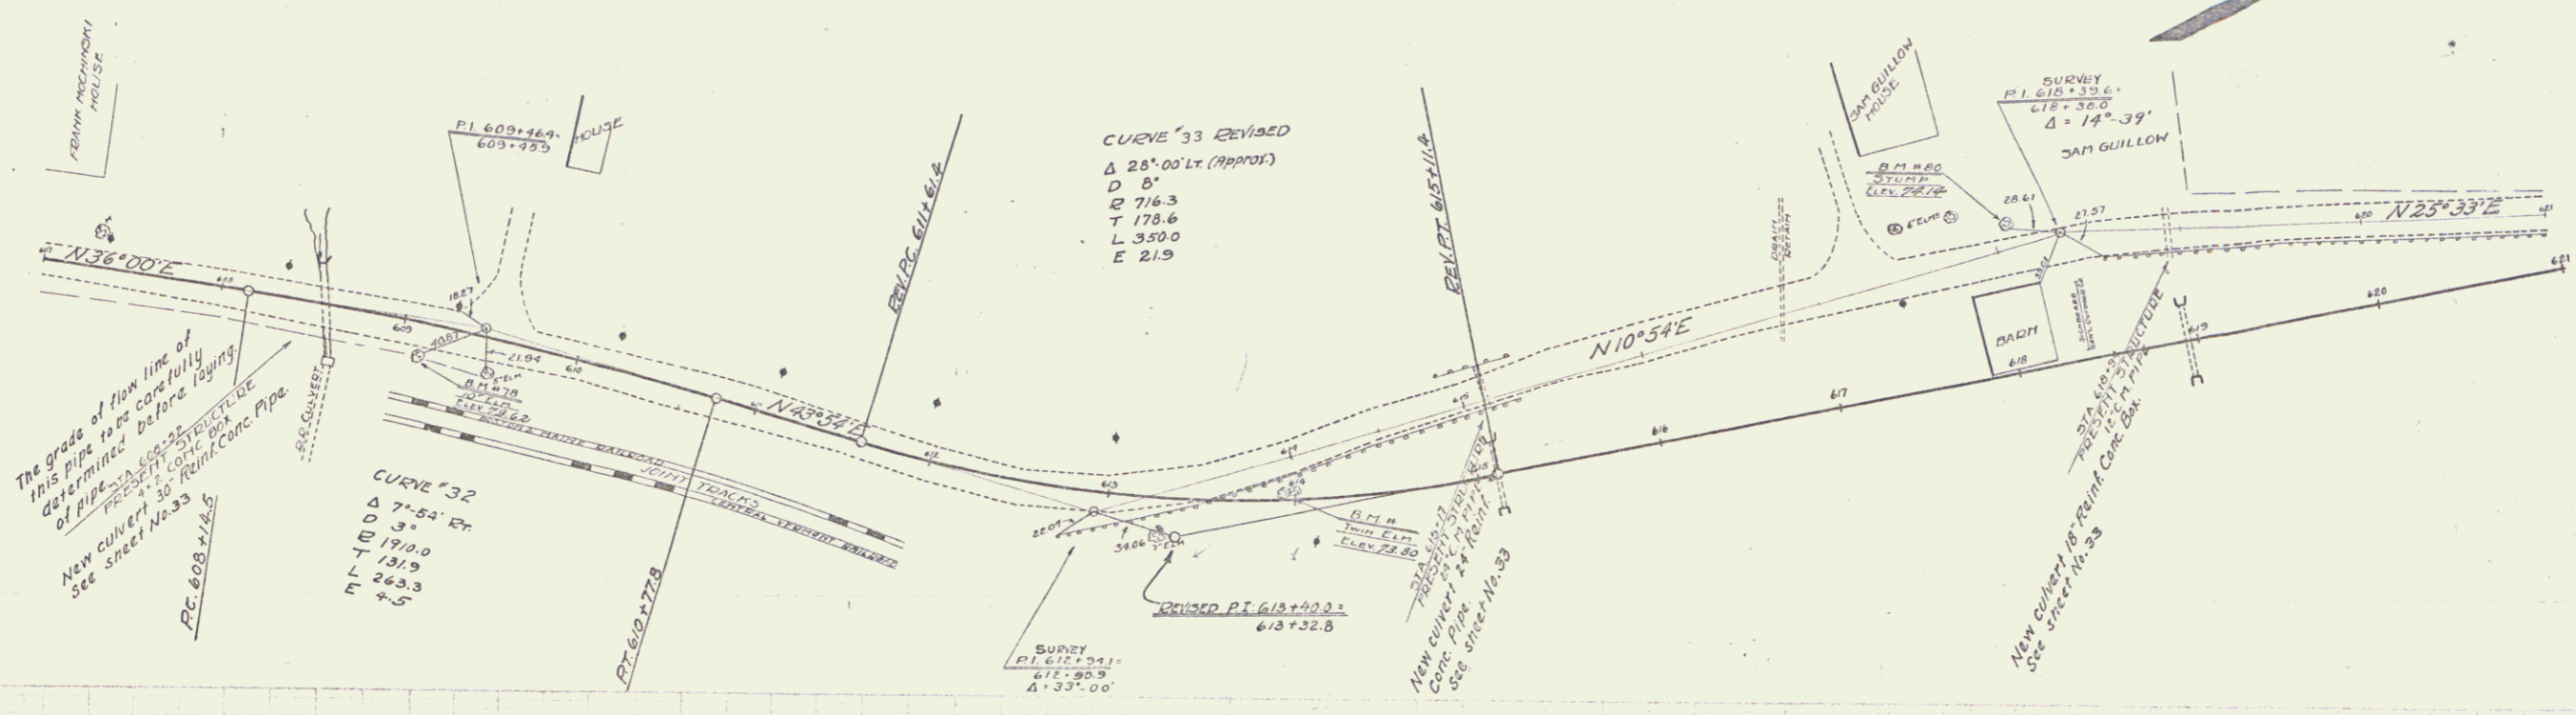

1979
 11-28
 D. M. #78
 D. M. #79
 D. M. #80

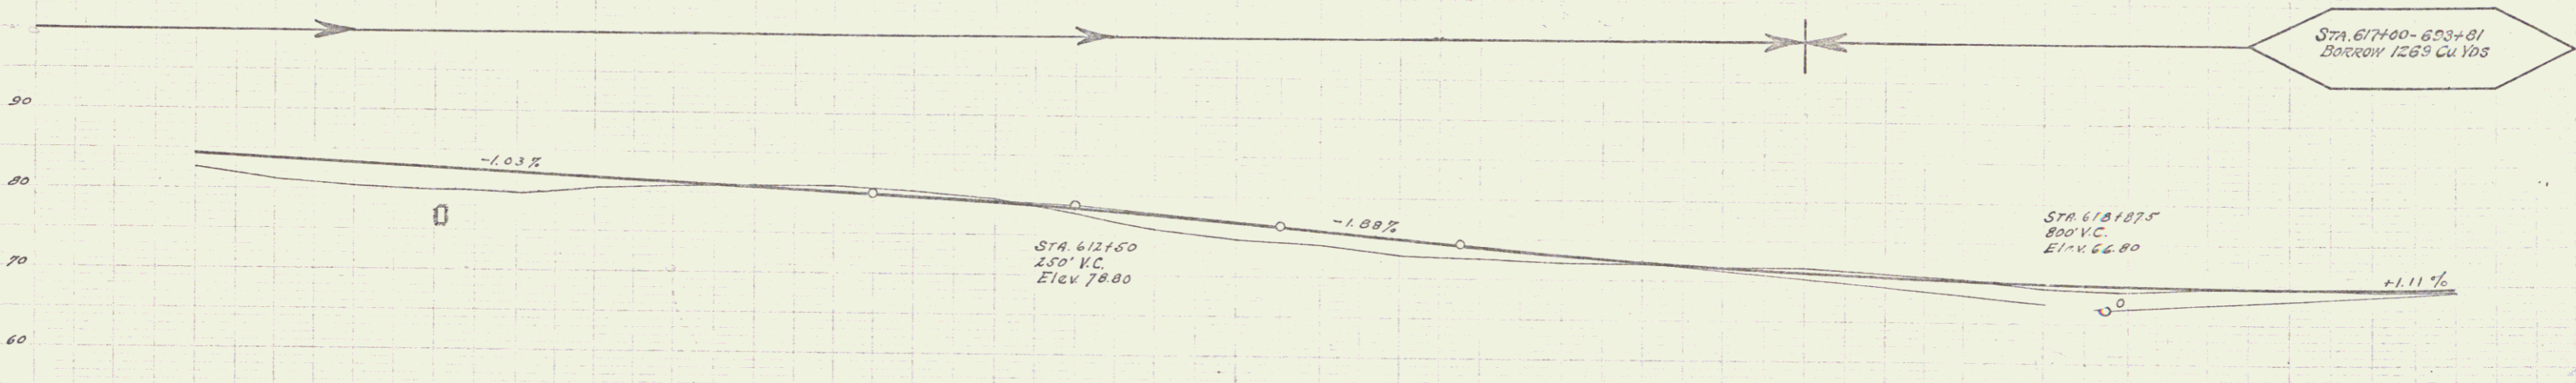

Station	Elev	Station	Elev	Station	Elev	Station	Elev
607+00	74.96	610+00	78.00	613+00	77.79	616+00	72.40
608+00	75.04	611+00	78.05	614+00	74.95	617+00	71.28
609+00	75.12	612+00	78.06	615+00	74.94	618+00	70.72
610+00	75.17	613+00	78.07	616+00	74.93	619+00	70.36
611+00	75.21	614+00	78.08	617+00	74.92	620+00	69.74
612+00	75.24	615+00	78.09	618+00	74.91	621+00	69.27
613+00	75.27	616+00	78.10				
614+00	75.29	617+00	78.11				
615+00	75.31	618+00	78.12				
616+00	75.32	619+00	78.13				
617+00	75.33	620+00	78.14				
618+00	75.34						
619+00	75.35						
620+00	75.36						
621+00	75.37						

B.M. #78 Sp. in Trunk 10' Elm
 B.M. #79 Sp. in Crown Twin Elms
 B.M. #80 Sp. in Top 24" Stump
 15' RT 609+11 Elev 75.10
 16' RT 613+92 Elev 74.14
 14' LD 618+10 Elev 74.14

APR 17 1979

Series F #83C
Sheet 25 of 88