

**Wood Skunk Rail Required**

Stations	Length	Right
6431.12-6431.36	24	-
6461.32-6471.16	14	-
6501.08-6511.00	12	12

**Cable Skunk Rail Required**

Stations	Length	Right
6411.00-6471.08	-	668



**NEW RAIN CONC. PIPE CULVERTS REQUIRED**

Station	Diam.	Length	Conc. B.	Steel	D.I.
6431.24	24"	44	2.9	184	1
6471.24	18"	36	1.8	54	-
6511.00	18"	32	2.2	138	1

85-C 1929 27 88

DOE N. SIEMENS 1929

DOE N. SIEMENS 11-29

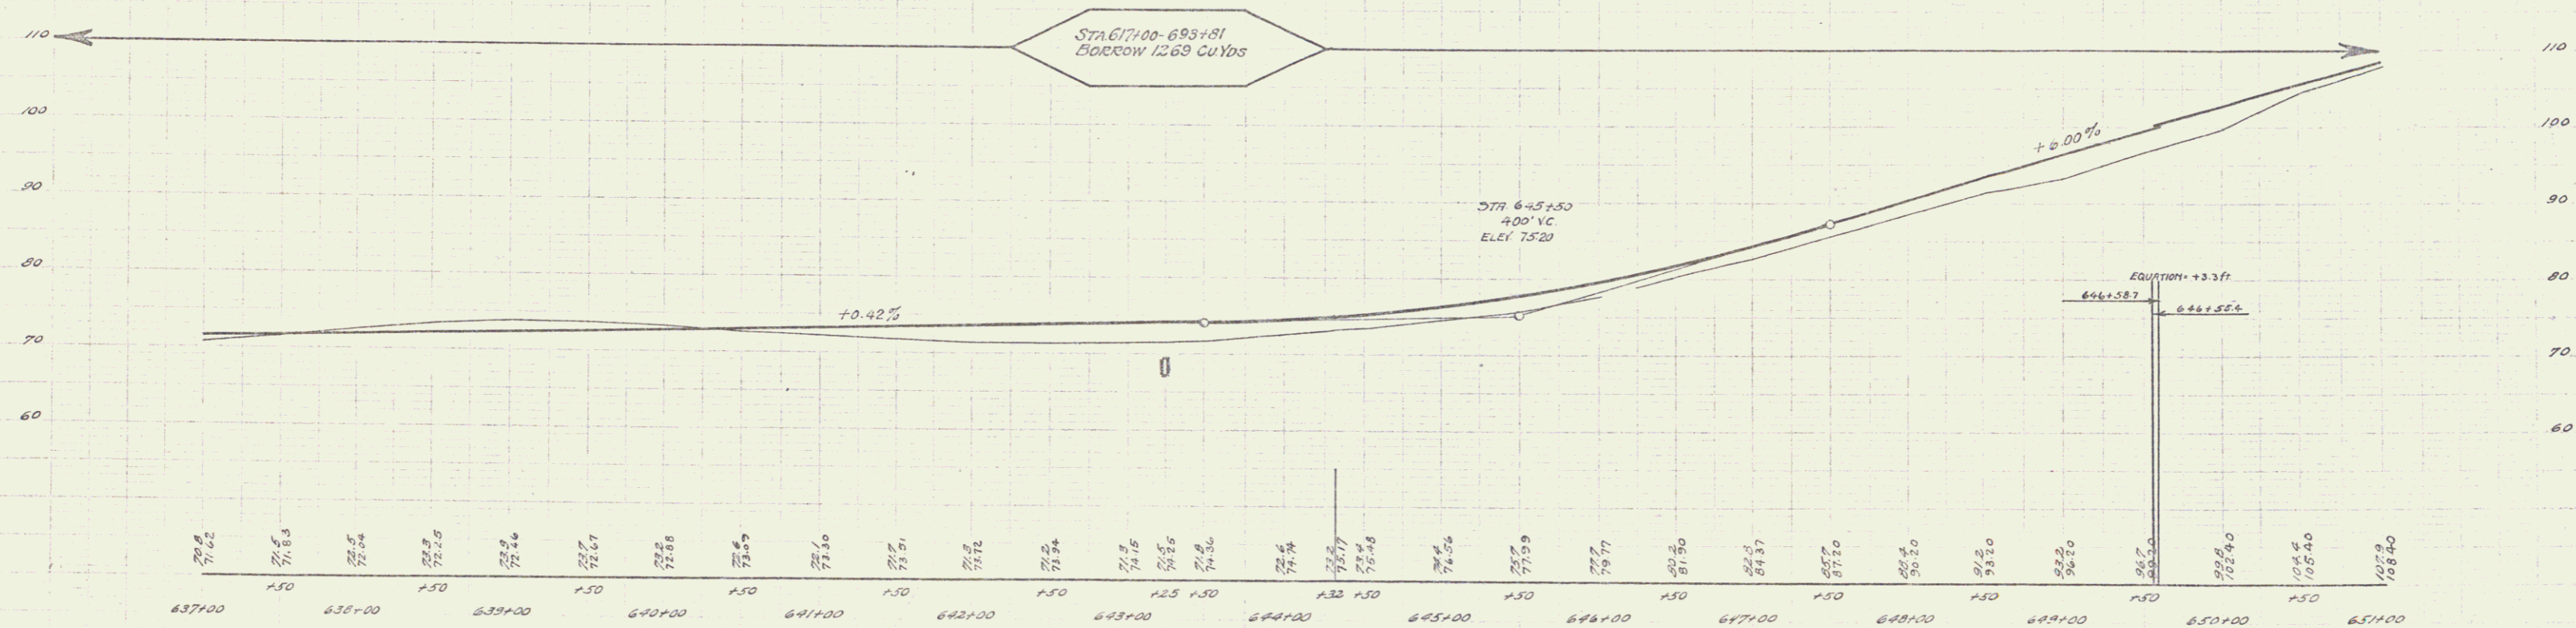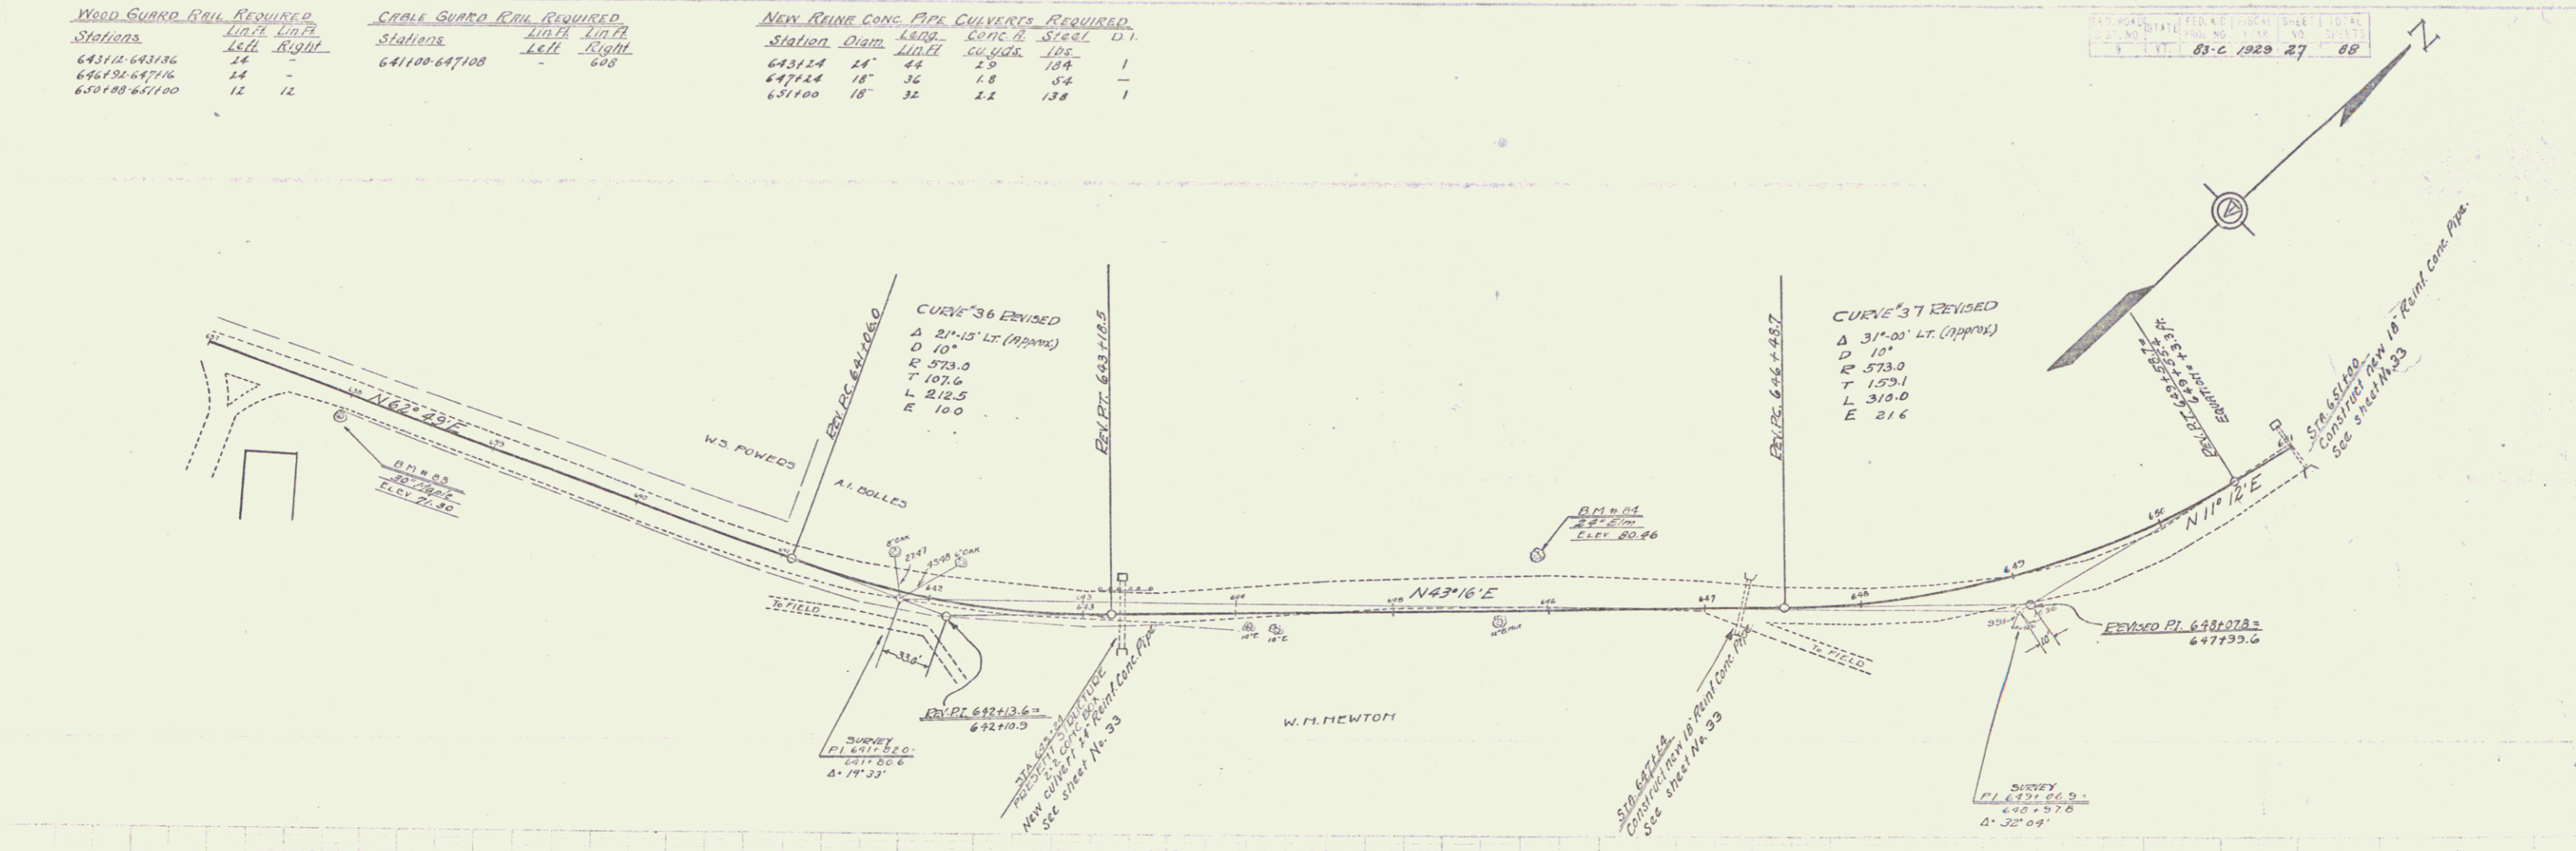

Station	Elevation	Notes
637+00	71.62	B.M. #83
638+00	71.65	B.M. #84
639+00	72.04	Sp. in Trunk 30" Maple
640+00	72.10	Sp. in Root 24" Elm
641+00	72.16	
642+00	72.67	
643+00	72.86	
644+00	73.05	
645+00	73.80	
646+00	74.51	
647+00	75.12	
648+00	75.74	
649+00	76.34	
650+00	76.94	
700+00	106.94	

APR 17 1979

Series F # 83 C  
Sheet 27 OF 88

25