

1 TITLE PAGE
 2 TYPICAL SECTION (GRADING AND DRAINAGE)
 3 QUANTITY SHEET
 4 ITEM DETAIL AND DRAINAGE SHEET
 5 EARTHWORKS
 6-11 PLAN AND PROFILE SHEETS
 12 INTERSECTION DETAILS
 13 A-6 DRILLING AND BLASTING
 14 B-1 BANKING TABLES
 15 B-5 TYPICAL SLOPE GRADING
 16 B-10 EMBANKMENT ON A SLOPE
 17 B-16 DIVISIONAL ISLANDS - STORAGE LANES
 18 D-2 CEMENT RUBBLE MASONRY
 19 D-4 DRAINAGE
 20 D-8 R.C.P.D.I.
 21 BLANK
 22 D-13 CONCRETE CATCH BASIN
 23 E-1 BARRICADES, SIGNS AND LIGHTS
 24 E-9 CONSTRUCTION IDENTIFICATION SIGNS
 25 BLANK
 26 BLANK
 27 BLANK
 28-59 CROSS SECTIONS

* STAGE 2 CONSTRUCTION - INDEX
 1 TITLE PAGE
 2 TYPICAL SECTIONS - SUBBASE & SURFACE
 3 QUANTITY - ITEMS
 4 ITEM DETAIL & DRAINAGE SHEET
 5 EARTHWORKS
 6-11 LAYOUTS & PROFILES
 12 INTERSECTION DETAILS
 13 SIGN SUMMARY
 14 SIGN LOCATION
 15 SIGN DESIGN
 16 B-1 BANKING TABLE
 17 B-15 ENTRANCE & EXIT TERMINALS
 18 B-16 DIVISIONAL ISLAND
 19 C-1 CURBS
 20 D-3 SUTTERS
 21 D-8 D.I.'S
 22 D-10 D.I. TOPS
 23 D-11 CATCH BASIN GRATES
 24 D-13 CATCH BASINS
 25 D-18 PRECAST CURB D.I.'S
 26 E-1 BARRICADES, SIGNS & LIGHTS
 27 E-3 REGULATORY SIGNS
 28 E-4 ROUTE MARKERS
 29 E-5A SIGN POST FOOTINGS
 30 E-6 WARNING & GUIDE SIGNS
 31 E-7 SIGN PLACEMENT
 32 E-9 FEDERAL AID IDENTIFICATION SIGNS
 32-A E-10 OVERLAP PLYWOOD SIGNS
 33 G-3 THREE CABLE GUARD RAIL
 34 G-4 MARKER POSTS
 35 J-1 PROJECT MARKERS
 36-68 CROSS SECTIONS

CONTRACT NAME & NUMBER	TYPE PAVEMENT	AREA
WESTMINSTER F-341-1(2)	CONCRETE	0.582 MI.

ITEM	QUANTITY	UNIT	PRICE	TOTAL
GRAVEL BACKFILL - PARDA & WADE PITS - WESTMINSTER, VT.				
CONCRETE CLASS "B" - CHARLESTOWN READY MIX INC. - CHARLESTOWN, N.H.				
REINFORCING STEEL - BETHLEHEM STEEL CORP. - BETHLEHEM, PA.				
REINFORCED CONCRETE PIPE - MARTIN MARIETTA CO. - WINDSOR, VT.				
A.C.C.O. METAL PIPE - NORTHEASTERN METAL CULVERT CO. - WESTMINSTER, VT.				
WOOD GUIDE POSTS - ST. GEORGE & CO. INC. - ESSEX JCT., VT.				

CONTRACTOR - PERINI CORP. - FRAMINGHAM, MASS.
 RES. ENG. - ST. MORRIS
 INSPECTOR - J. W. PINKHAM & H.E. GROSS.
 RECORD PLANS - K. W. PINKHAM
 CONTRACT DATED - DEC. 26, 1961.
 STARTED - FEB. 23, 1962.
 COMPLETED - JAN. 17, 1963.
 ACCEPTED - JAN. 17, 1963.

WESTMINSTER F-341-1(2)(3)
 CONTRACTOR - PERINI CORP. - FRAMINGHAM, MASS.
 STAGE 1
 RECORD PLANS - K. W. PINKHAM - R. HAUGER
 CONST. COMP. - JAN. 10, 1963. - OCT. 17, 1963.


FEDERAL AID
Town of Westminster

U.S. ROUTE #5 TO INTERSTATE

BEGINNING AT A POINT 5.892 MILES NORTHERLY OF PUTNEY - WESTMINSTER TOWN LINE AND EXTENDING WESTERLY 0.582 MILES
 LENGTH OF PROJECT 3,075 FEET = 0.582 MILES

DESIGN DESIGNATION	ADT (1960)	ADT (1970)	DHV (E75)	T	V	MPH
	1210	2330	405	56	8%	50

Project: F341-1(2)(3)
 Pin # 99R374
 Route: ST HWY

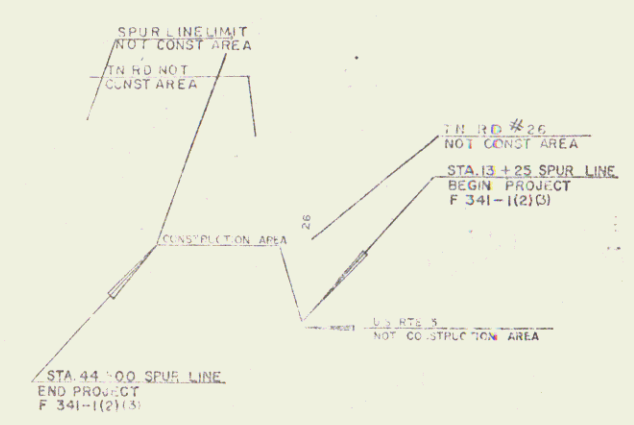

RIGHT-OF-WAY DIVISION
 TOWN FILE
 PERPETUAL
 Town of US-5
 (To Be Returned To R.O.W. Division)

STAGE 2 CONSTRUCTION
 SHEET 1 OF 68 SHEETS

E. H. [Signature] 5/2/61
 L. E. [Signature] 5/3/61
 R. O. [Signature] 5/21/61
 G. M. [Signature] 8/27/61
 A. C. [Signature] 8/3/61

F 341-1
 1 59