


PARCEL	KIND OF INSTRUMENT	DATE	GRANTOR	GRANTEE	RECORDED	REMARKS
A.B.	G.C.D.	9-3-35	A.B. WILMOT	S.J. O'VI.	291-292-293	

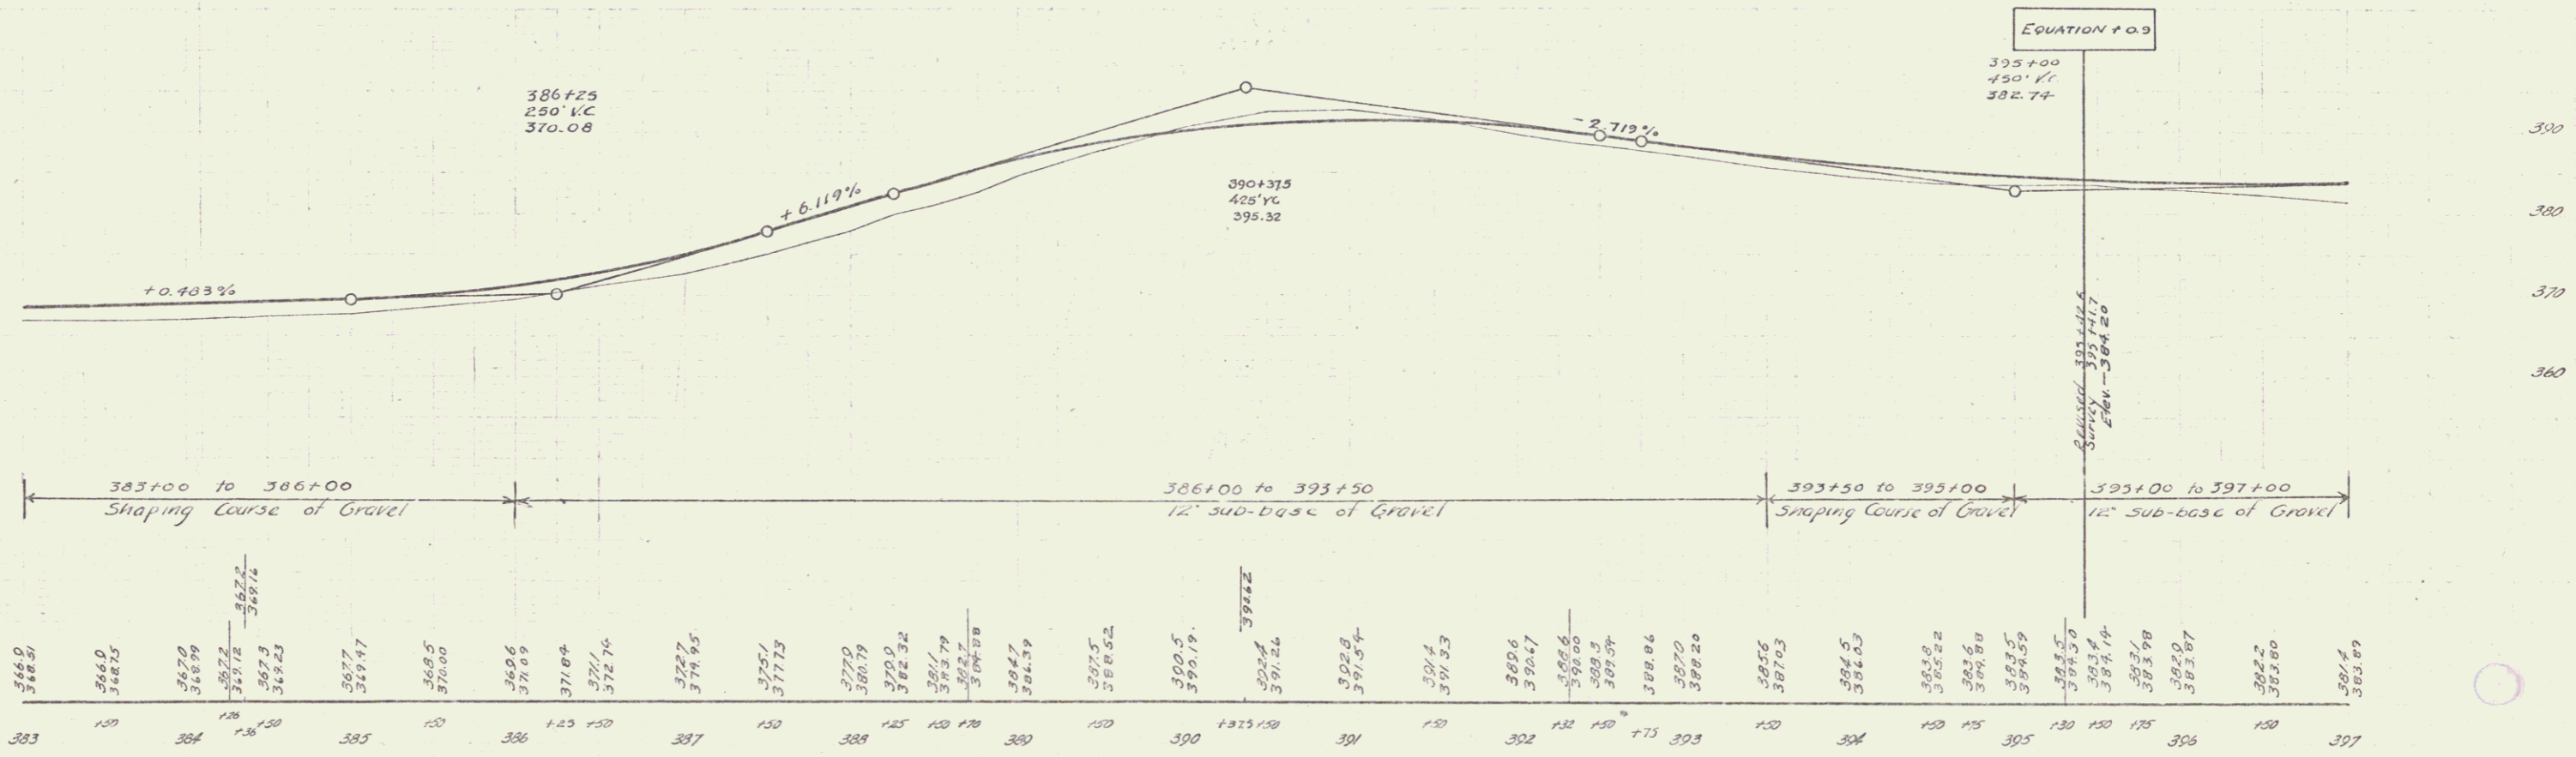

B.M. #40 Spike in root of a Pine 24' W of Sta 383+72 Elev 369.44  
 B.M. #41 Spike in root of a Pine 23' E of Sta 392+61 Elev 386.45