


PARCEL	KIND OF DATA OF INSTRUMENT	GRANTOR	GRANTEE	RECORDED THE PAGE	REMARKS
A.D.	G.C.P. 9-3-35	A.B. WILMOT	J.C. WILMOT	32 291-212	9-21-35

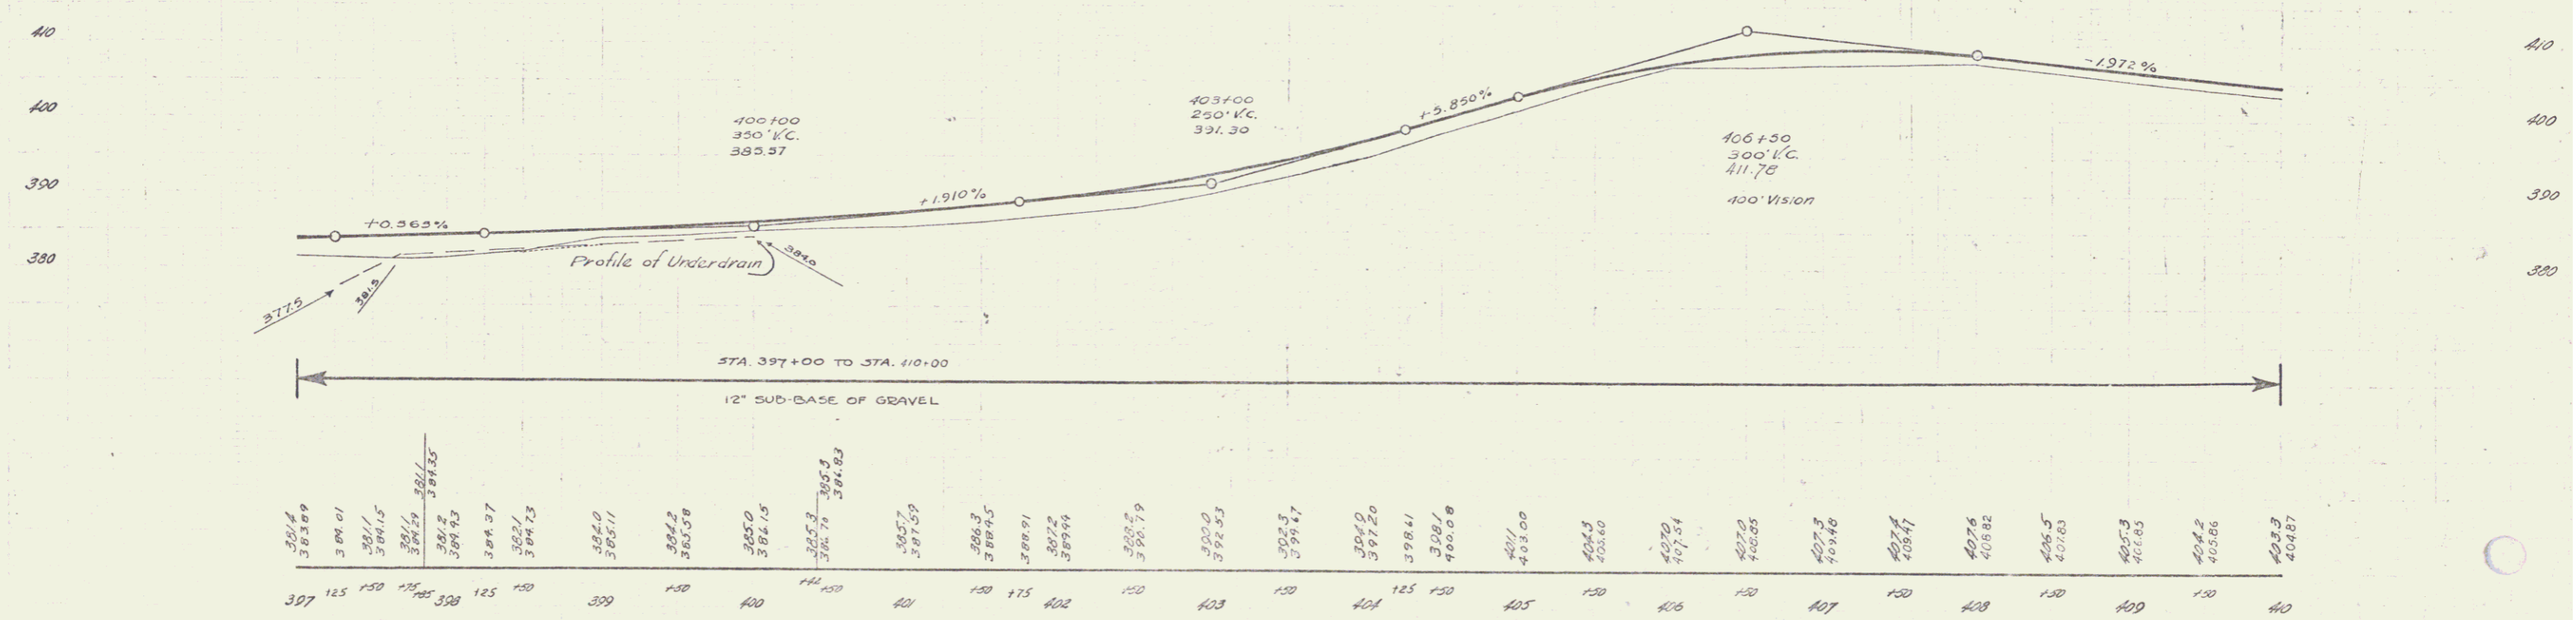

B.M. #42 Spike in roof of 12" Pine 23' E of Sta 407+30 Elev. 415.11

5