


PARCEL KIND OF DATE OF INSTRUMENT INSTRUMENT GRANTEE GENIUS RECORD NO. REMARKS  
 A-B O.C.D. 9-7-35 C.L. SARGENT STAFF: 32 281-283 9-2-35

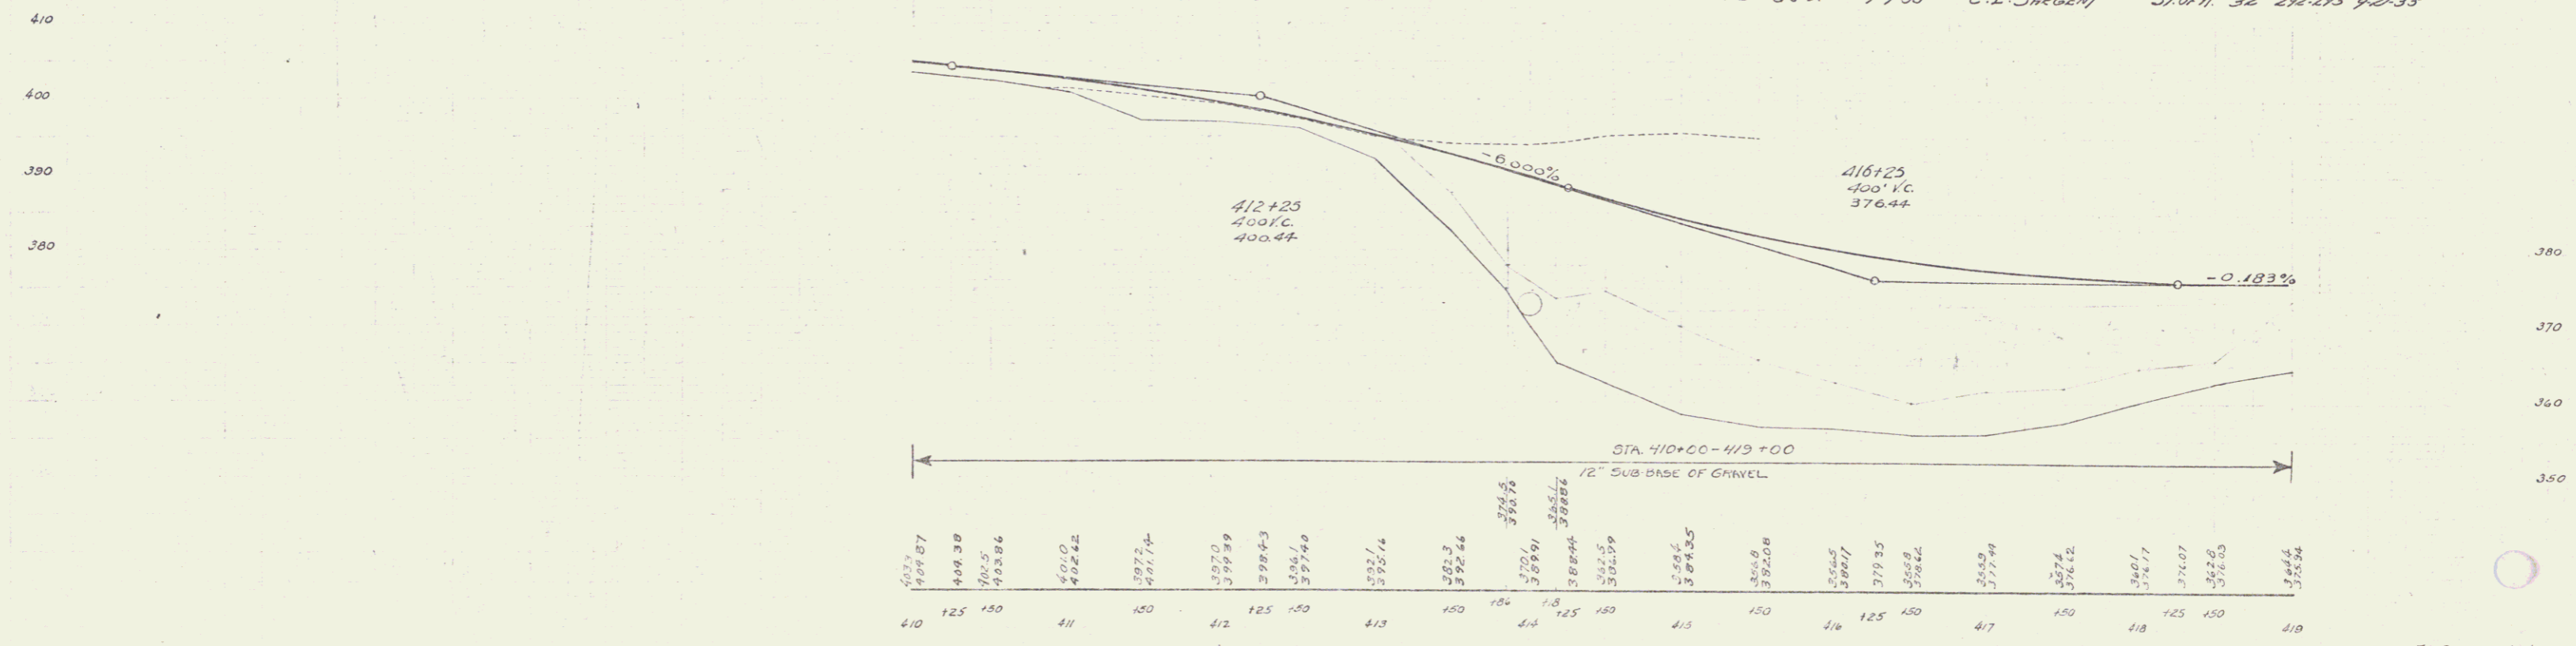

B.M. 43 SPIKE IN ROOT OF 18\"/>