

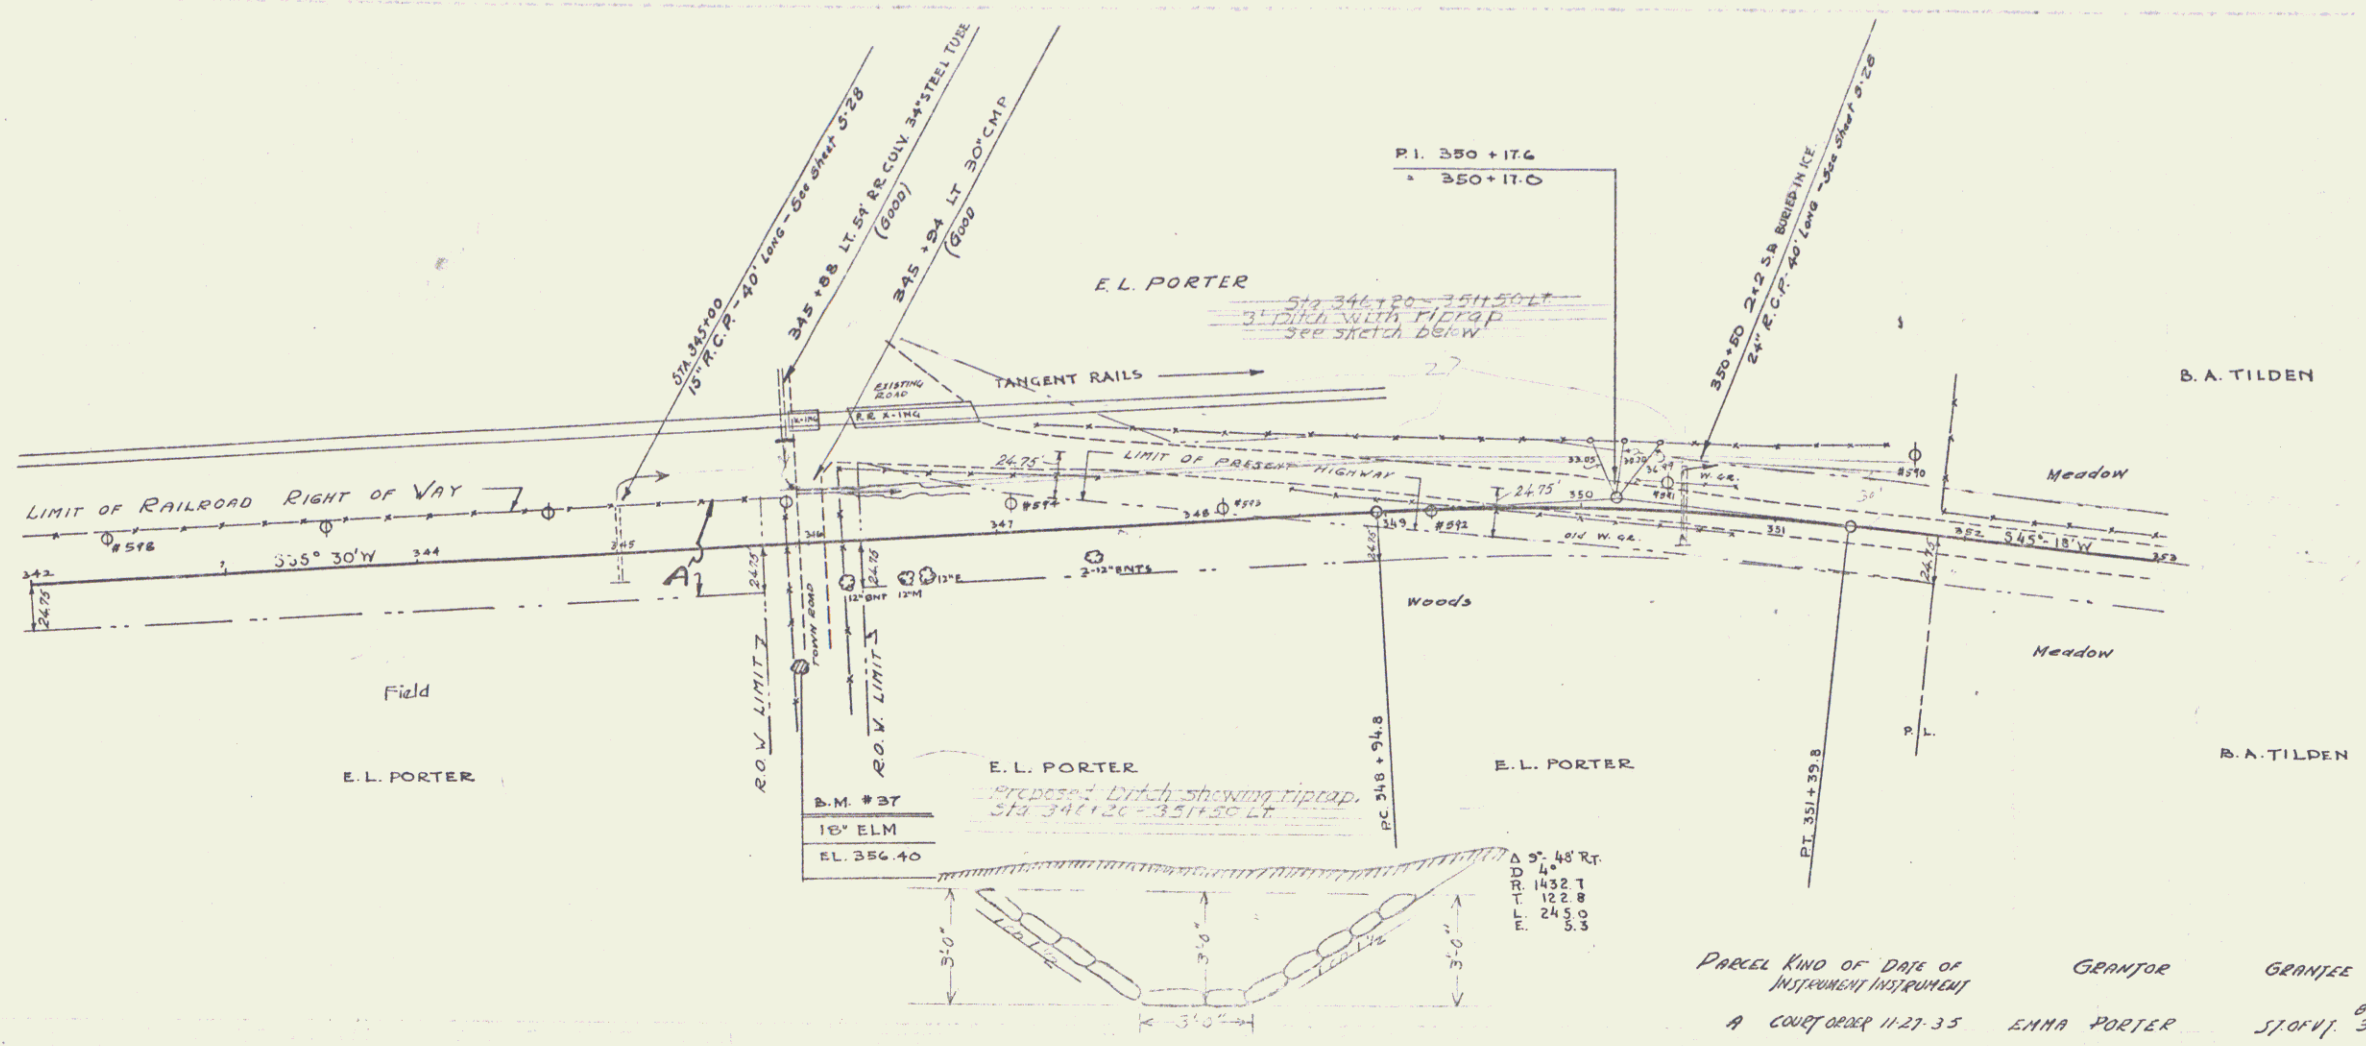


N.R.H.  
114E 1935 8 26  
(1935)

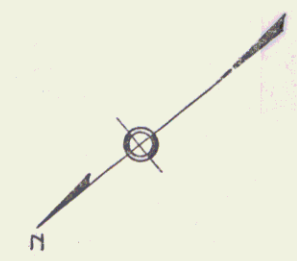

PARCEL KIND OF DATE OF GRANTEE GRANTEE RECORDED PLANNED INSTRUMENT INSTRUMENT  
A CORNER 1127-35 ENNA PORTER SJ1041 32 314-318 12-7-35

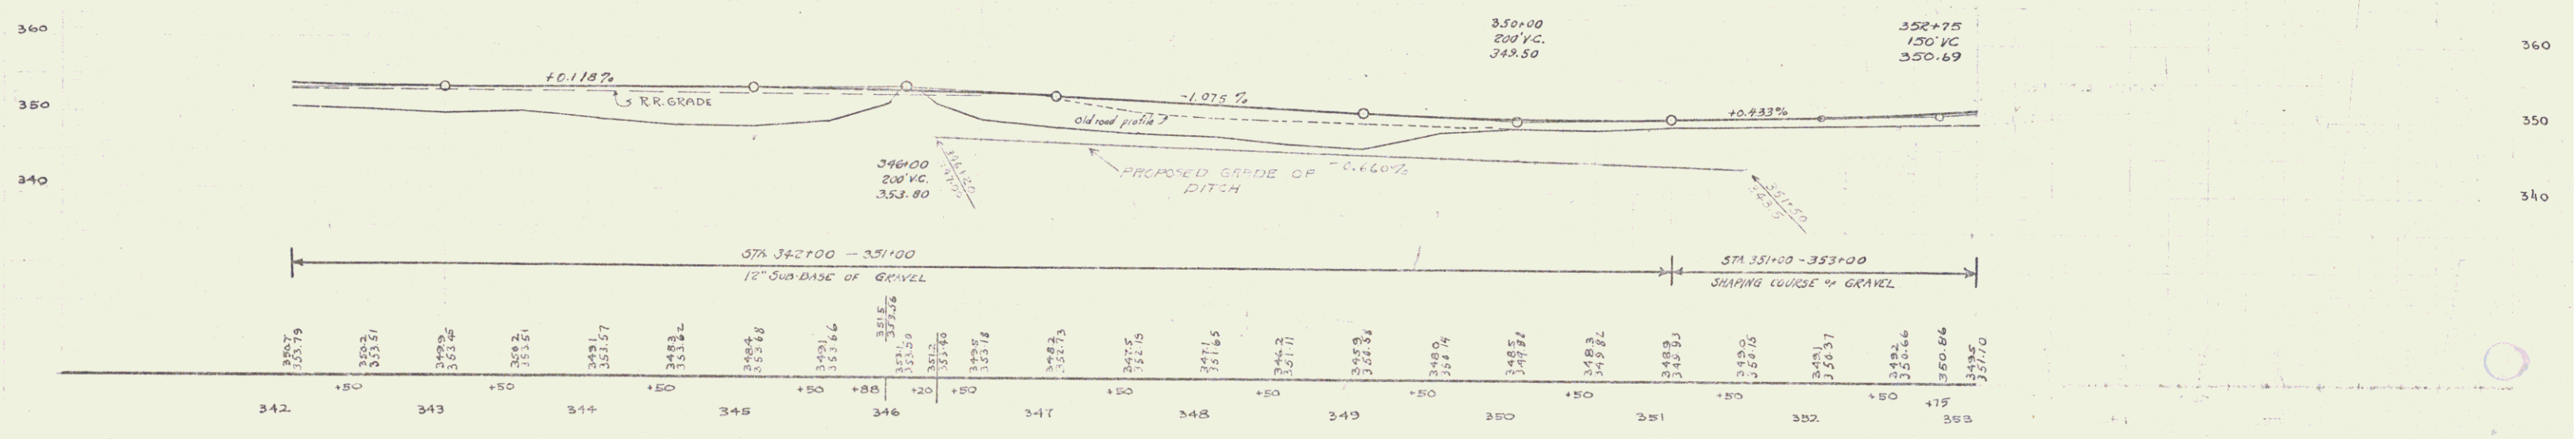

B.M. #37 SPIKE IN ROOT 18' ELM STA. 345+80 RT 66' EL. 356.40

SERIES N.R.H. 114E (1935)  
SHEET 8 OF 26

7