


REINFORCED CONCRETE PIPE CULVERTS

STATION	SIZE	LENG.	C.R.M.
141+00	15"	40'	1.87

CEMENT RUBBLE MASONRY RETAINING WALL


STA. TO STA.	LENG.	C.R.M.
139+75 - 141+03	228'	62.77

NRH			
7	VC	1140	1933
11	17	11	80

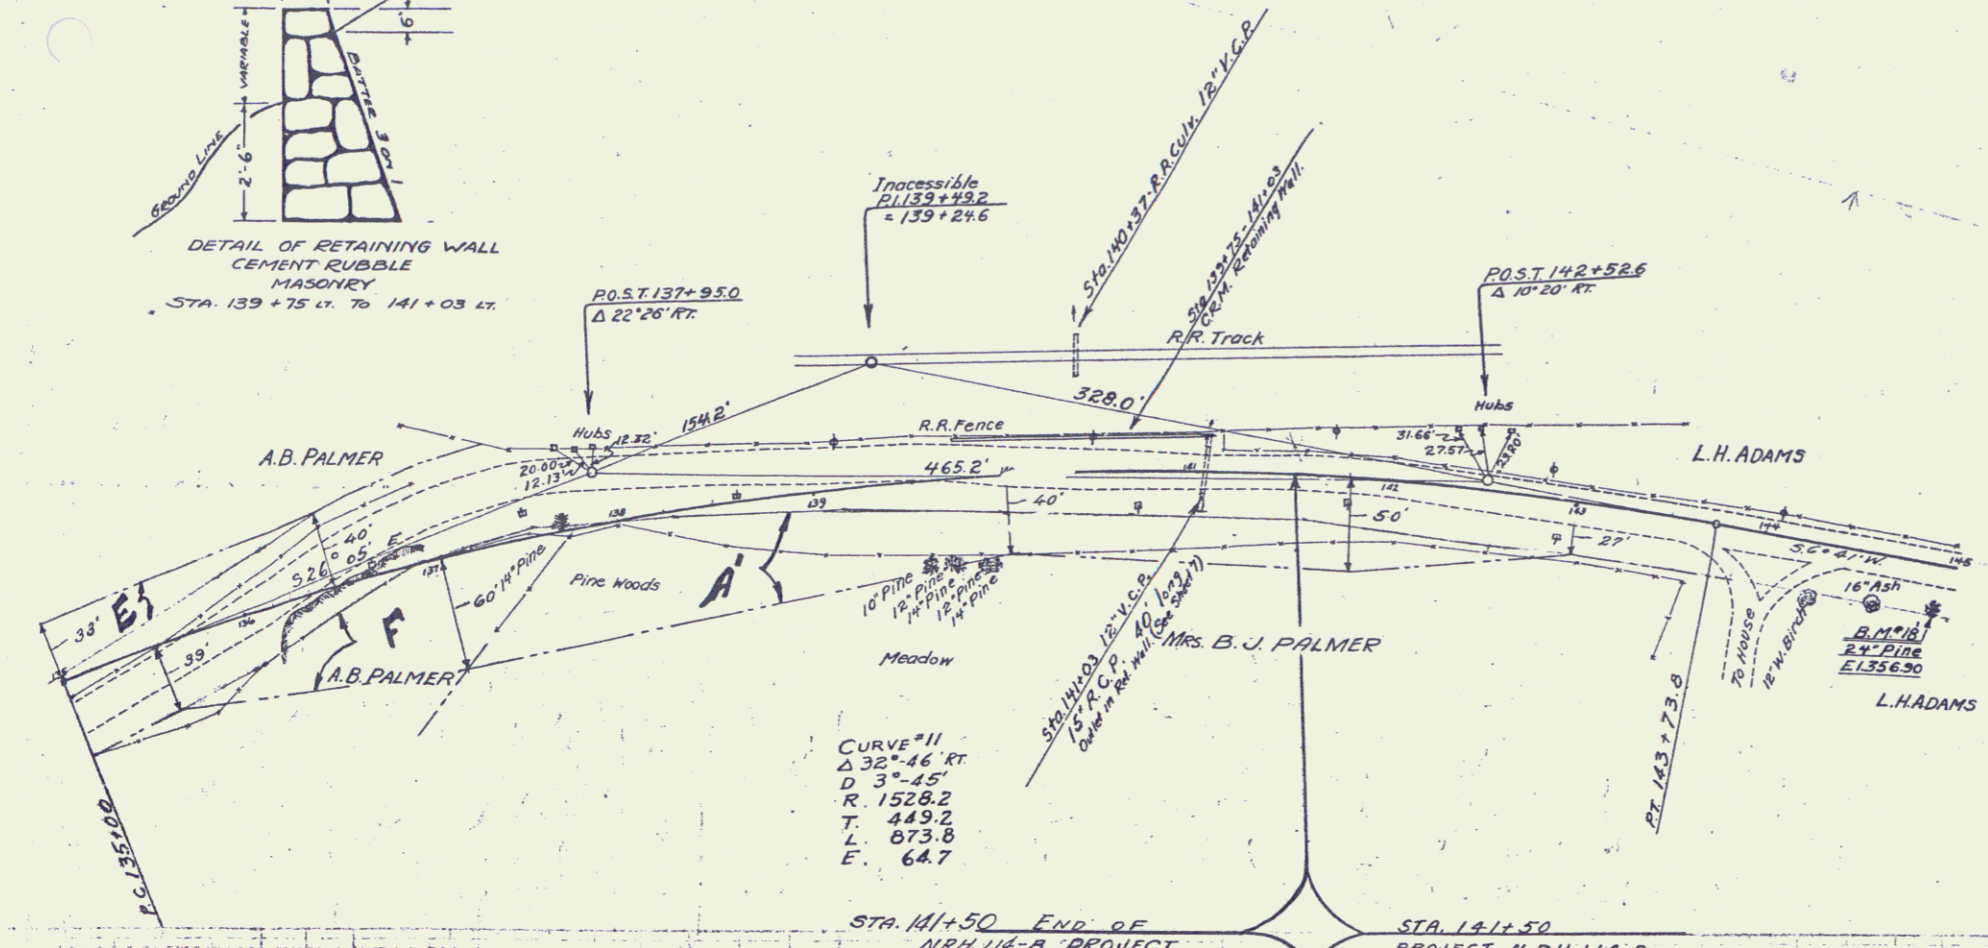

Parcel KIND OF DATE OF INSTRUMENT INSTRUMENT GRANTEE GRANTEE RECORDED THEFTORD REMARKS

Parcel	KIND OF INSTRUMENT	DATE OF INSTRUMENT	GRANTEE	GRANTEE	RECORDED	THEFTORD	REMARKS
A B C D E F	M.D.	11-30-32	A. B. & J. PALMER	A. B. & J. PALMER	32	100-101-102	12-3-32
G	M.D.	11-25-32	Mrs. B. J. PALMER	Mrs. B. J. PALMER	32	78	11-27-32

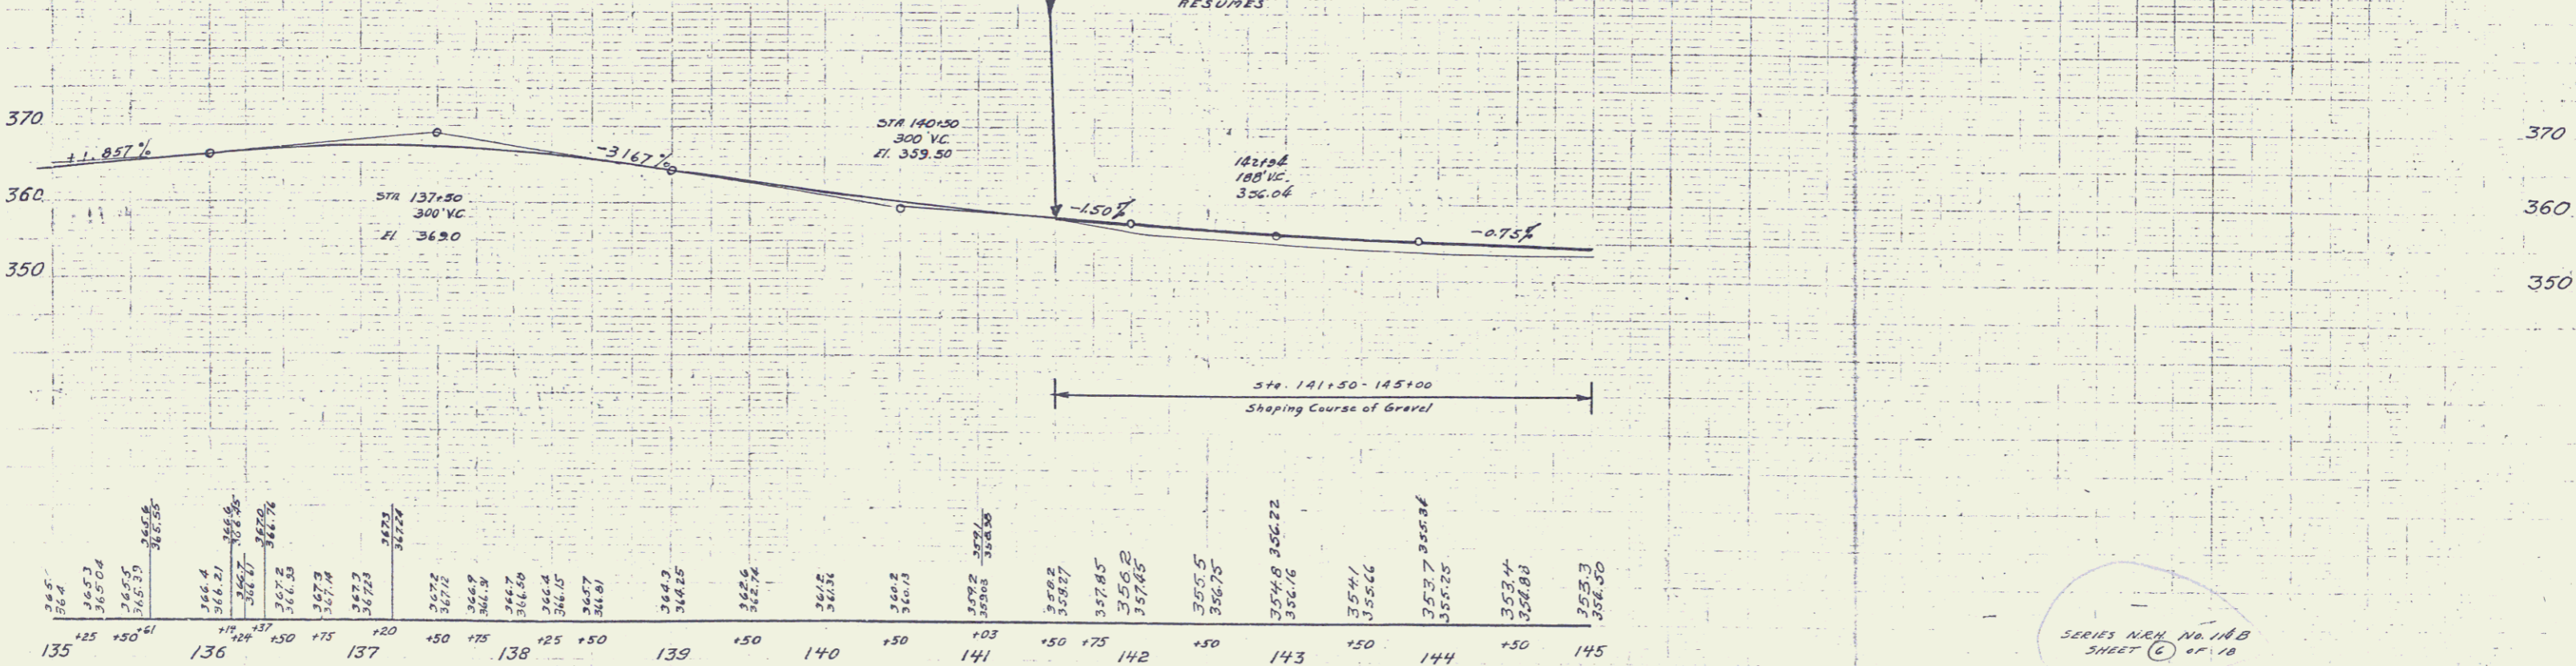

B.M. #18 Spike in Root 24' Pine 18.5' RT. STA. 144+92 E1 356.90

SERIES NRH No. 114-B
SHEET (C) OF 18
SERIES NRH No. 114-D
SHEET (I) OF 80

8