


F. Hayward
 Engineer - Quality Assurance

Wood
 Boundary

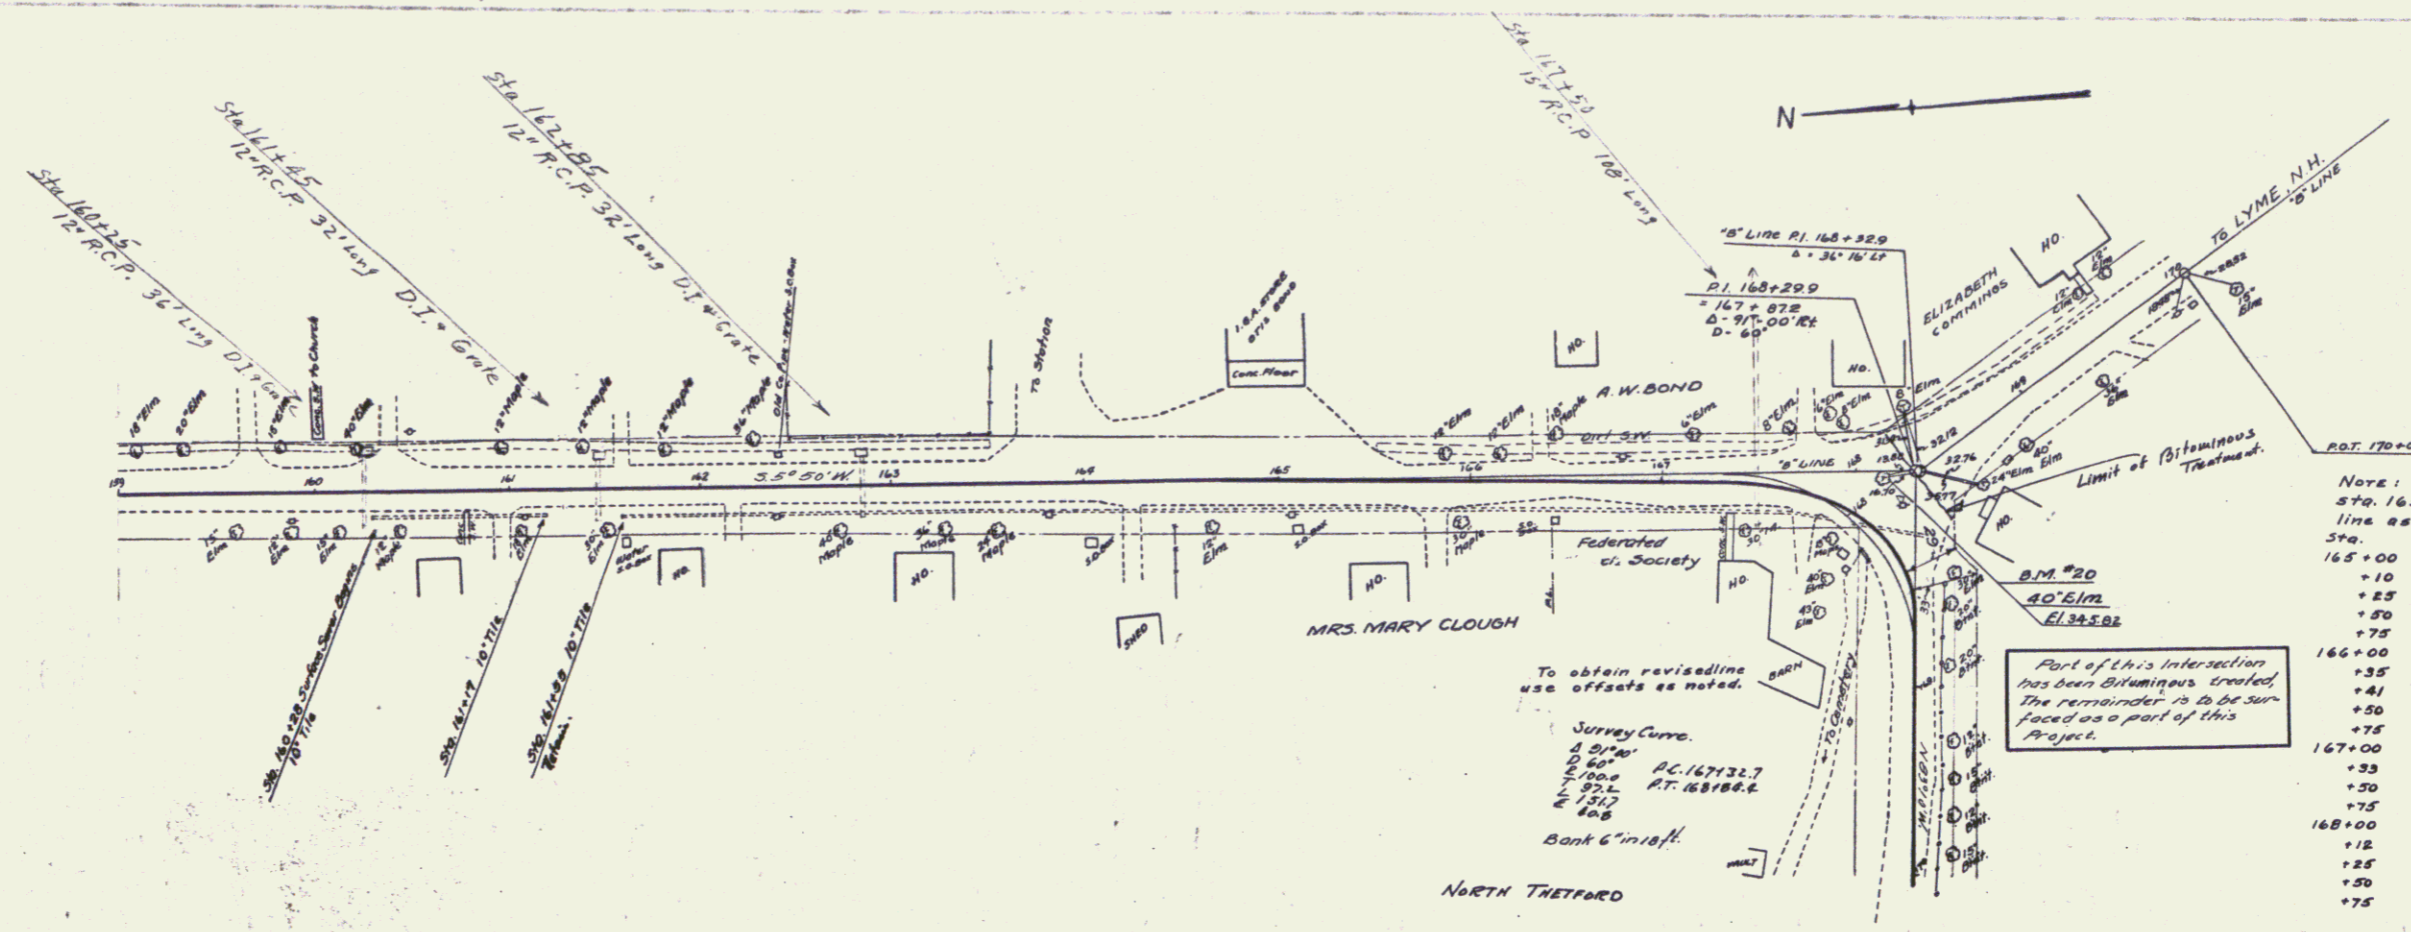

Note: Stationing for revised line at 165+00 - 169+00 see offsets from survey line as listed -

Sta.	Offset
165+00	0.5 Ra
+10	1.0 "
+25	1.0 "
+50	1.5 "
+75	1.5 "
166+00	2.0 "
+25	3.0 "
+41	3.0 "
+50	3.0 "
+75	3.5 "
167+00	4.5 "
+25	4.0 "
+50	3.5 "
+75	2.0 "
168+00	2.0 Lk
+12	3.5 "
+25	5.0 "
+50	4.5 "
+75	0.5 "

