
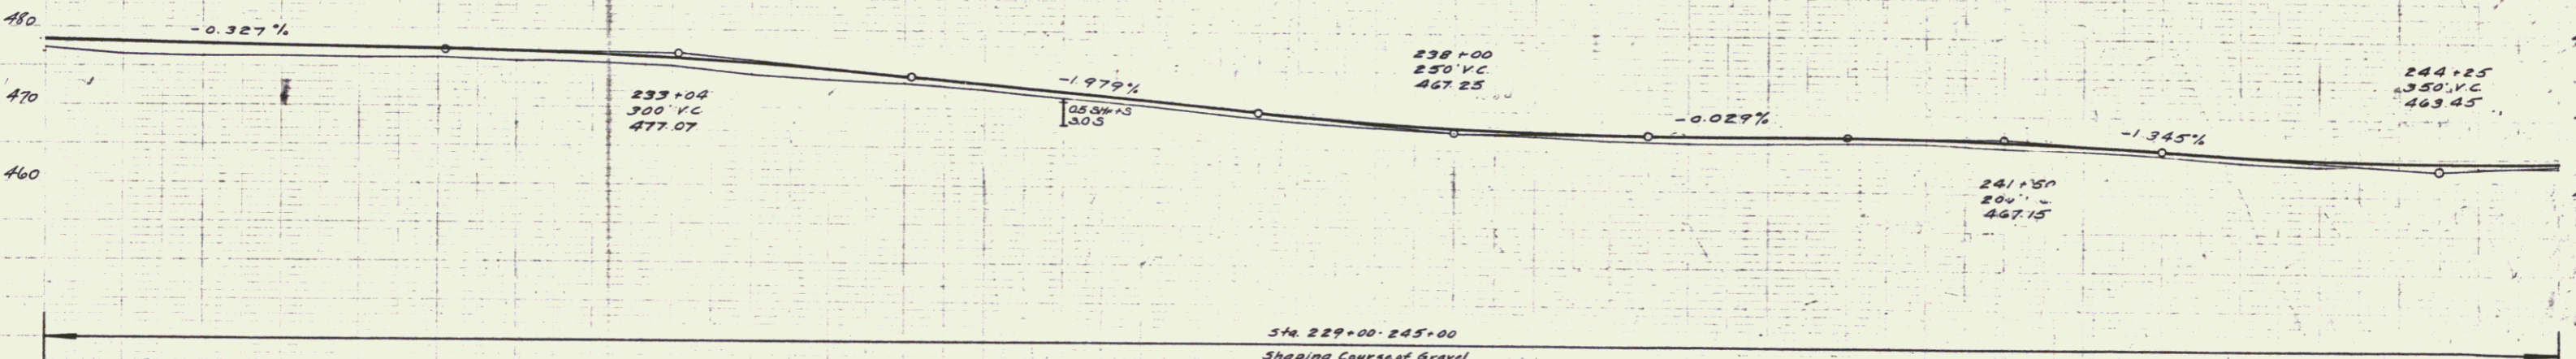


PLAN  
 WOOD  
 HUGHES  
 TRACINGS - BACKLAYS

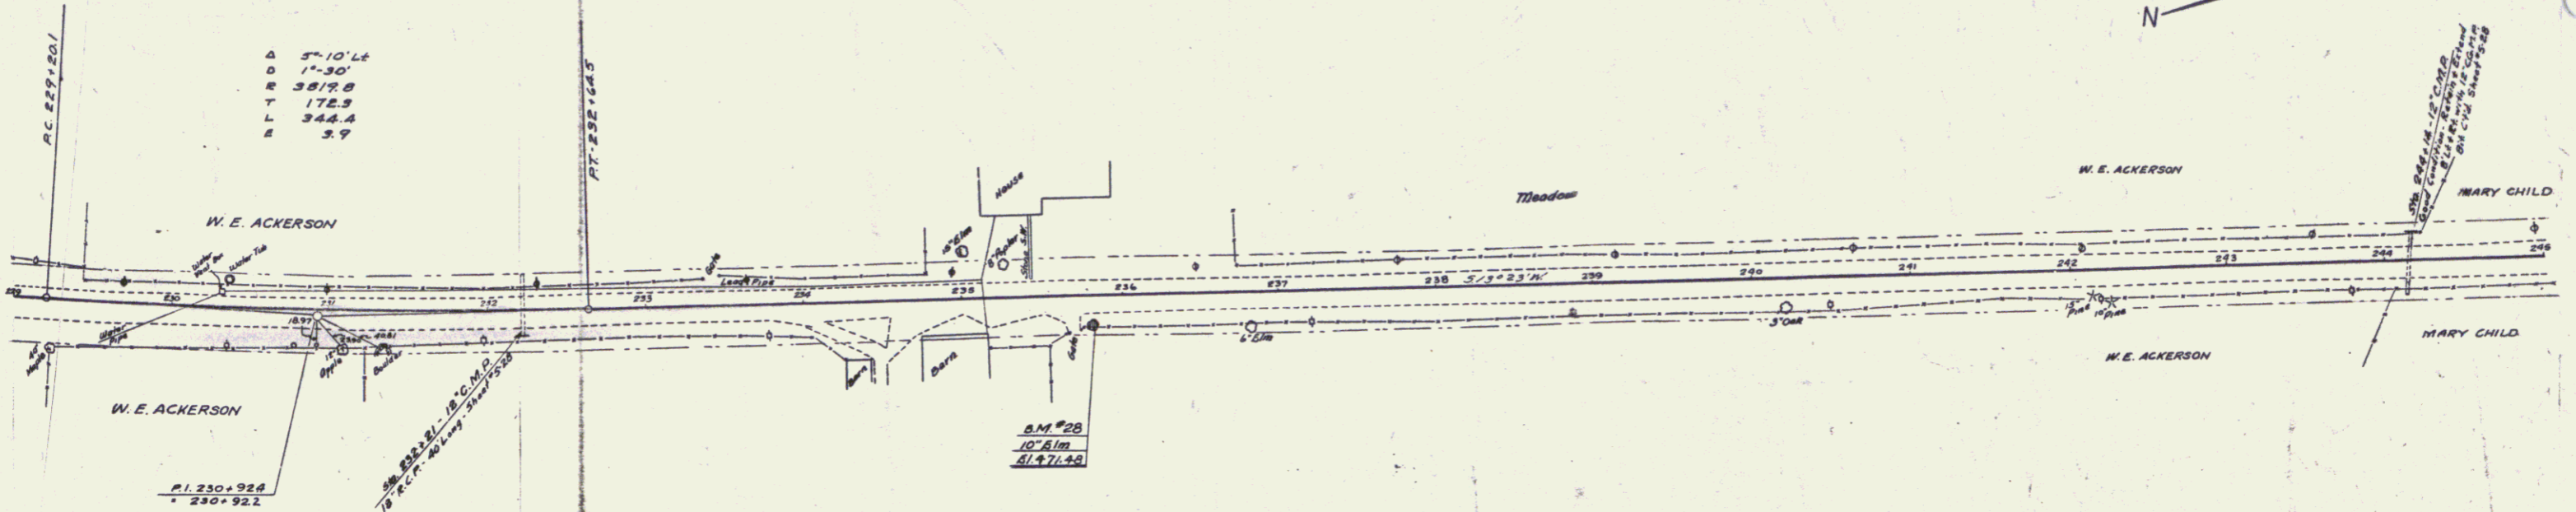

Sta. 229+00 - 245+00  
 Shaping Course of Gravel

229	230	231	232	233	234	235	236	237	238	239	240	241	242	243	244	245	246																
477.06 478.30	476.6 478.23	476.3 478.06	476.3 477.00	476.2 477.14	476.2 477.57	475.9 477.35	475.8 477.00	475.3 476.49	475.3 475.86	475.7 475.09	475.2 474.18	472.9 473.19	471.9 472.80	470.5 471.21	469.5 470.22	469.72 468.6	468.25 467.9	467.3 467.06	466.0 467.46	464.4 467.24	467.21 466.3	465.2 467.21	464.2 467.19	464.3 467.10	464.3 467.00	460.9 466.82	465.7 466.40	465.0 466.81	464.3 465.22	463.9 464.82	464.0 464.41	462.56 463.57	463.9 464.71

B.M. #28 Spike in Root of 14' Elm 18ft. W. Sta. 235+70 Elev. 471.68