


Barrett
Palmer
No. 31
Dec 29

Barrett
Palmer
No. 31
Dec 29


REINFORCED CONCRETE PIPE CULVERTS

STATION	SIZE	LENG.	Q. AM.
128+53	18"	52'	35.7
132+50	24"	68'	54.7
134+75	15"	66'	27.7

N 1/4
114 193 5 18

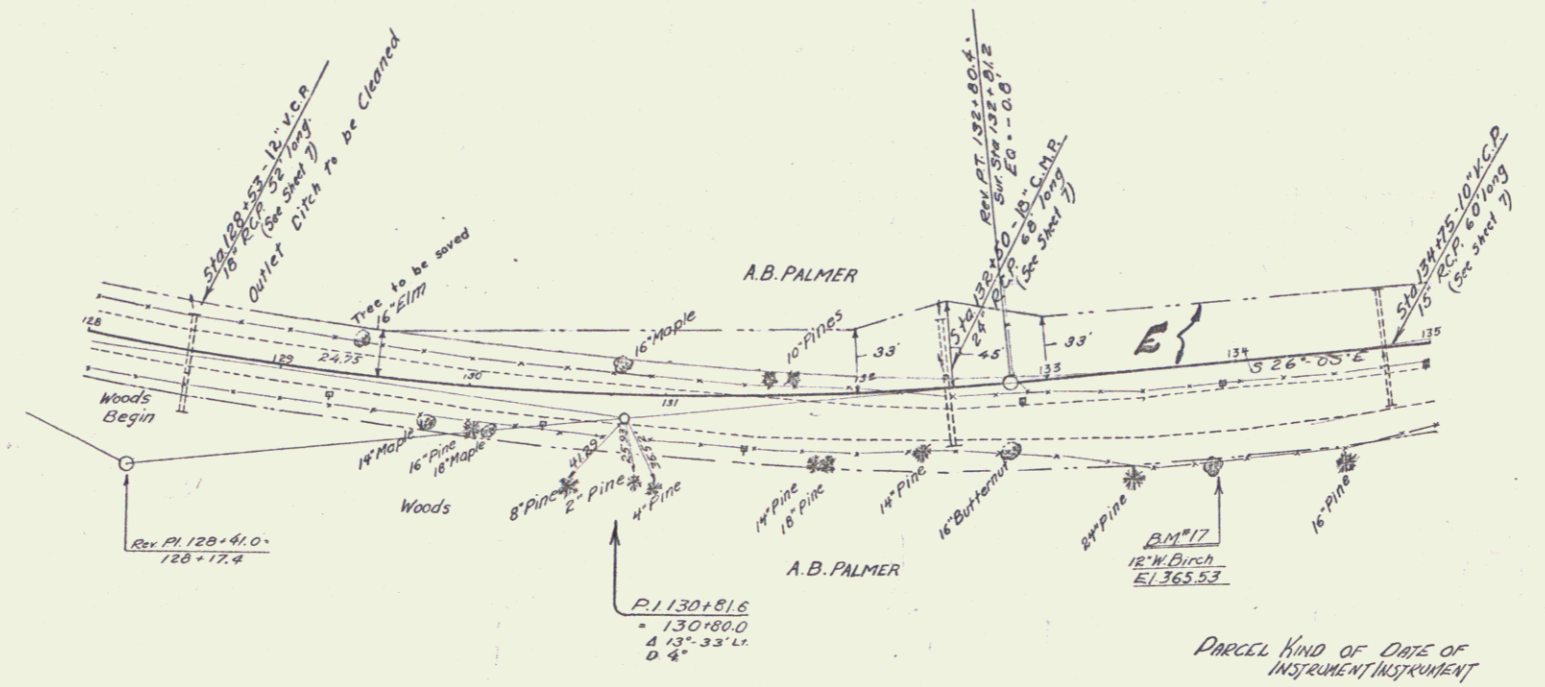

PARCEL KIND OF DATE OF GRANTOR GRANTEE RECORDED REMARKS
 AC-DEF H.D. 11.30.32 A.B. & B.J. PALMER GRANTEE JAMES FORD
 804 1246.5 DME 32 100 101 102 2-332

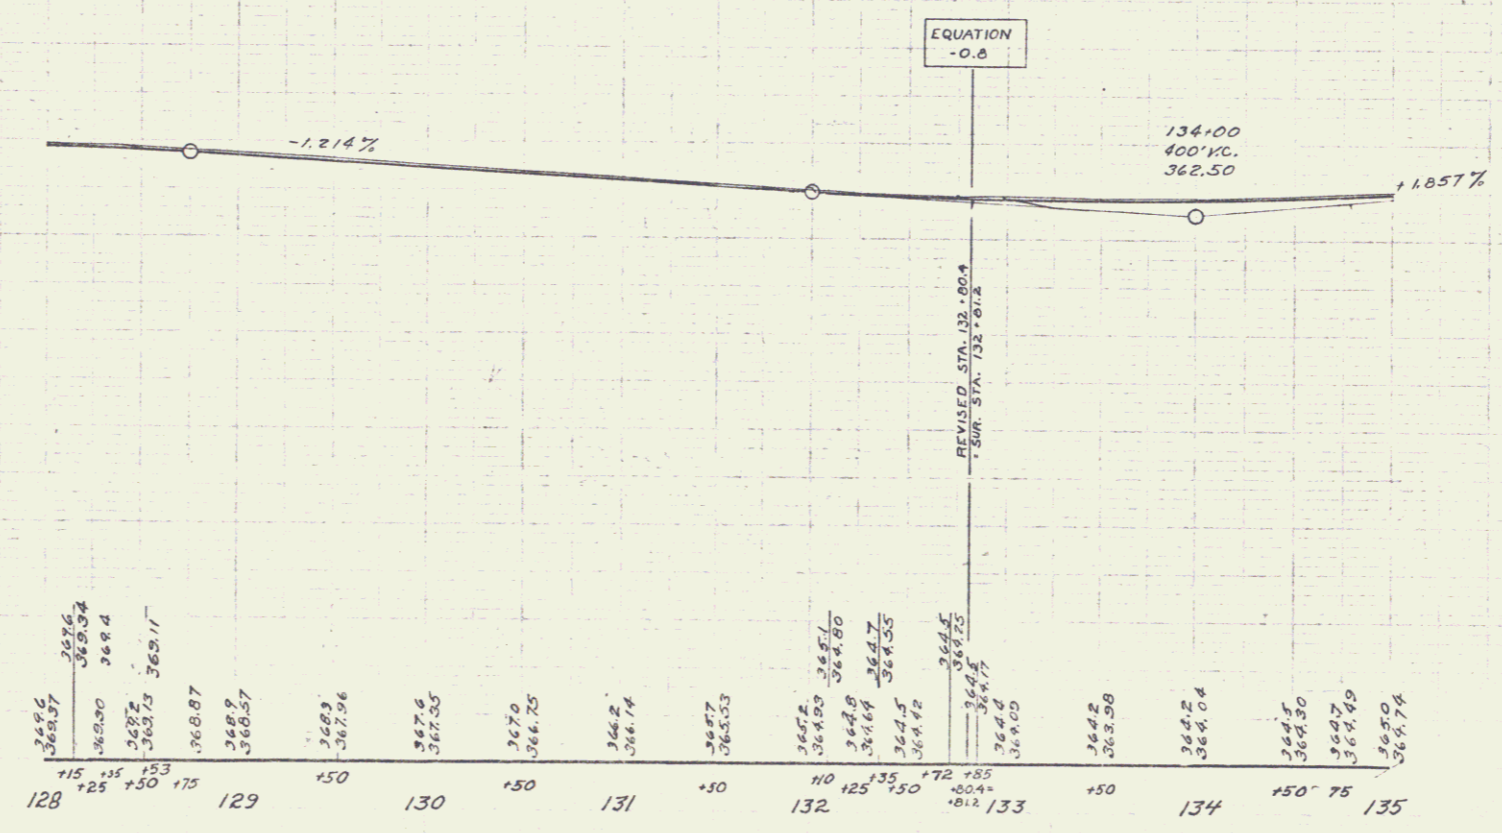

B.M. #17 Spike in 12" W. Birch 50' RT STA. 133+82 E1.365.53

SERIES No. 114 B
SHEET 5 OF 18

3