

PLAN
 DATE: 1/14/11
 DRAWN BY: J. Kelly
 CHECKED BY: J. Kelly
 NO. 101

SECTION
 DATE: 1/14/11
 DRAWN BY: J. Kelly
 CHECKED BY: J. Kelly
 NO. 101

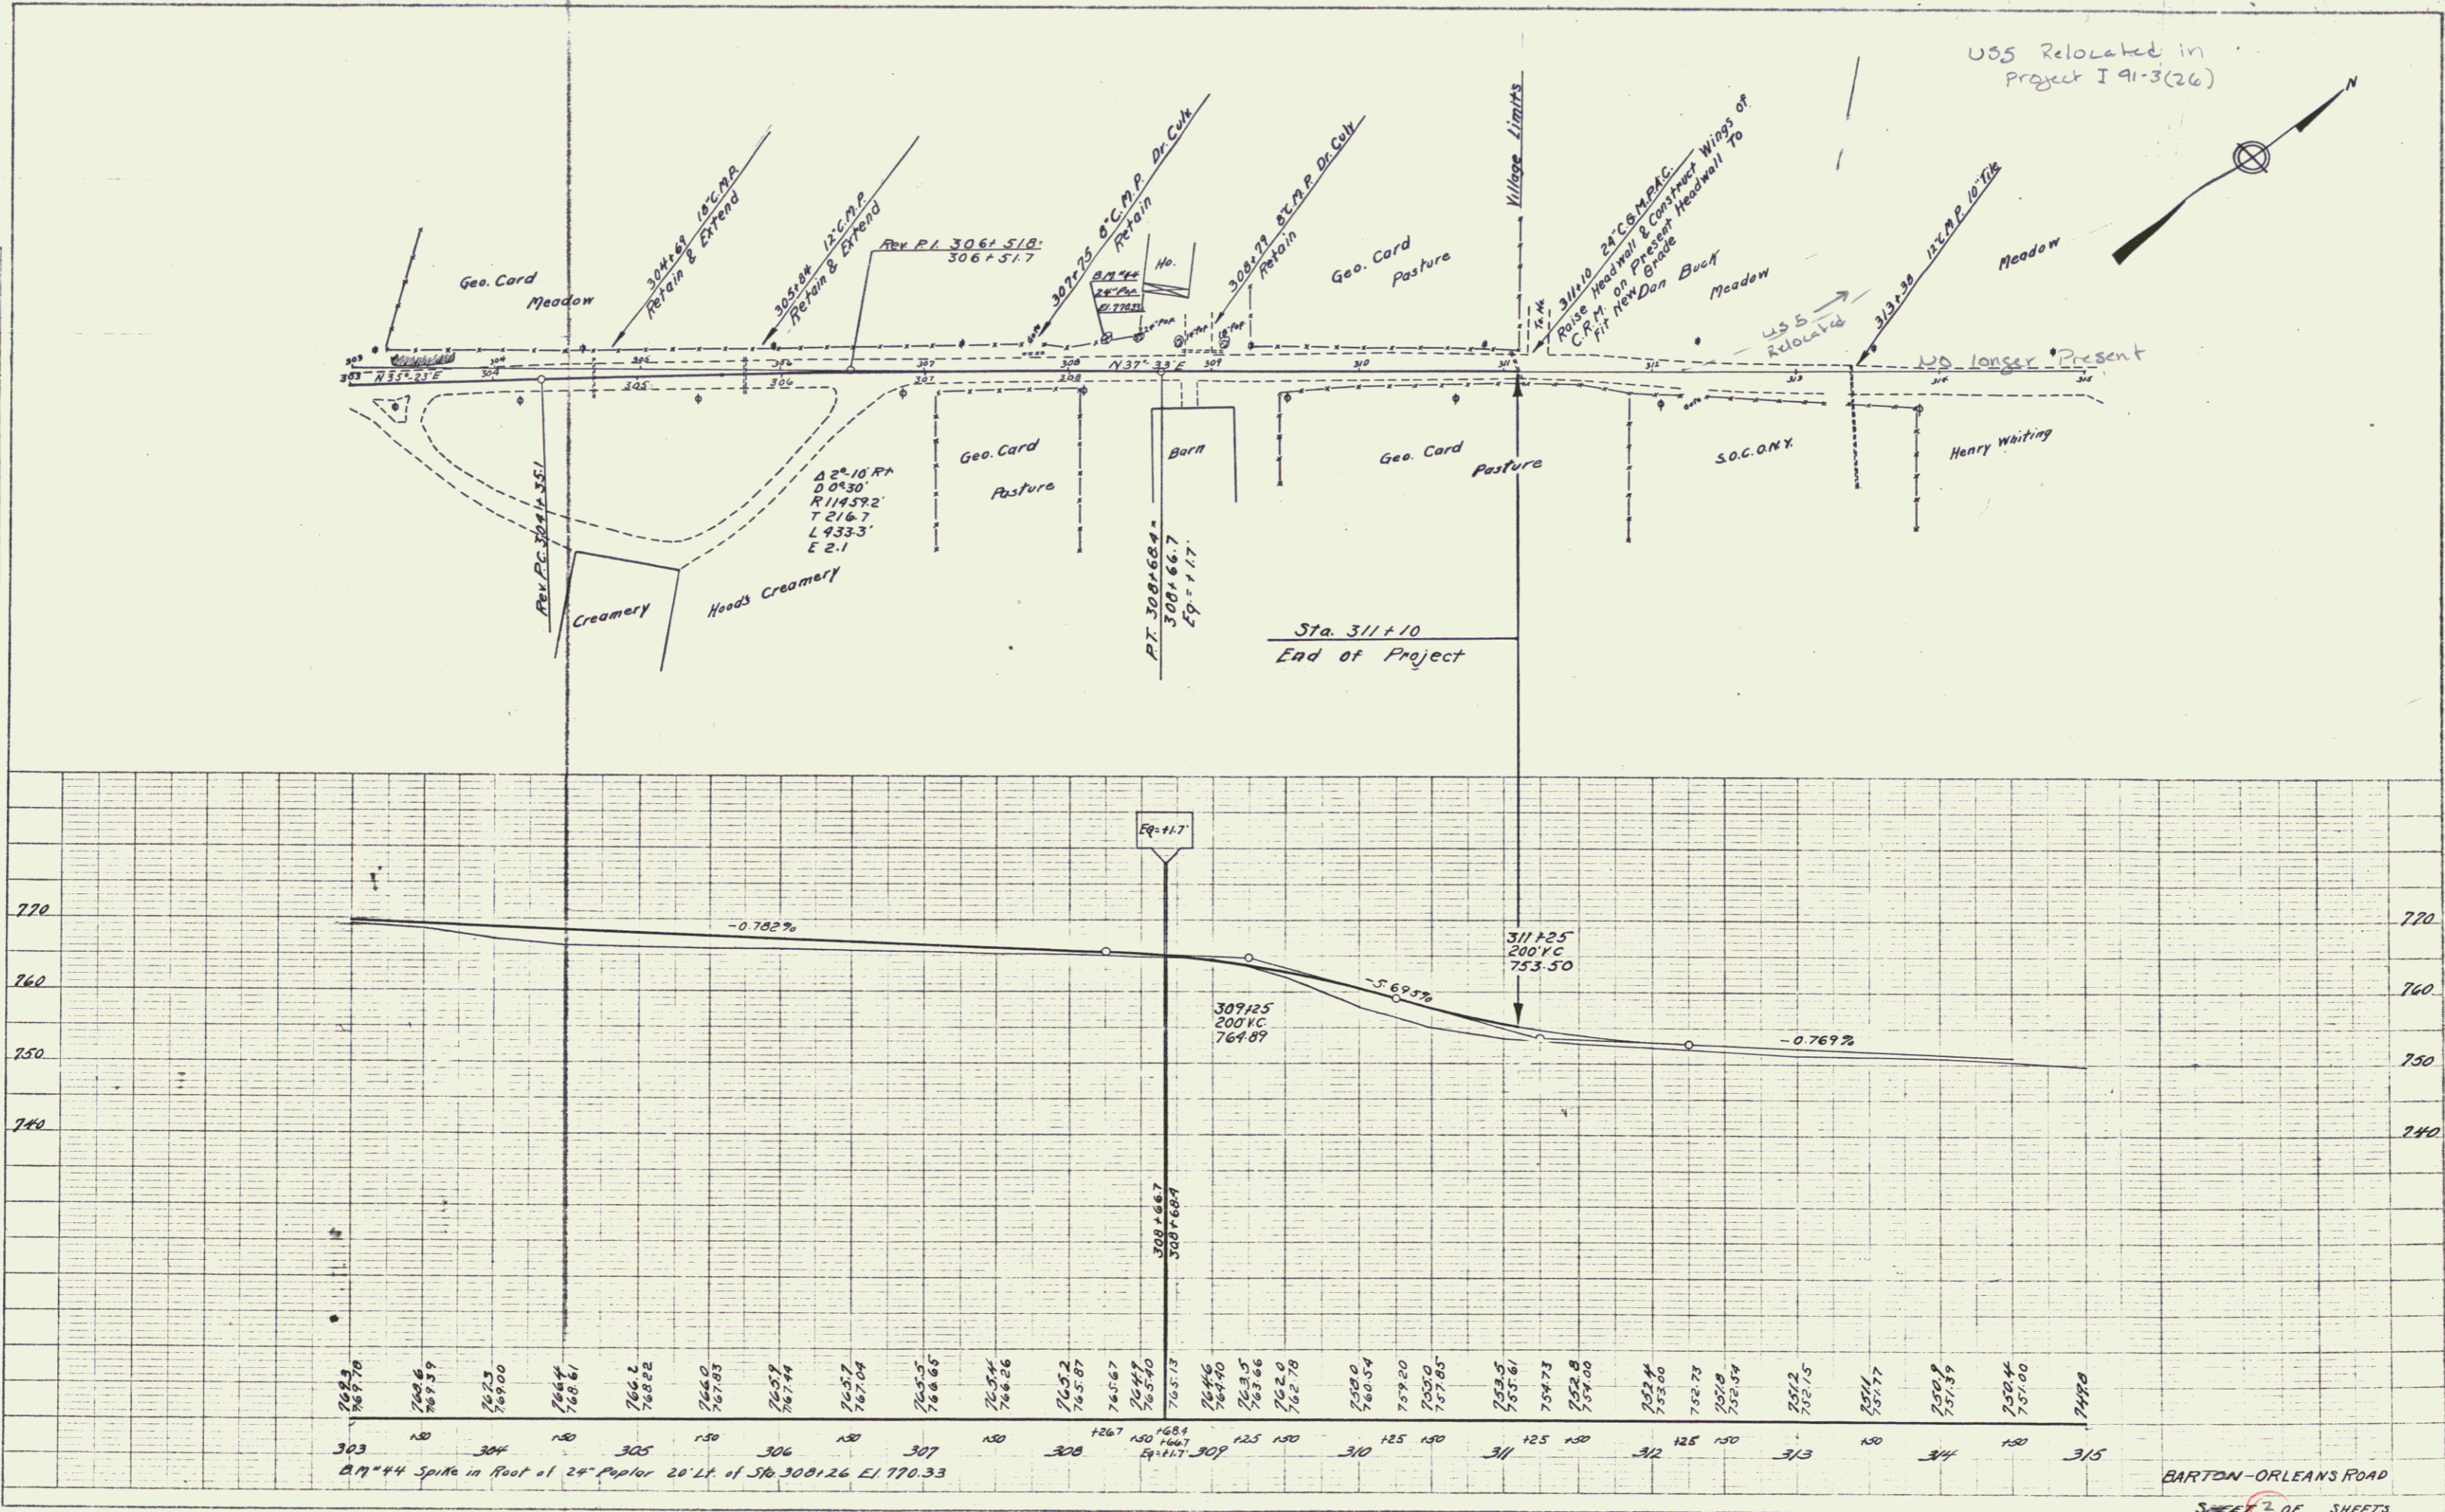


PLATE 1 - PLAN AND PROFILE OF ROAD STANDARD

BARTON-ORLEANS ROAD
 SHEET 2 OF SHEETS

2